

ABERFOYLE TIN N.L.


LONGITUDINAL SECTION

SCALE 1" = 30'

Mine Manager 30-6-20

Note: Plotted on Vein Slope

R.L. Collar Main Shaft 00'
 " N° 4 Level 387'
 " " 5 " 507'
 " " 6 " 627'

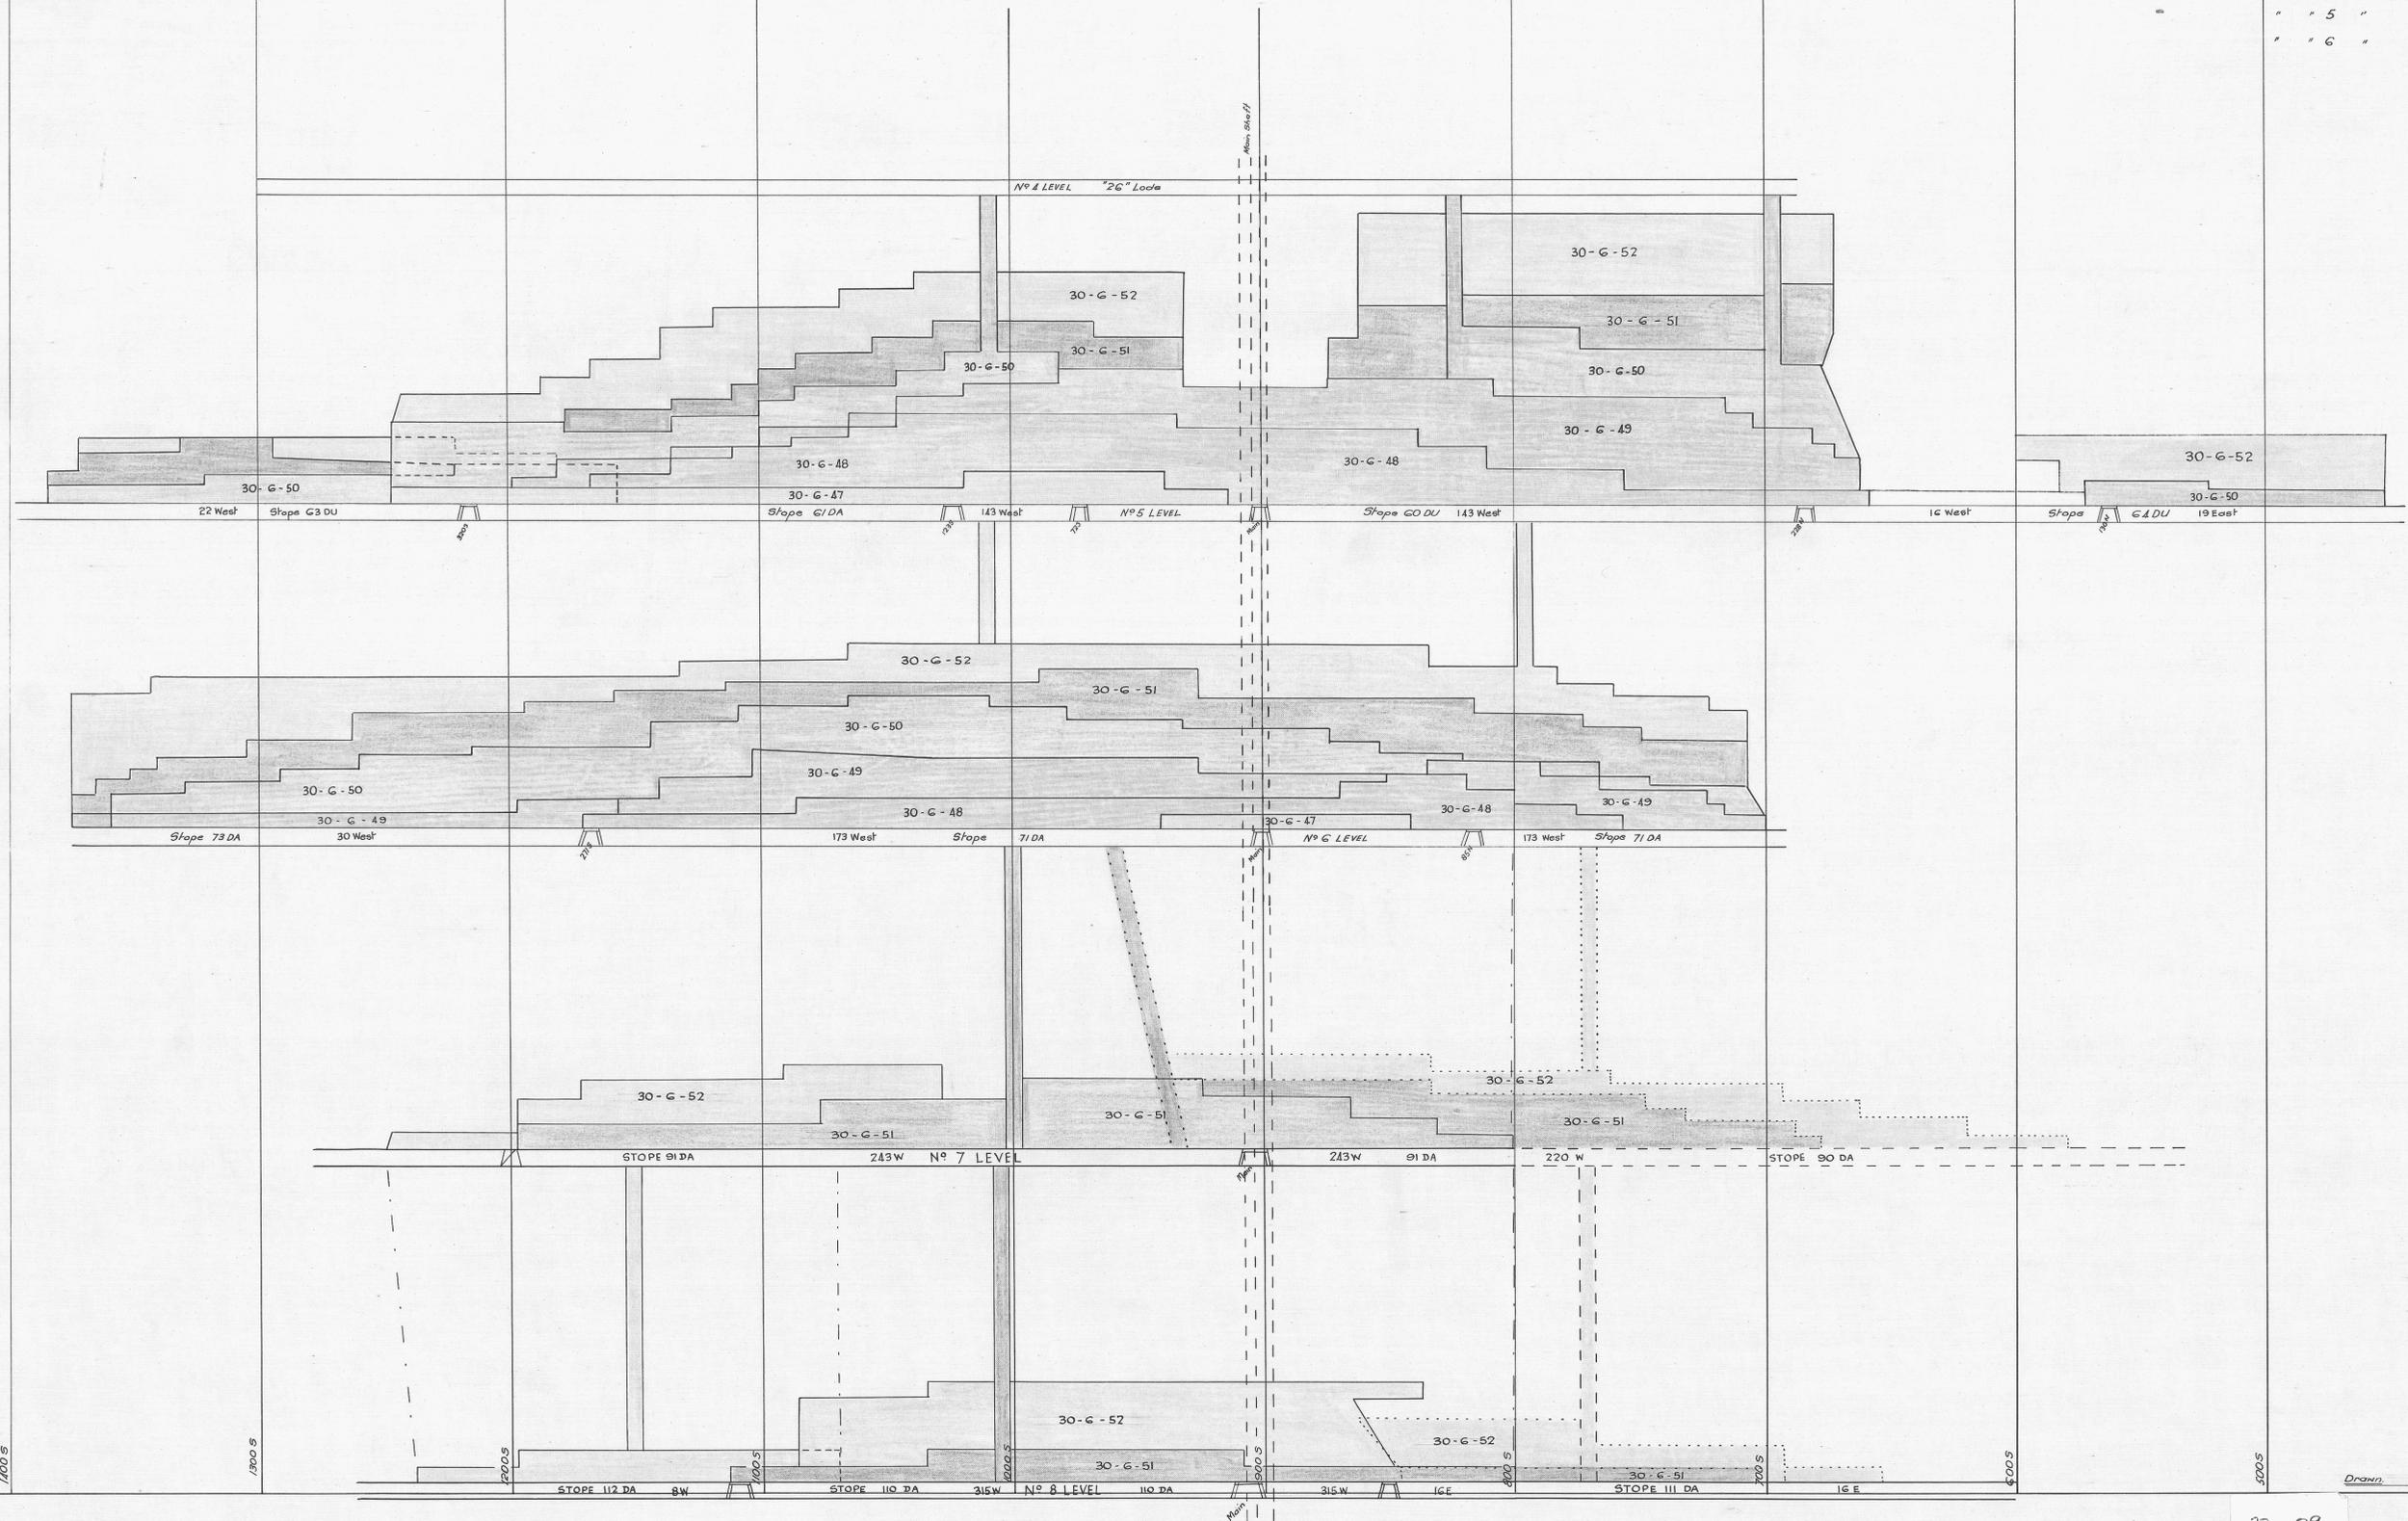

Drawn D. Lally 30-6-1950