


ABERFOYLE TIN N.L.

LONGITUDINAL SECTION

SCALE :- 1" = 30'

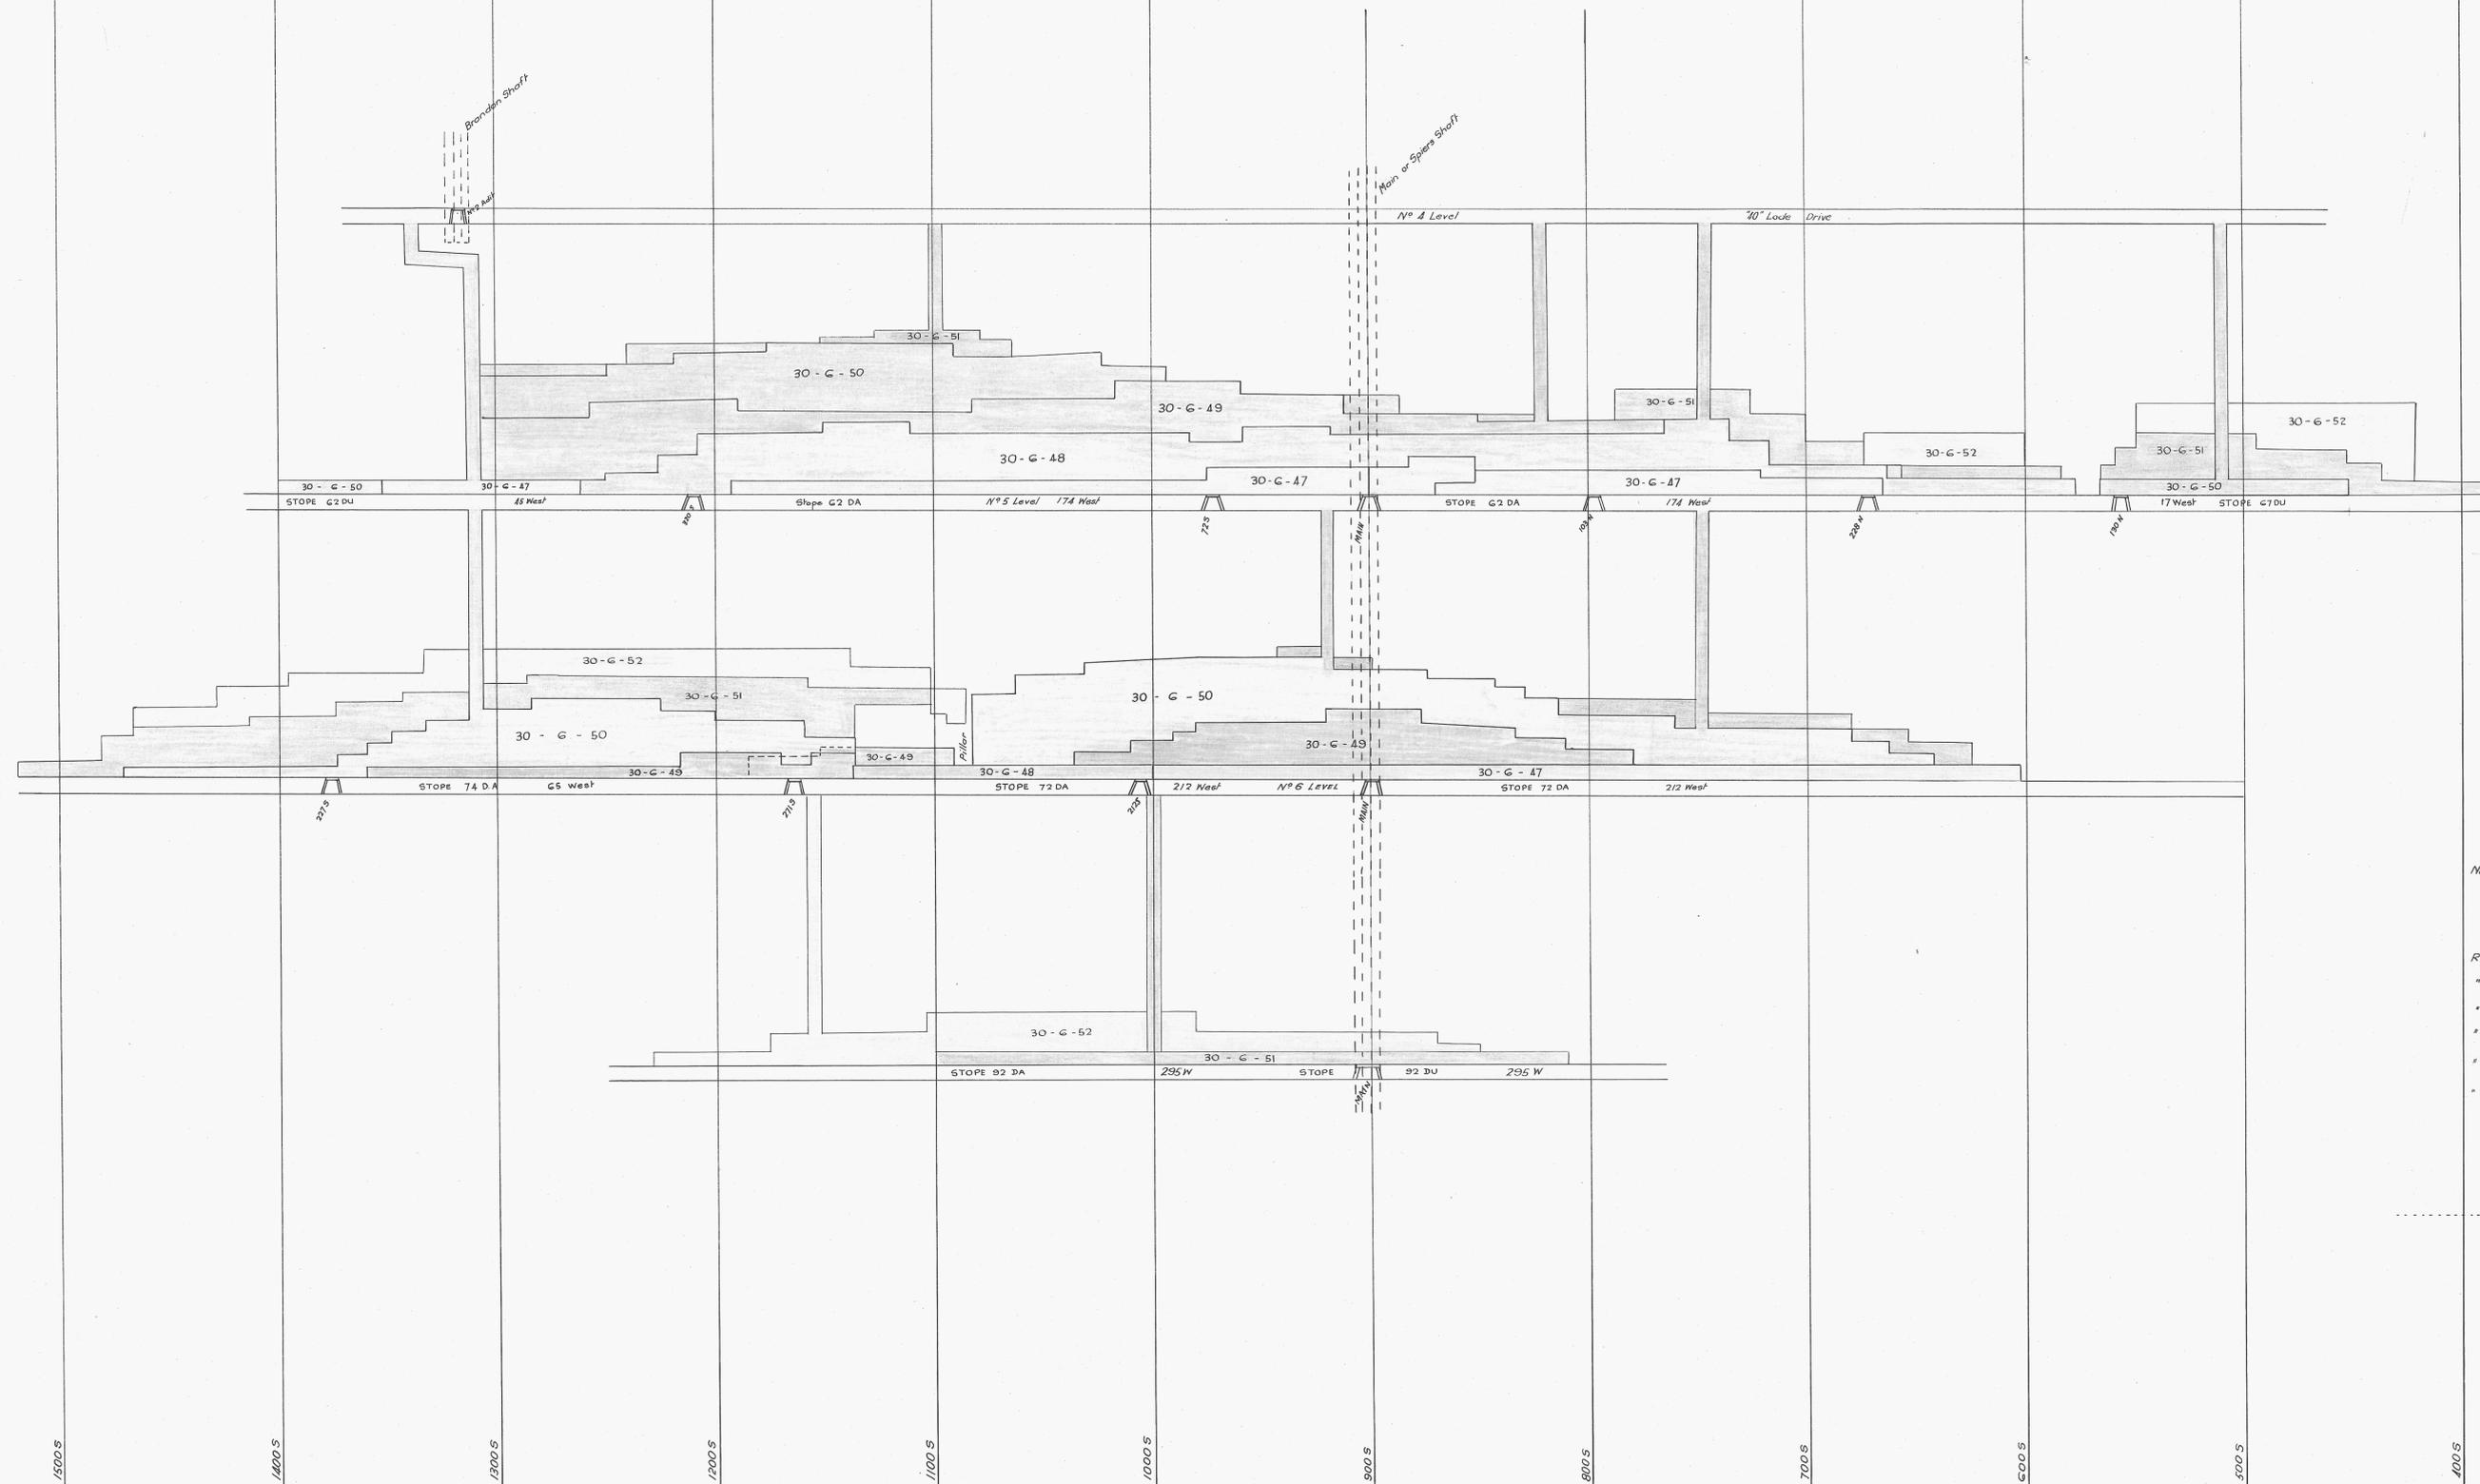

Note: Plotted on slope

R.L. Collar Main Shaft	00'
" No 4 Level	387'
" " 5 "	507'
" " 6 "	627'
" " 7 "	747'
" " 8 "	867'

Mine Manager 30-6-30

Drawn D. Leith 1940