

23-14


ABERFOYLE TIN N. L.

LONGITUDINAL SECTION 26 VEIN

SCALE 1" = 30'

Re-drawn by D. Lello 30-6-1920

Mine Manager 30/6/20

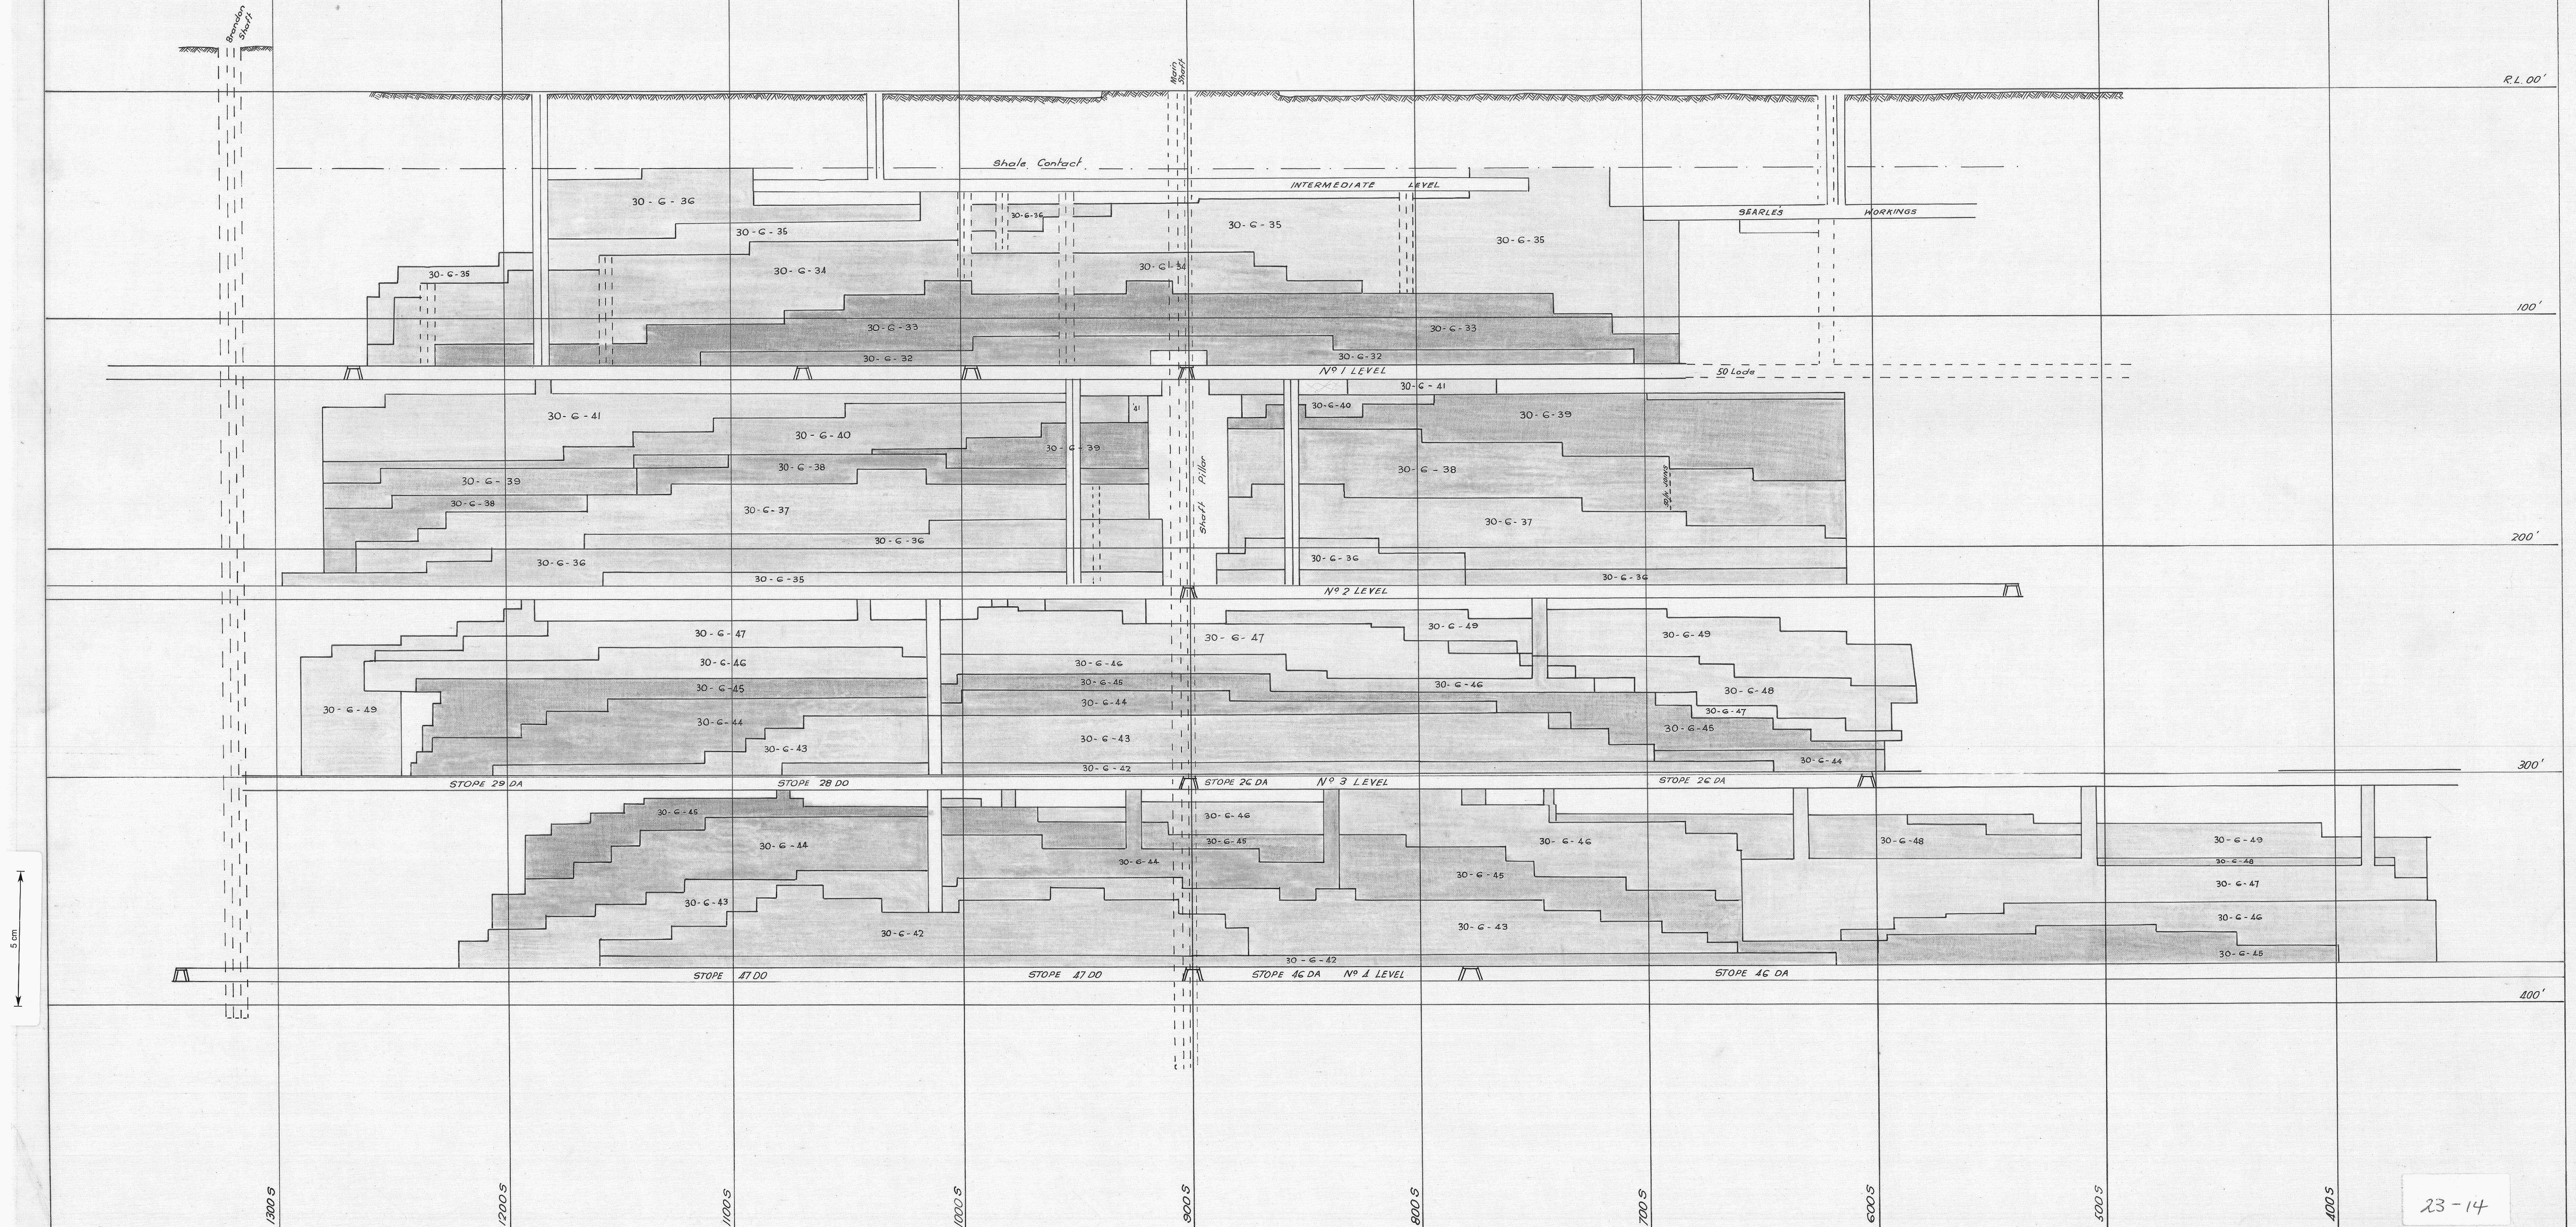

23-14