


# ABERFOYLE TIN N. L.

## LONGITUDINAL SECTION

SCALE 1" = 30'

Re-drawn by D.Lello 30-6-1950

Mine Manager 30/6/50

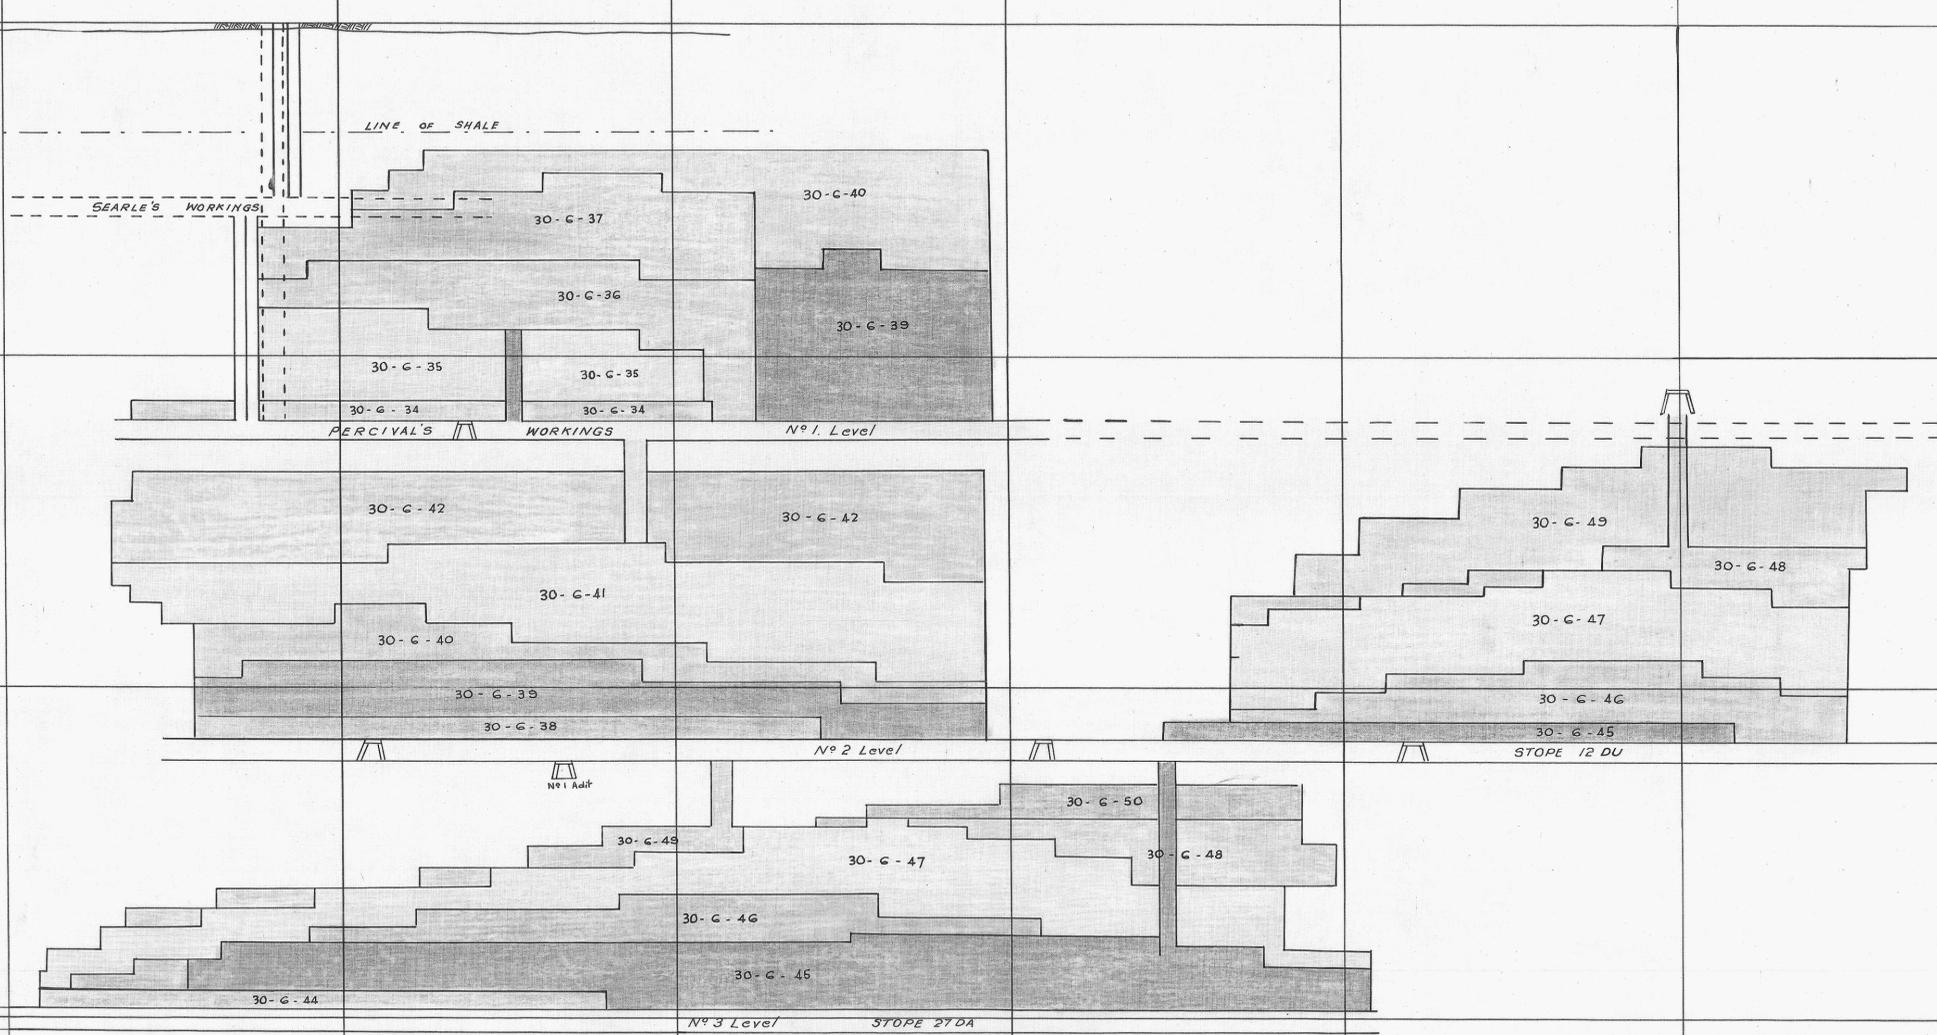

23-16

5 cm

700 6

600 5

500 5

400 5

300 5

200 5

23-16