


1-2

0023-028



- ▣ Rise to level above
- Rise from level below

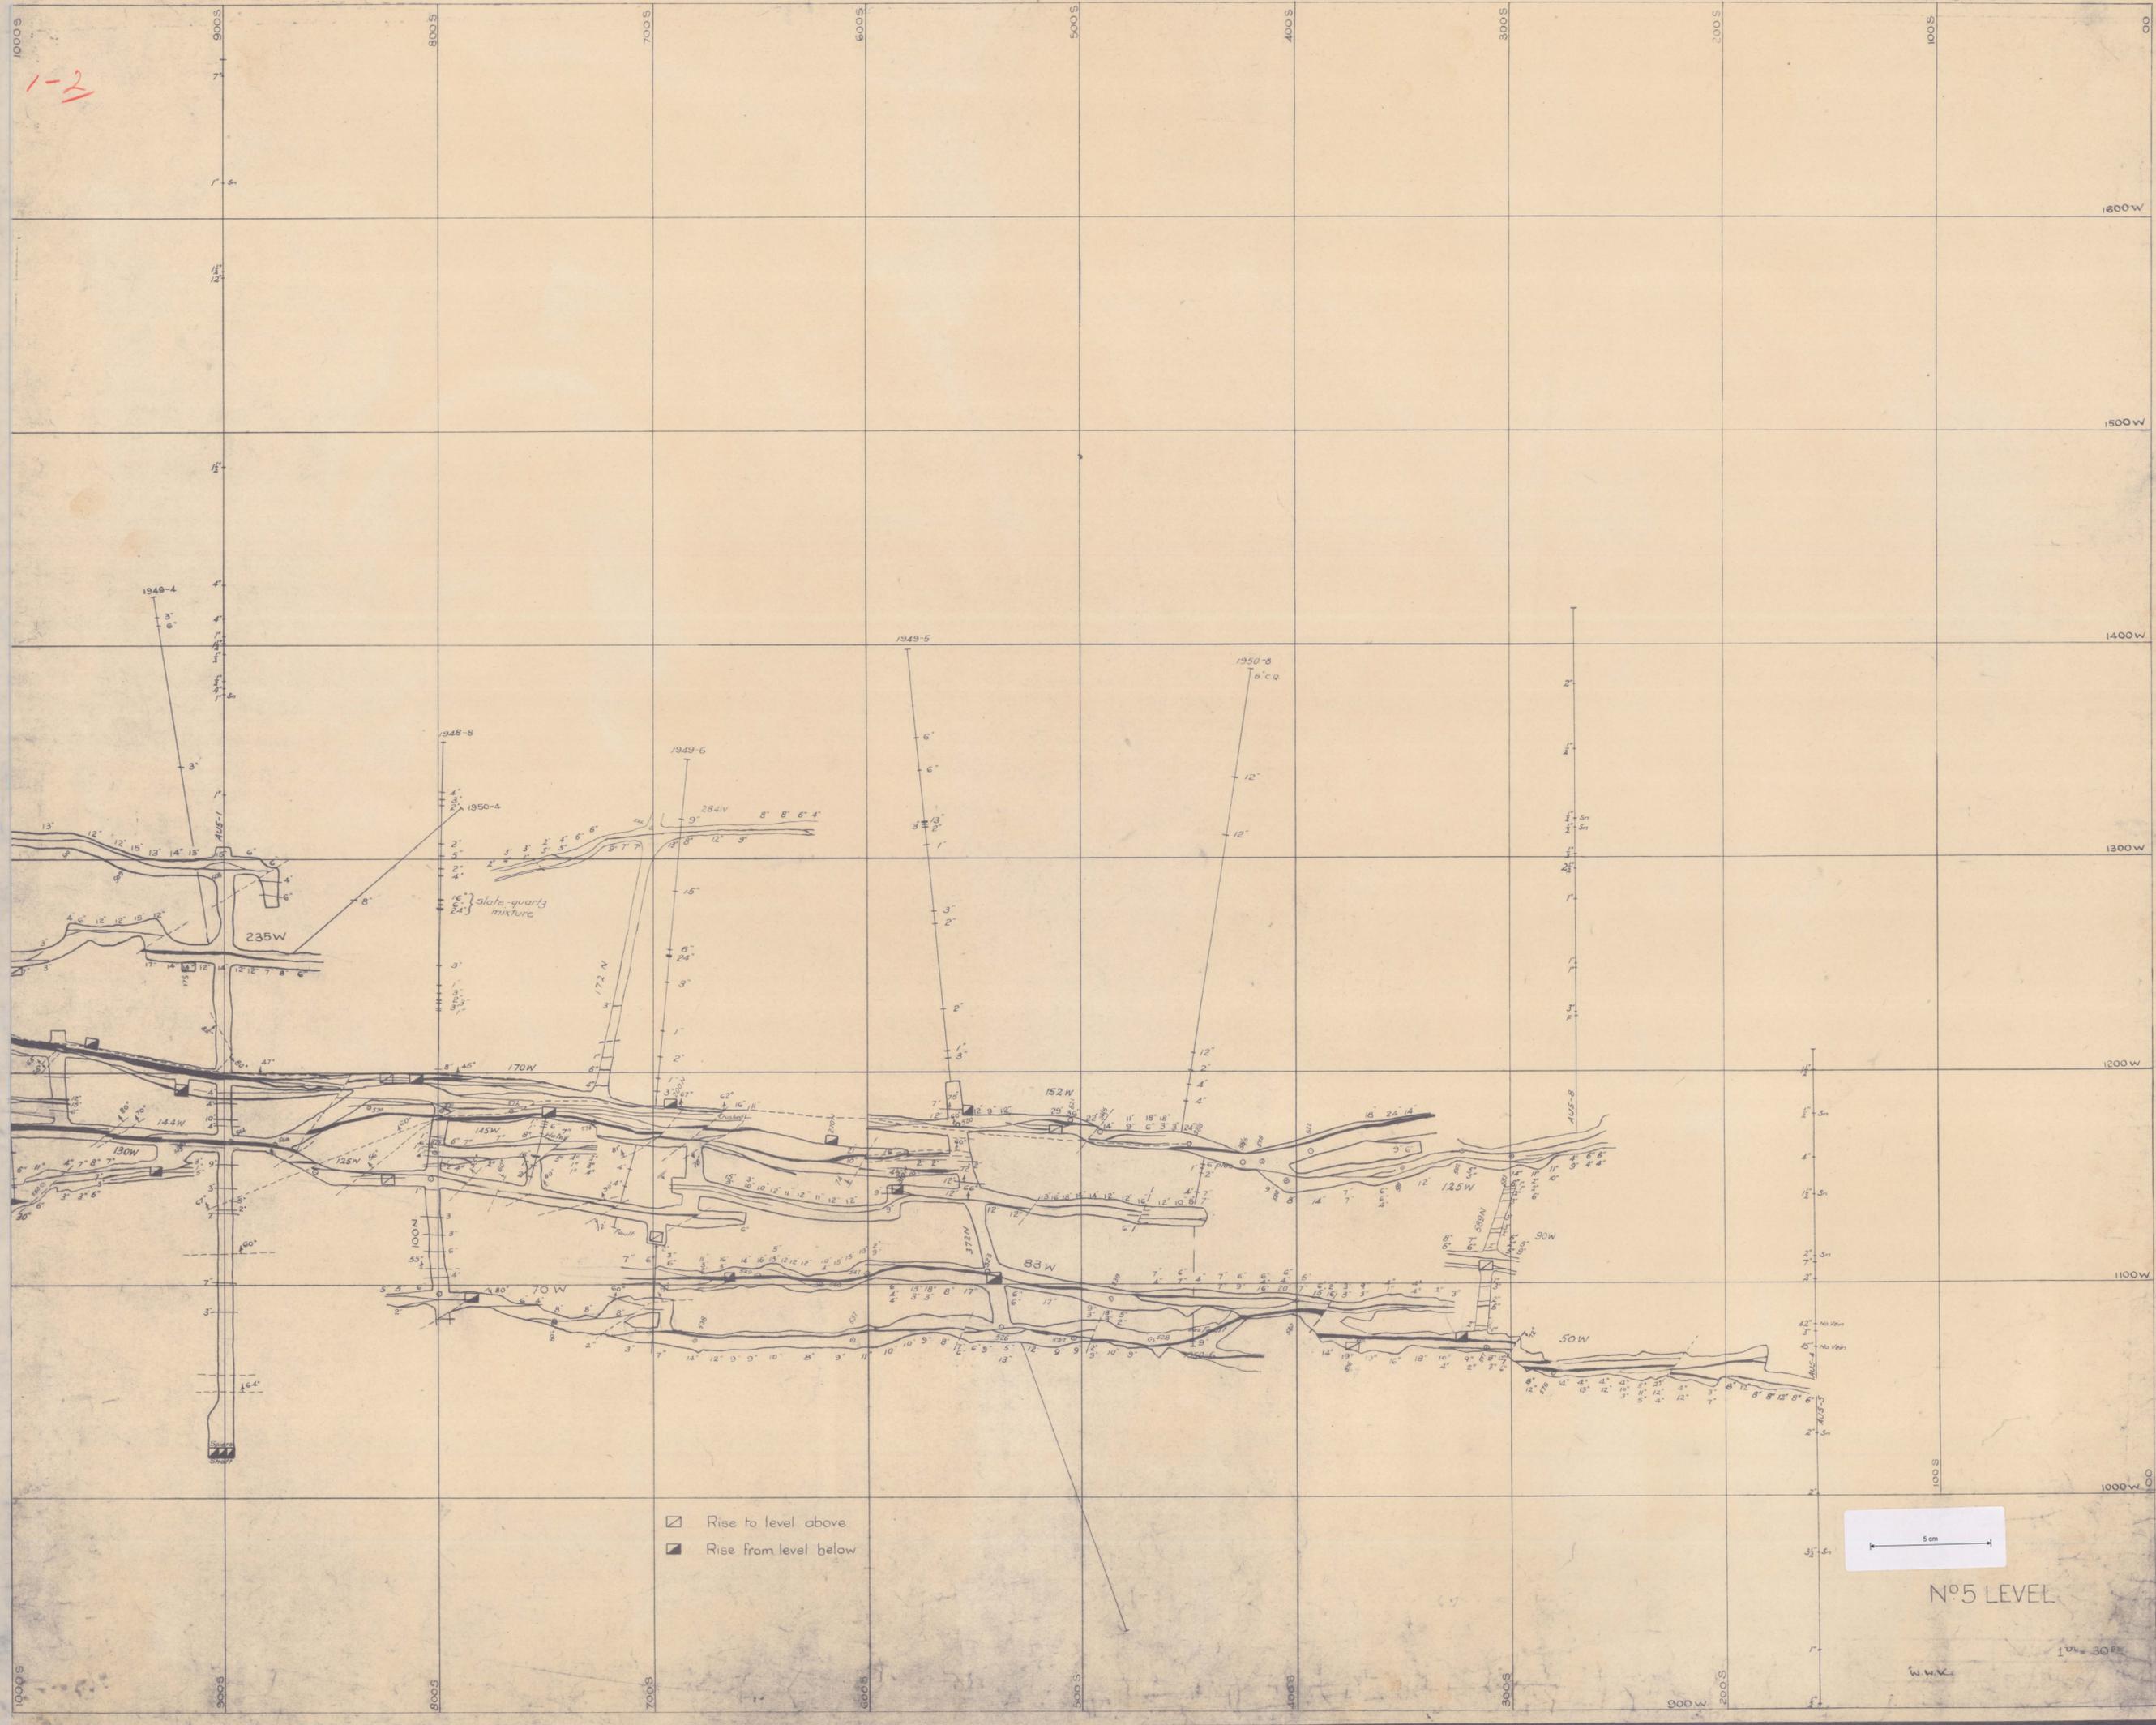

N°5 LEVEL

1" = 30'

W.W.V.