


0023-030

1-2

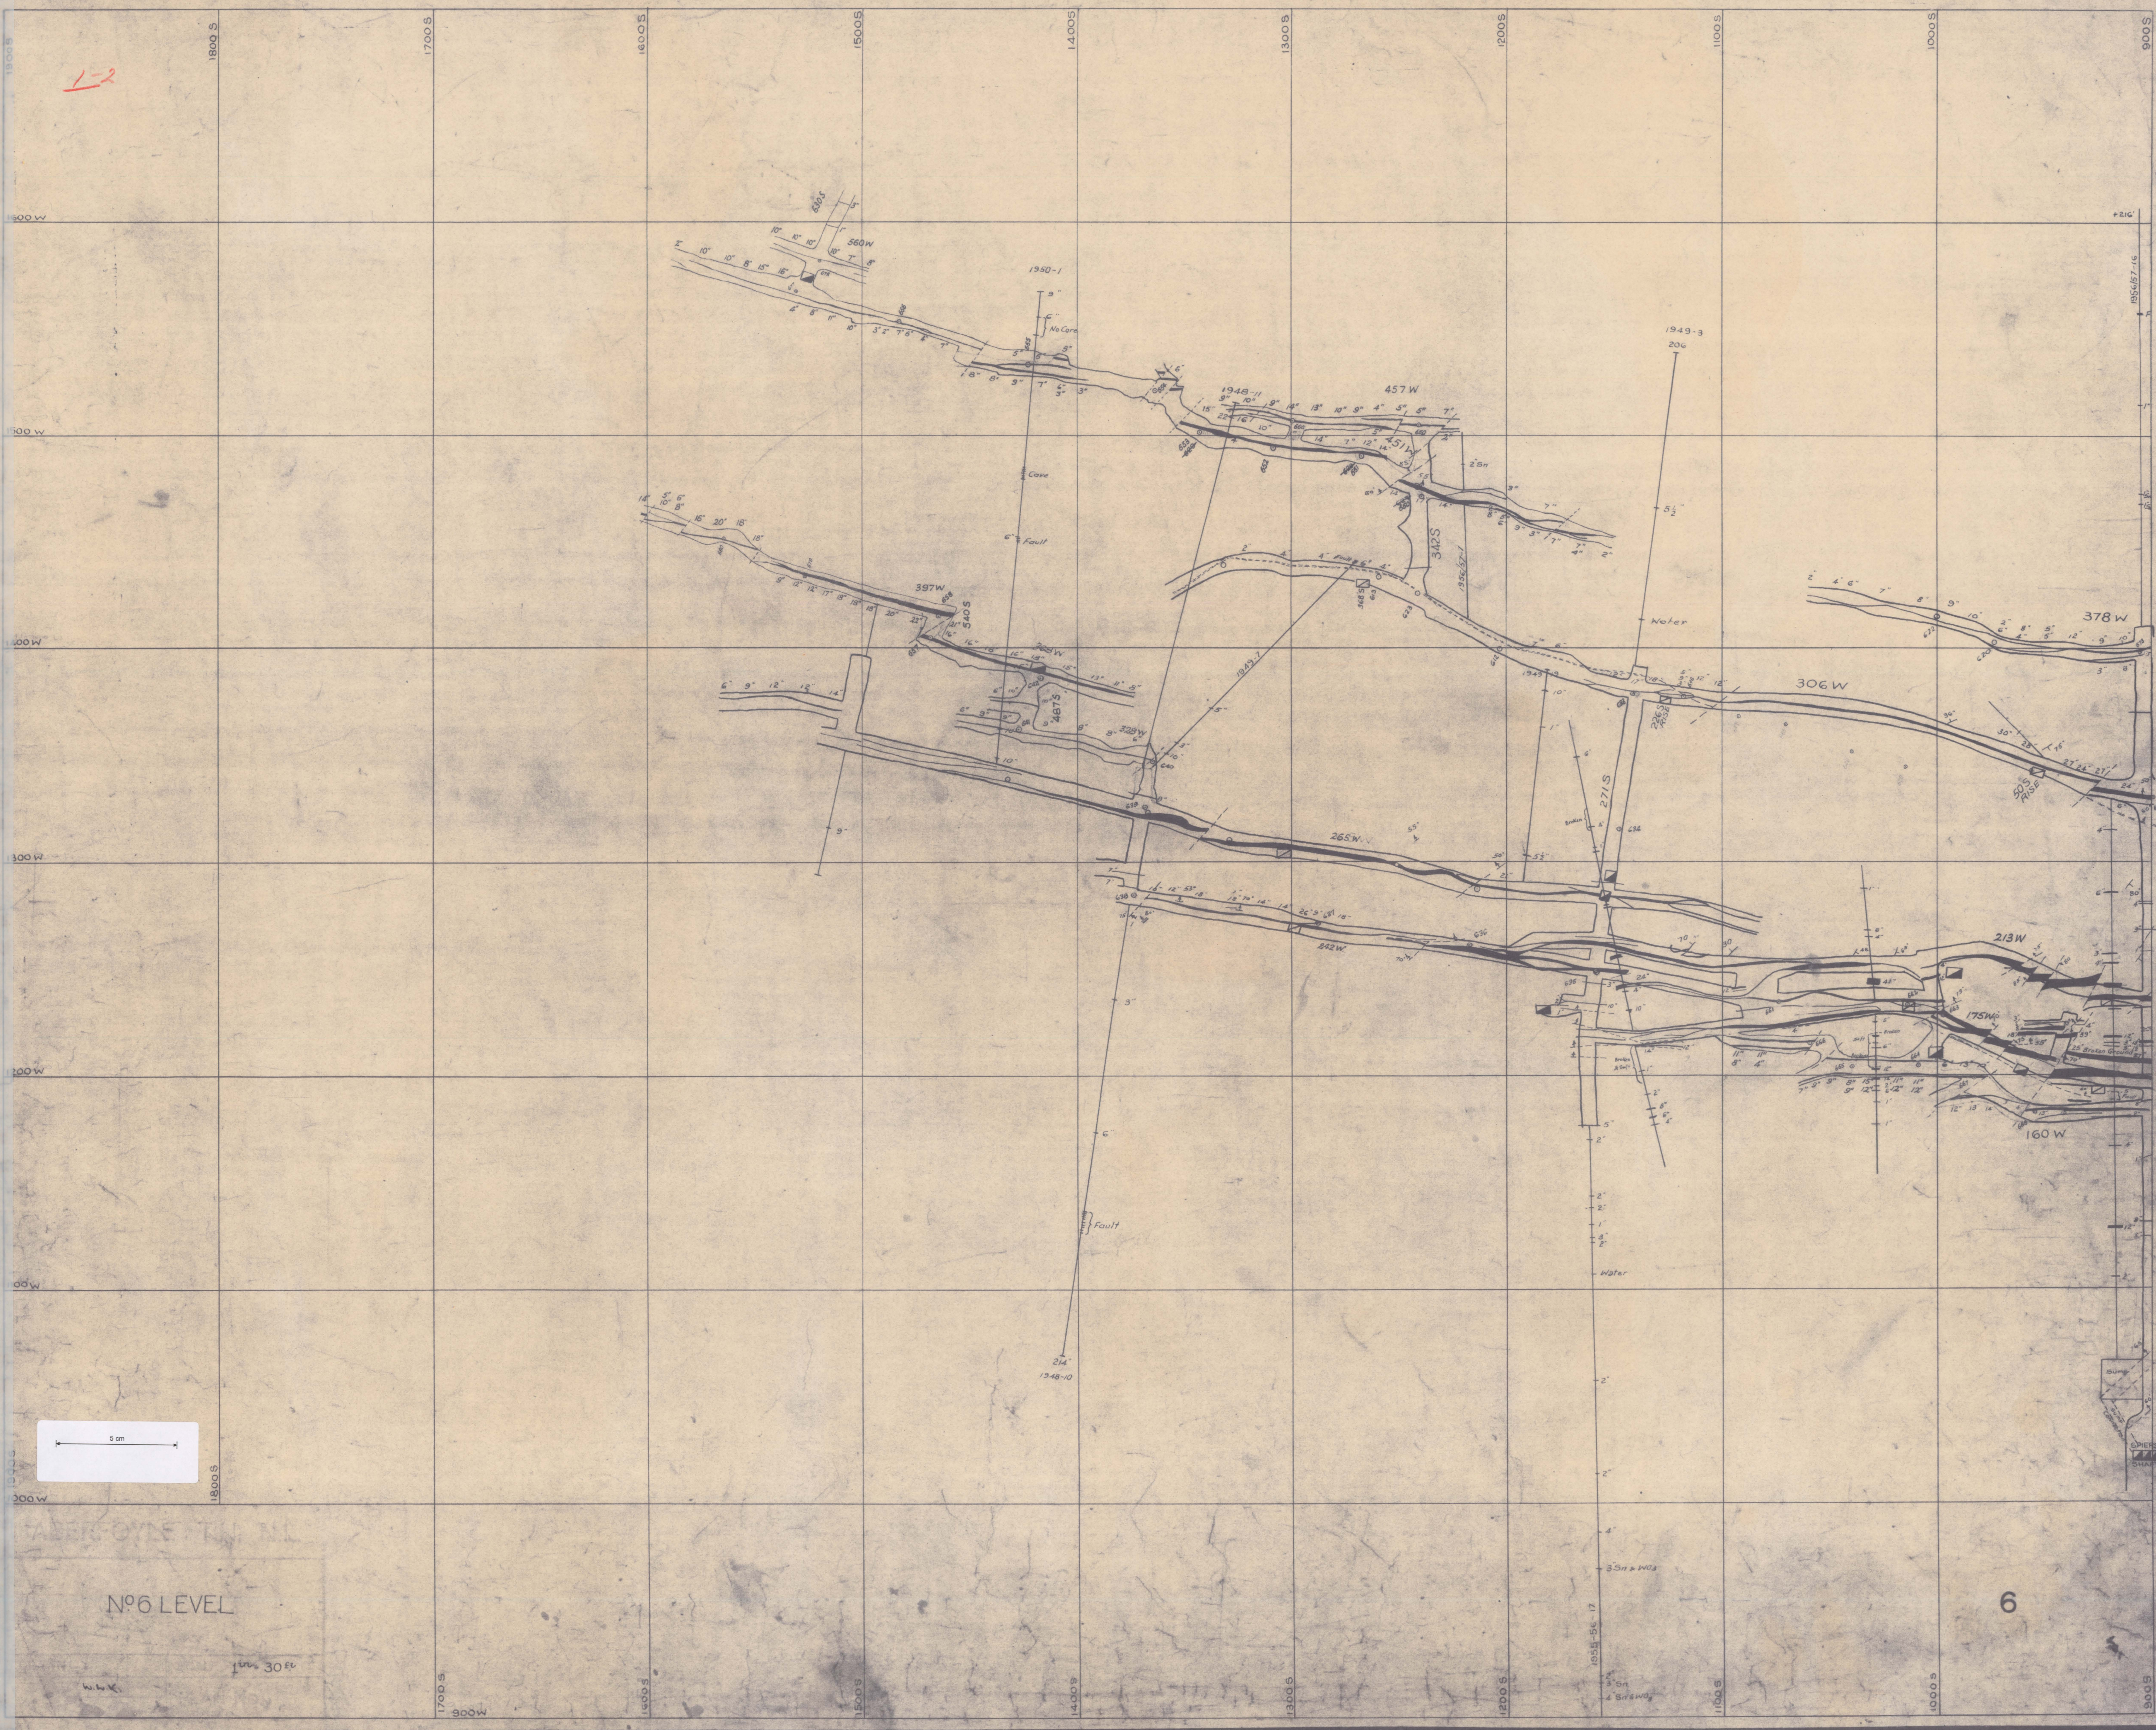

N°6 LEVEL

6