


1-2

0023-036

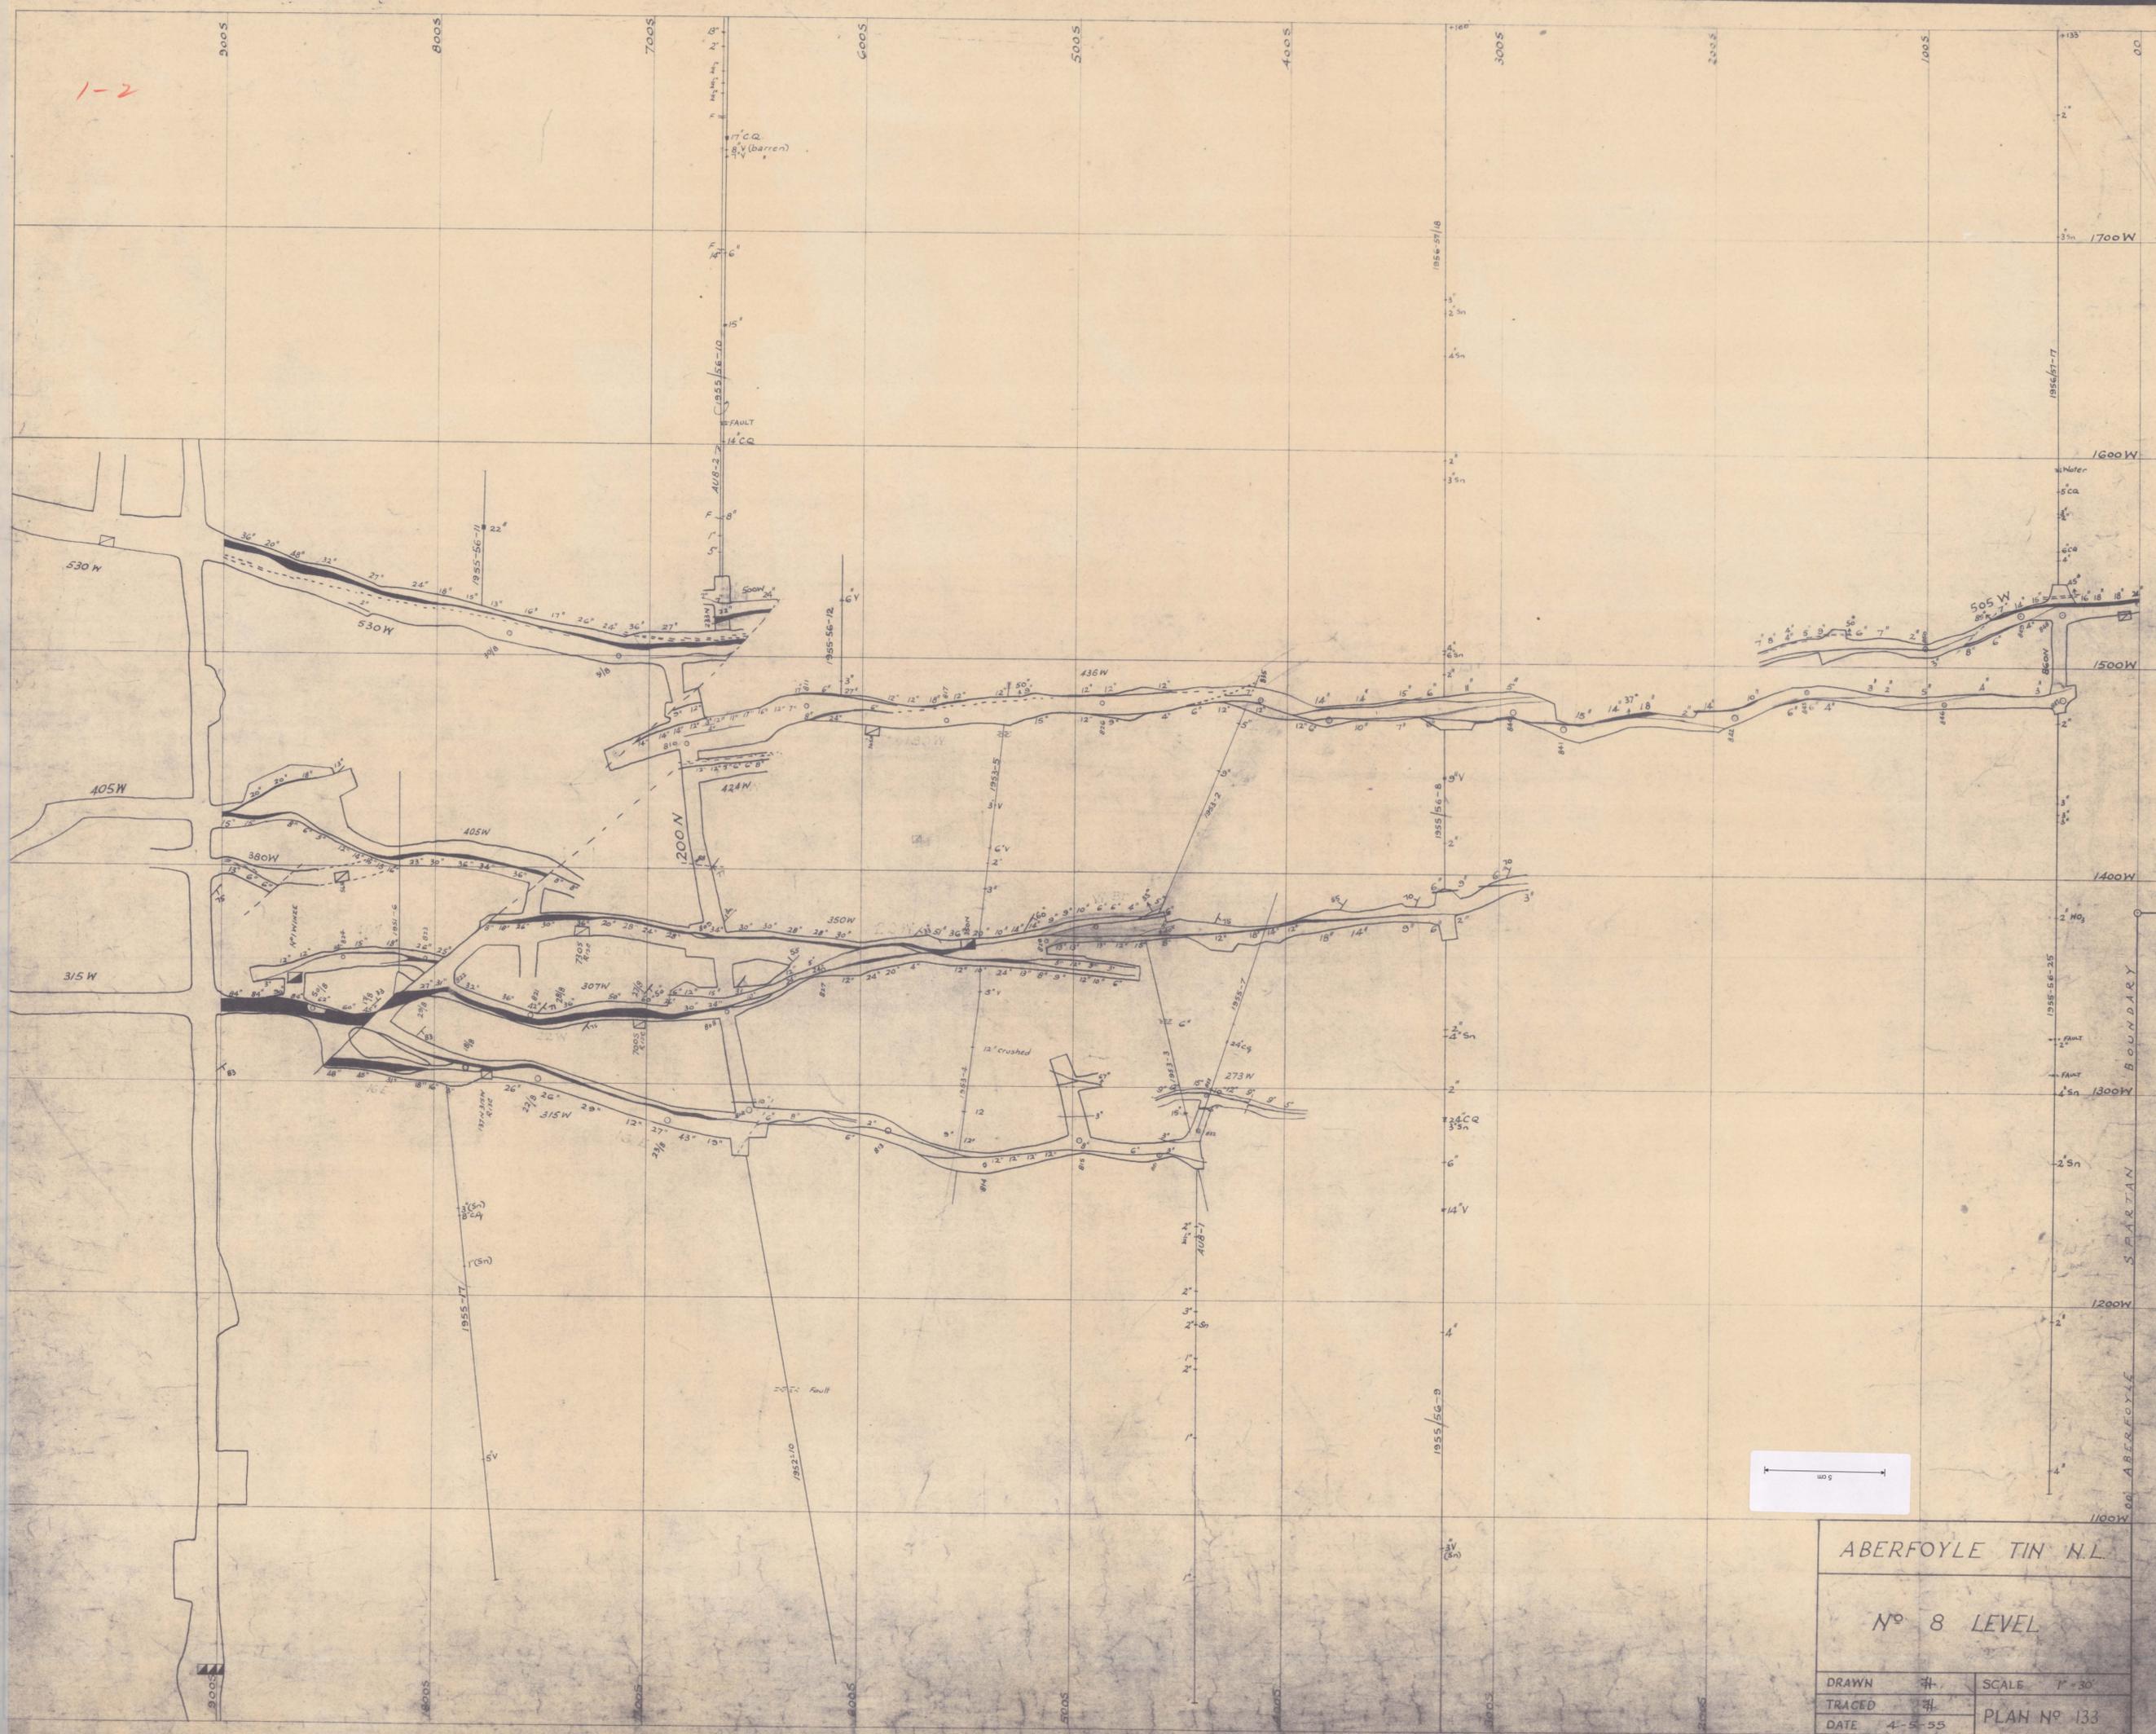

ABERFOYLE TIN N.L.	
N ^o 8 LEVEL	
DRAWN #1	SCALE 1" = 30'
TRACED #1	PLAN N ^o 133
DATE 4-5-55	