


1-2



ABERFOYLE TIN N.L.  
 SPARTAN SILVER-LEAD MINES N.L.

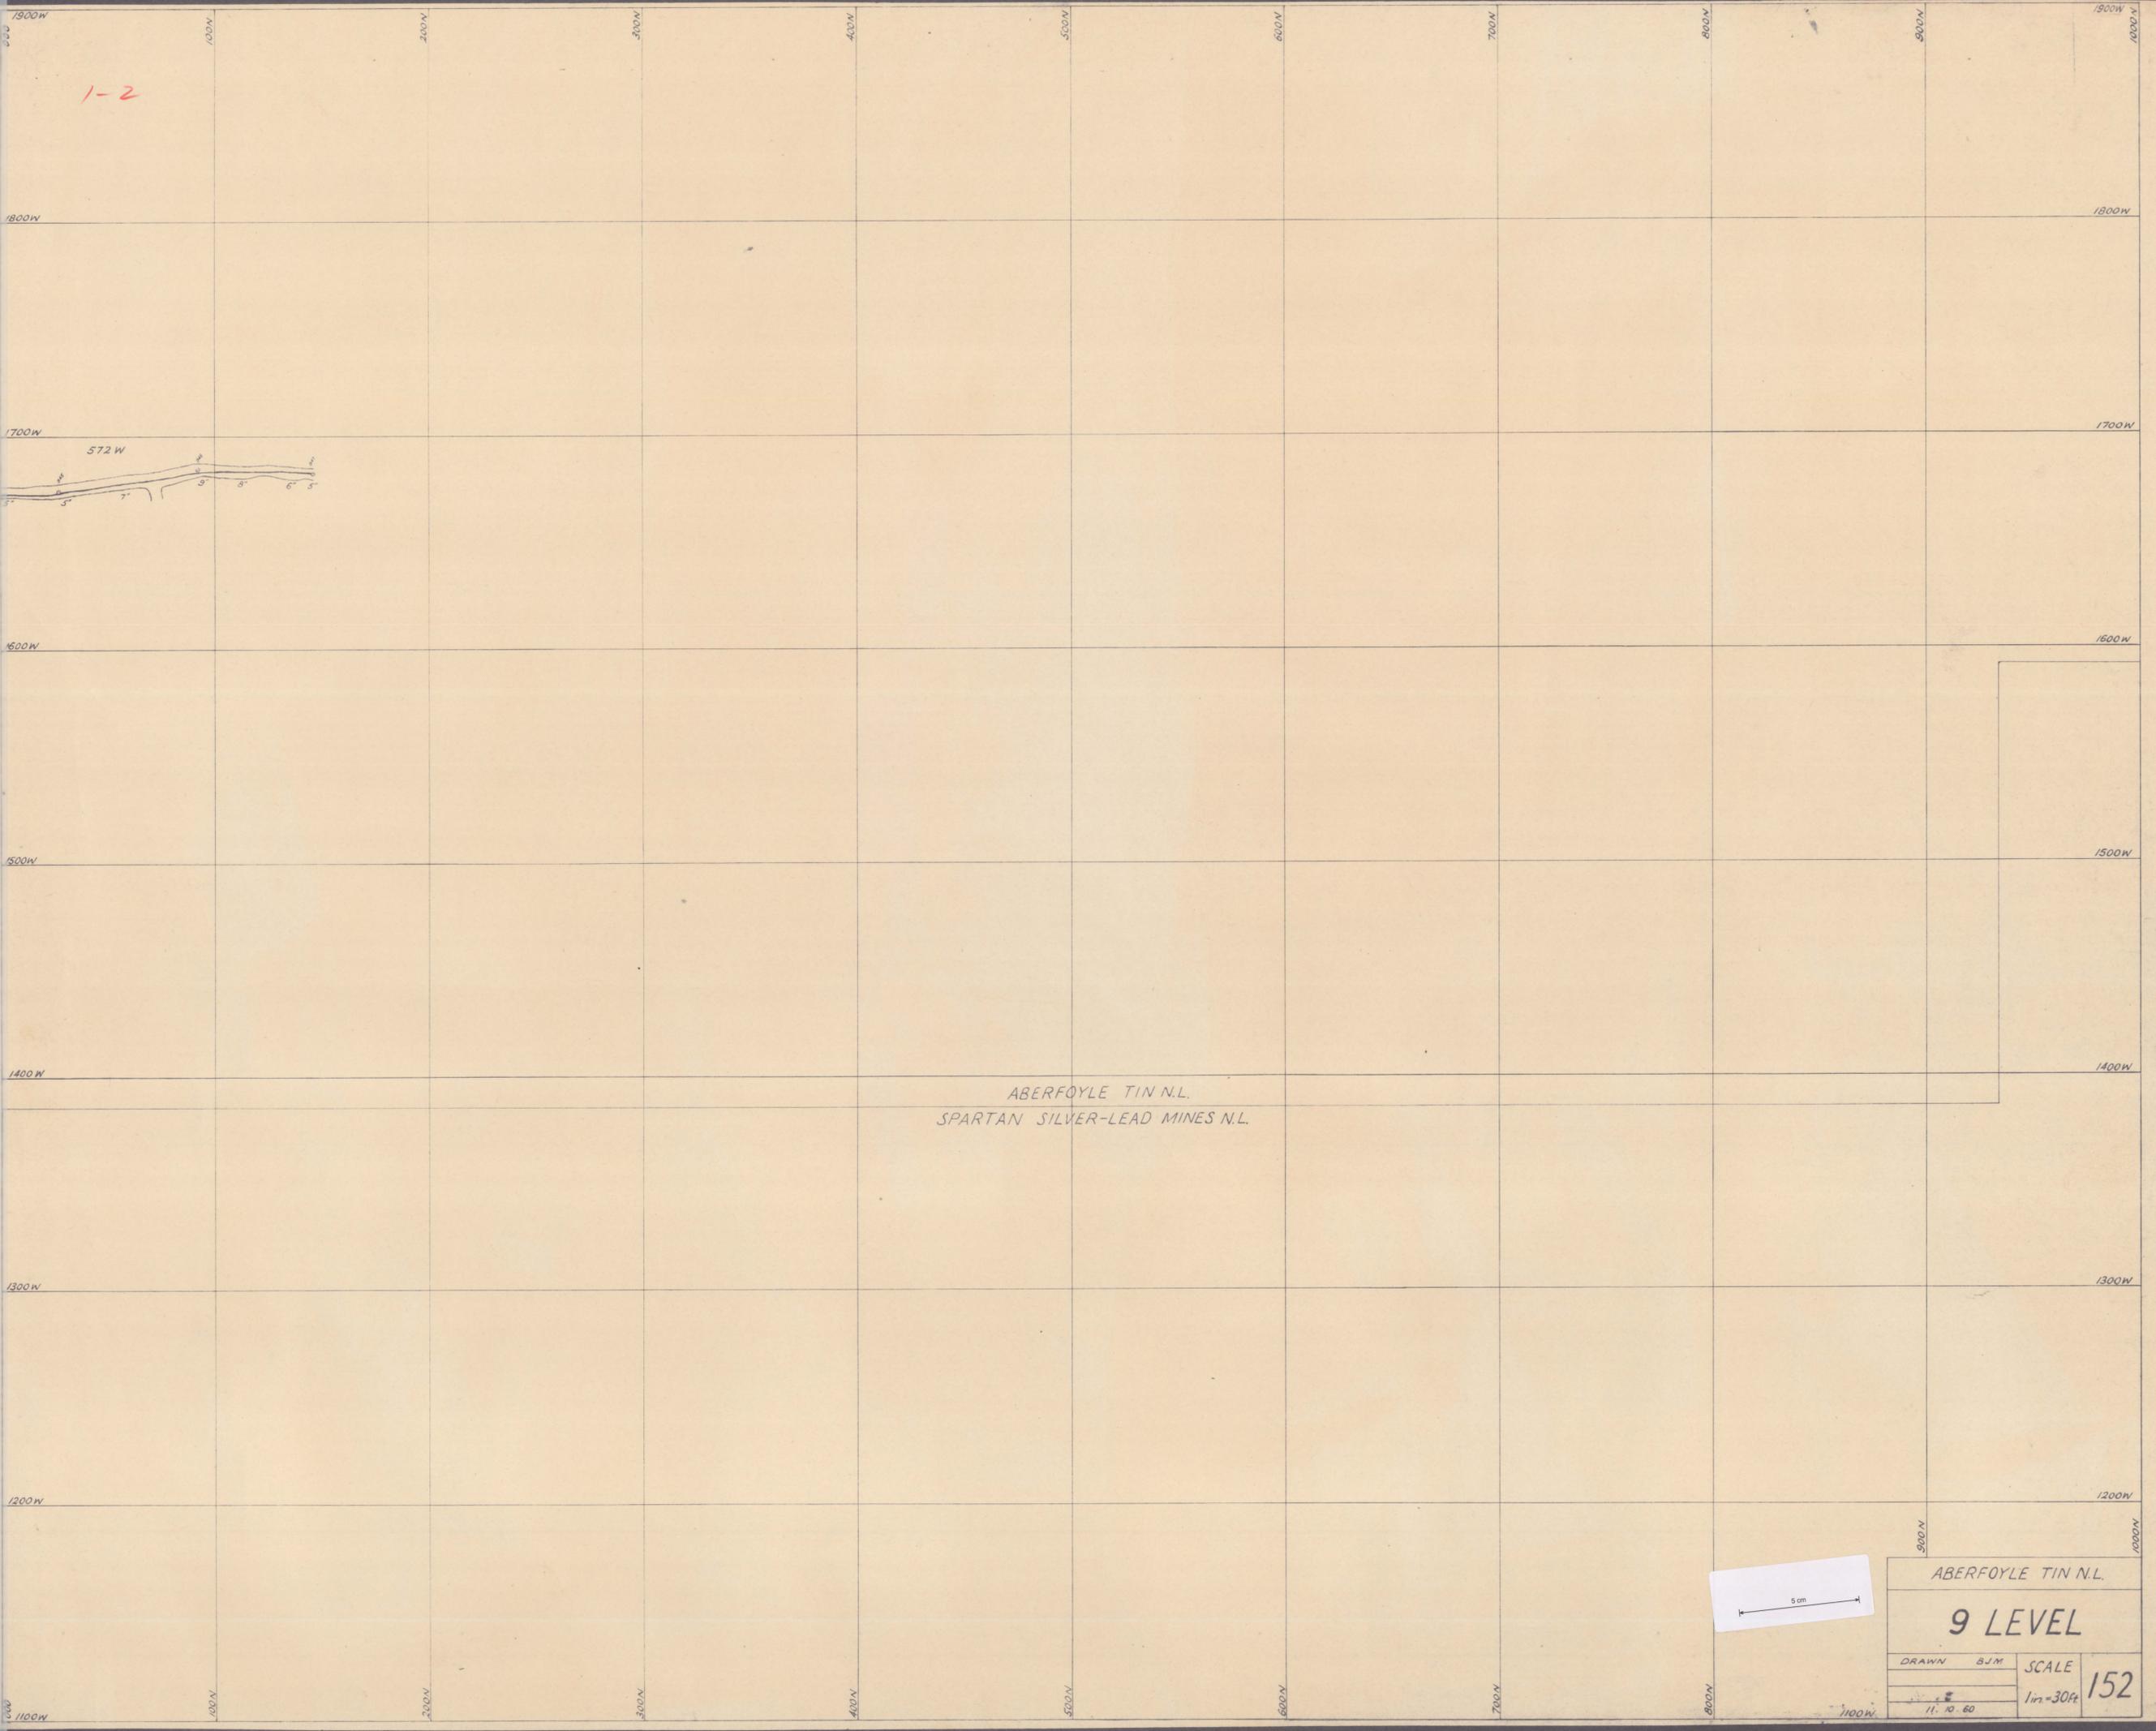

ABERFOYLE TIN N.L.	
<b>9 LEVEL</b>	
DRAWN	BJM
SCALE	
1 in = 30 ft	
11. 10. 60	
<b>152</b>	

0023-038