
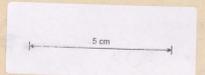


1-2

0023-040

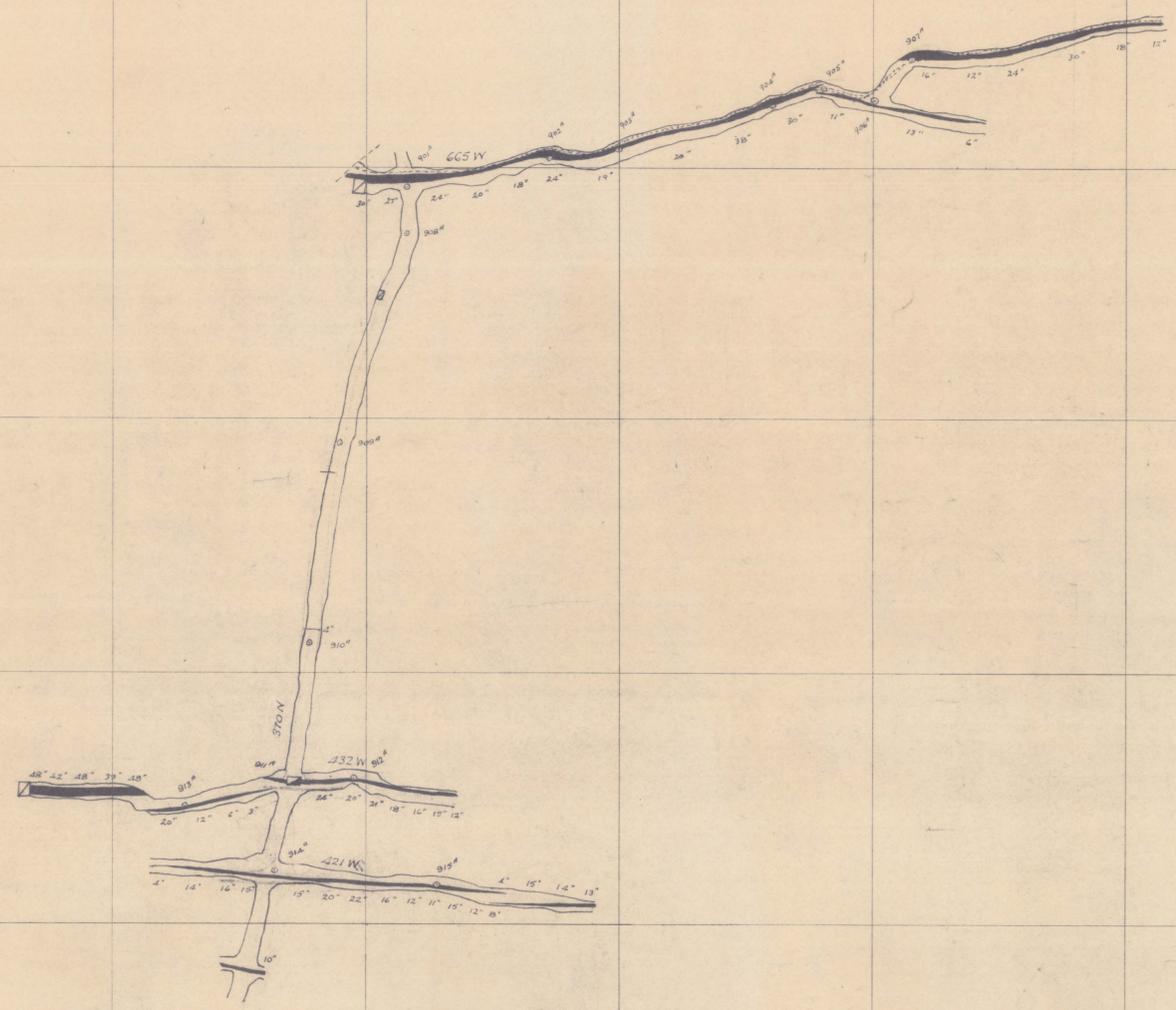

ABERFOYLE TIN M.L.  
 INTERMEDIATE LEVEL  
 78' BELOW N° 9 LEVEL

R. Nelson  
 1" = 30'-0"  
 18<sup>th</sup> Sept. 1958

900 S  
800 S  
700 S  
600 S  
500 S  
400 S  
300 S  
200 S  
100 S

1900 W  
1800 W  
1700 W  
1600 W  
1500 W  
1400 W  
1300 W