
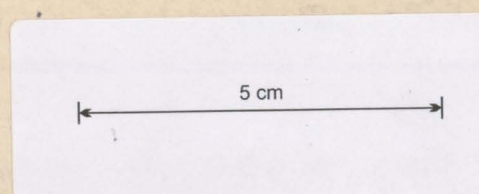


1-2

0023-041

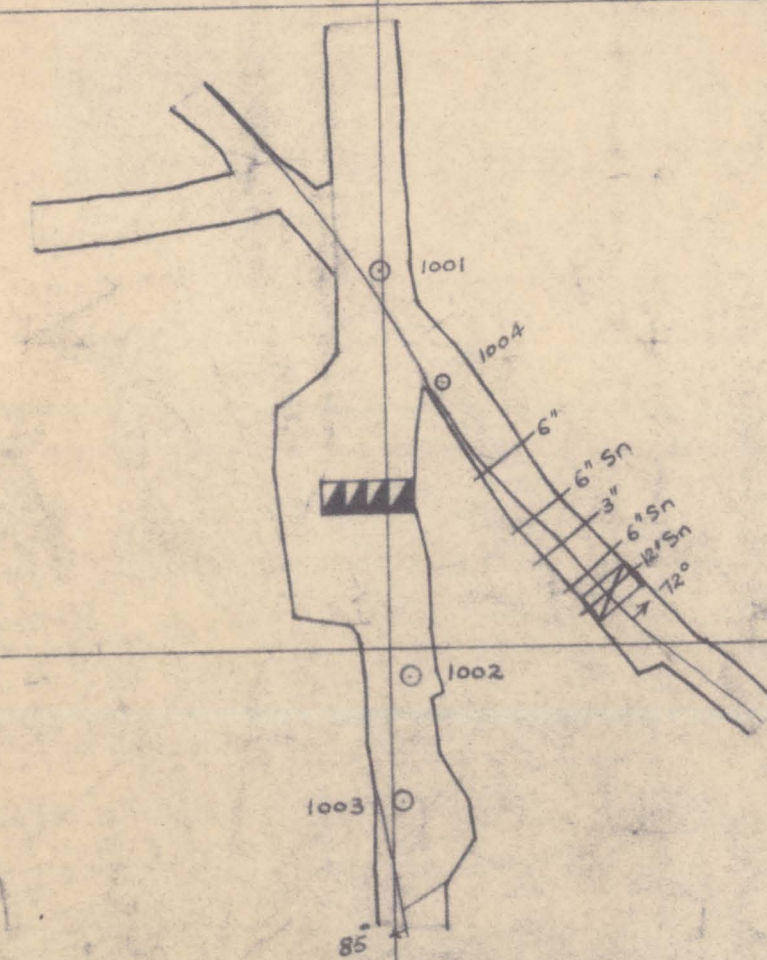

ABERFOYLE TIN N.L.

N° 10 LEVEL

R.L. 1061

DRAWN	#	SCALE	1" = 30'
TRACED	#	PLAN	N° 153
DATE	18-11-54		