
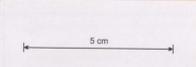


0023-044

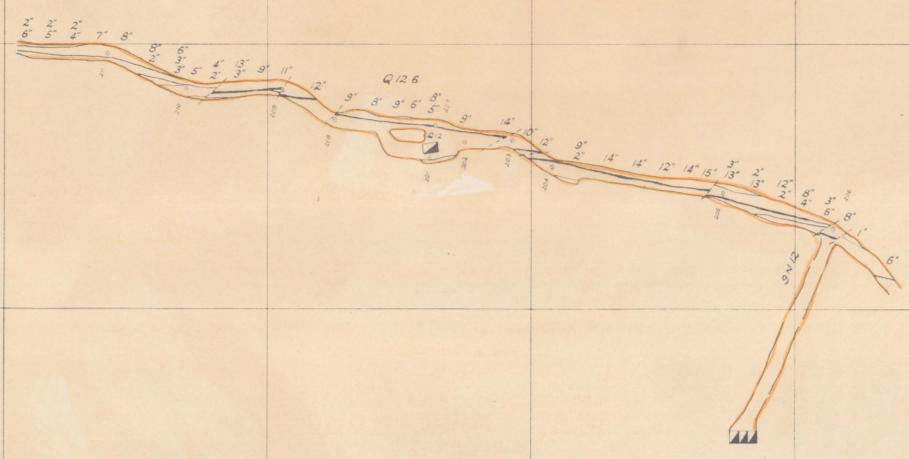

ABERFOYLE TIN N.L.
 2 LEVEL
 DRAWN BJM
 Scale
 1 in. = 30 ft.
 17 7. 61