


0023-046

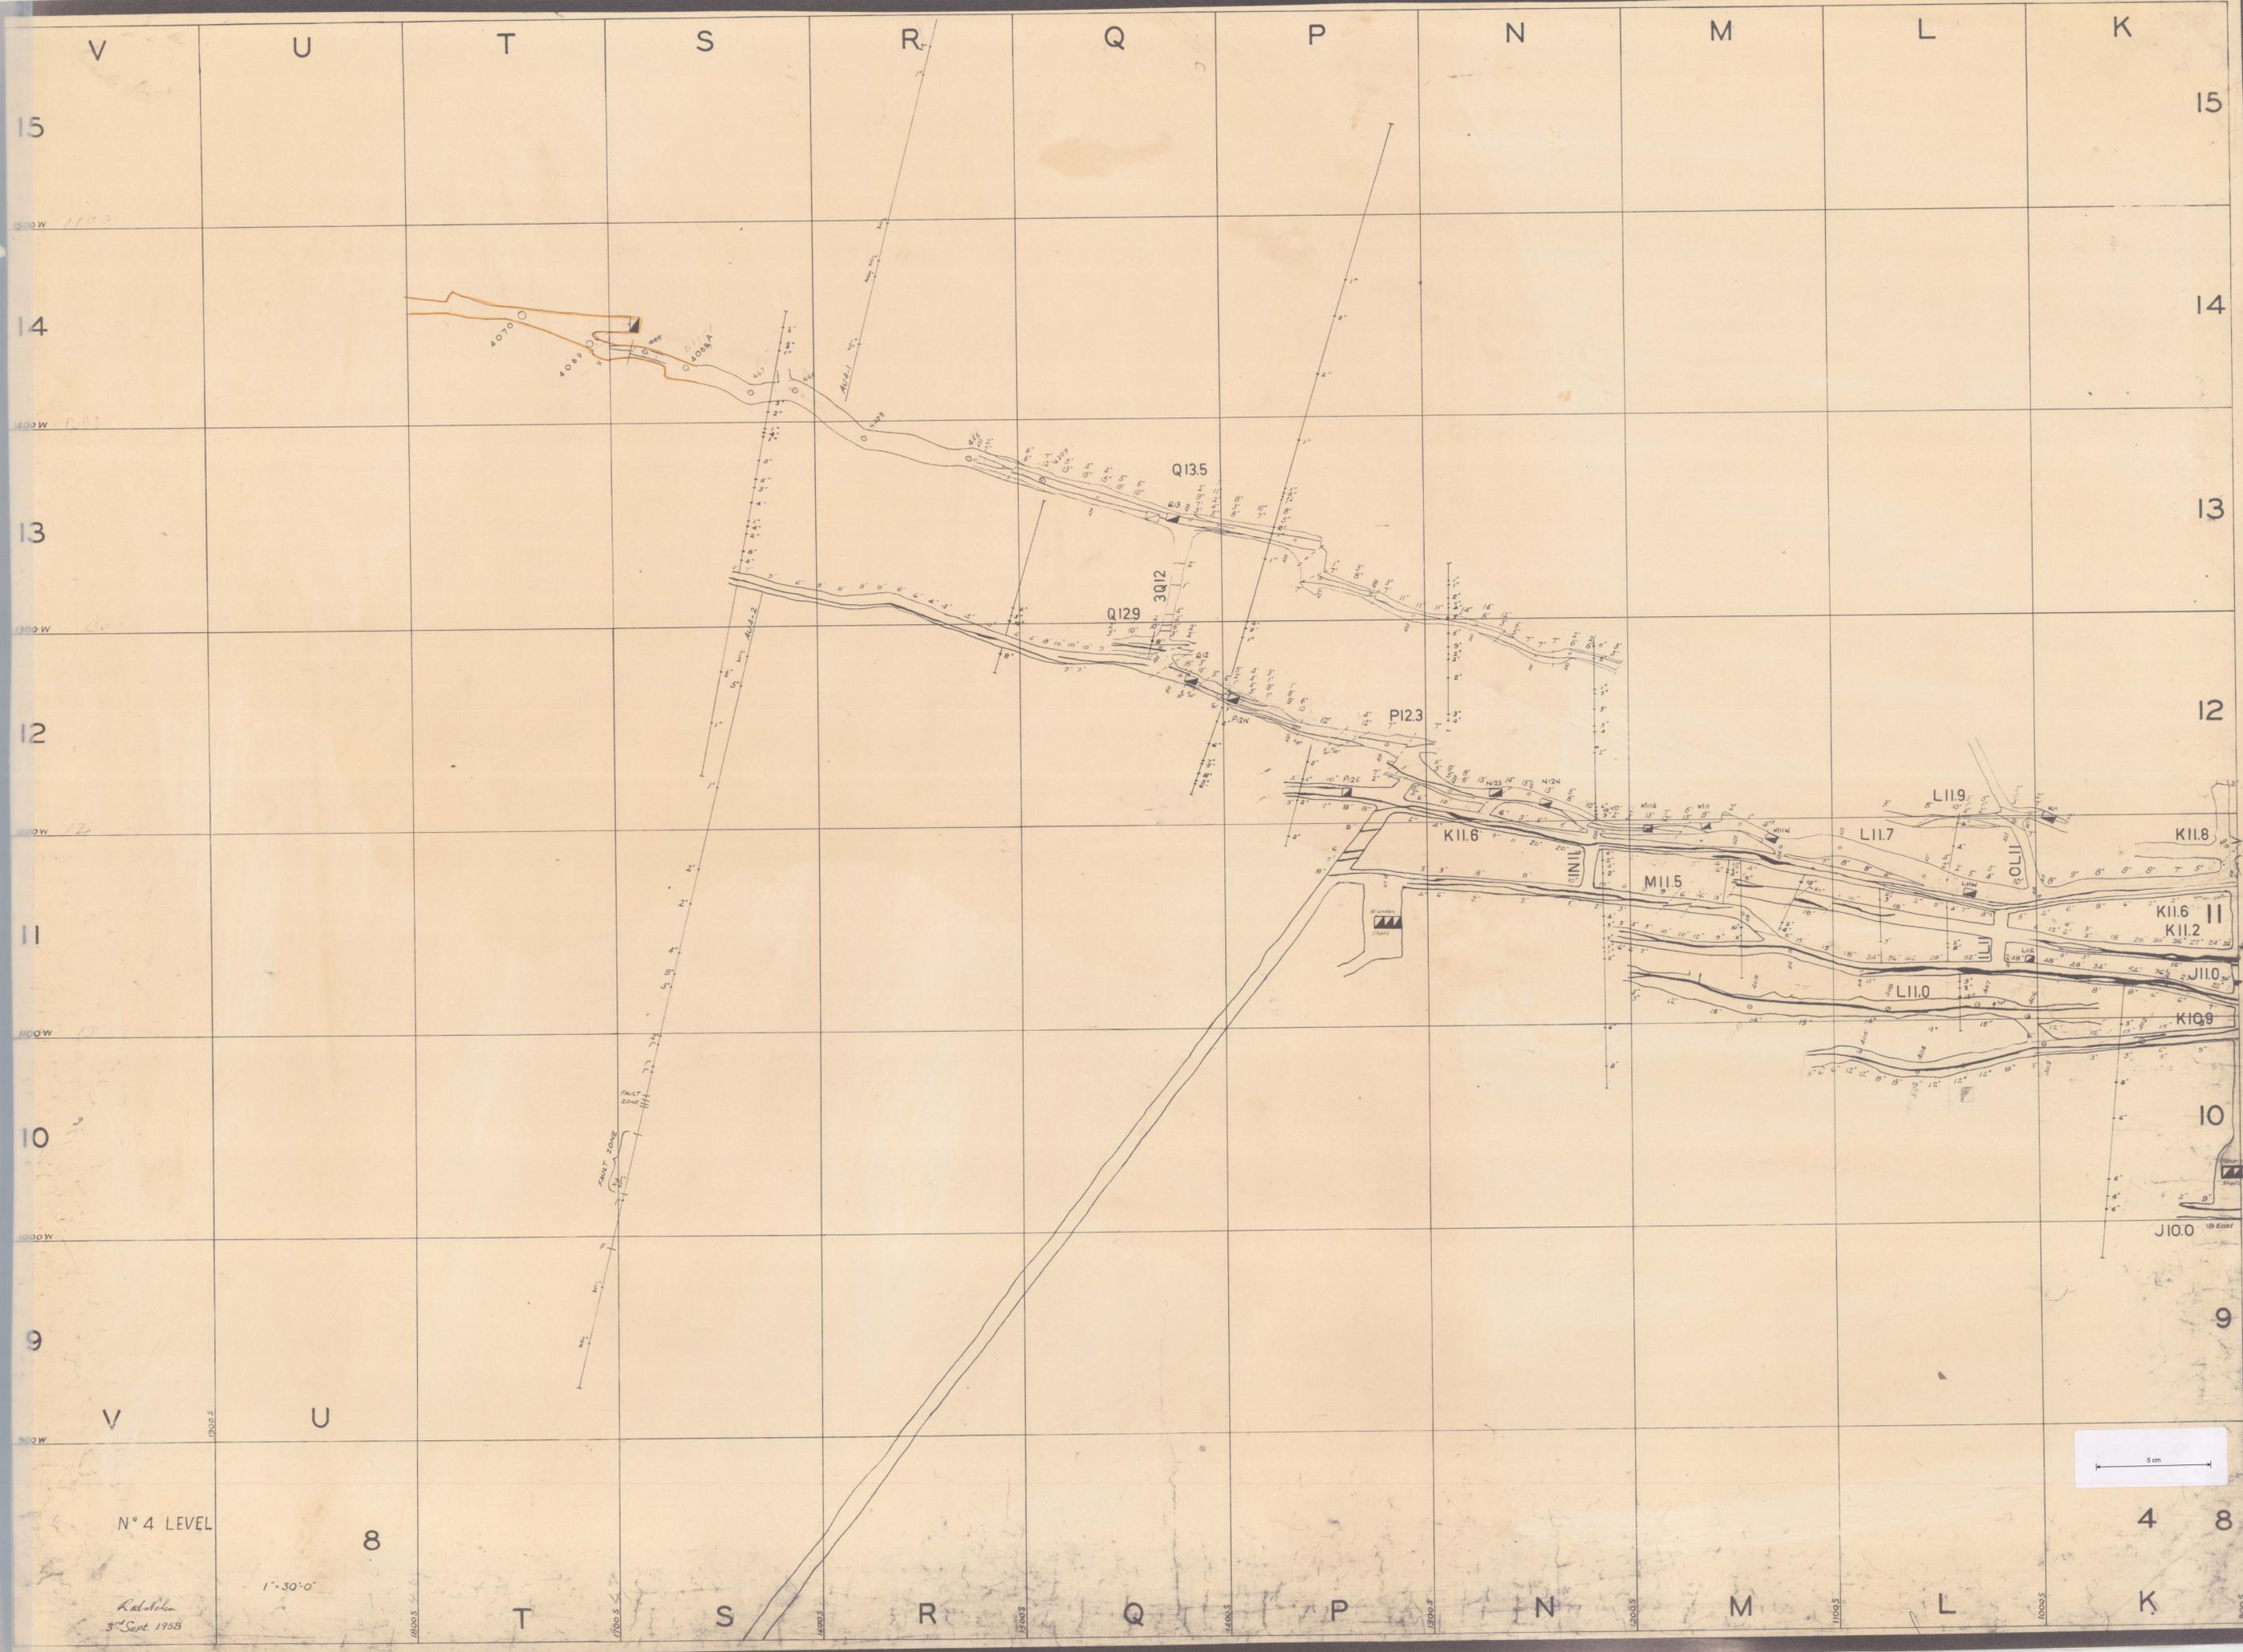

N° 4 LEVEL

1" = 30' 0"

Robertson  
3<sup>rd</sup> Sept. 1958

