



0023-047

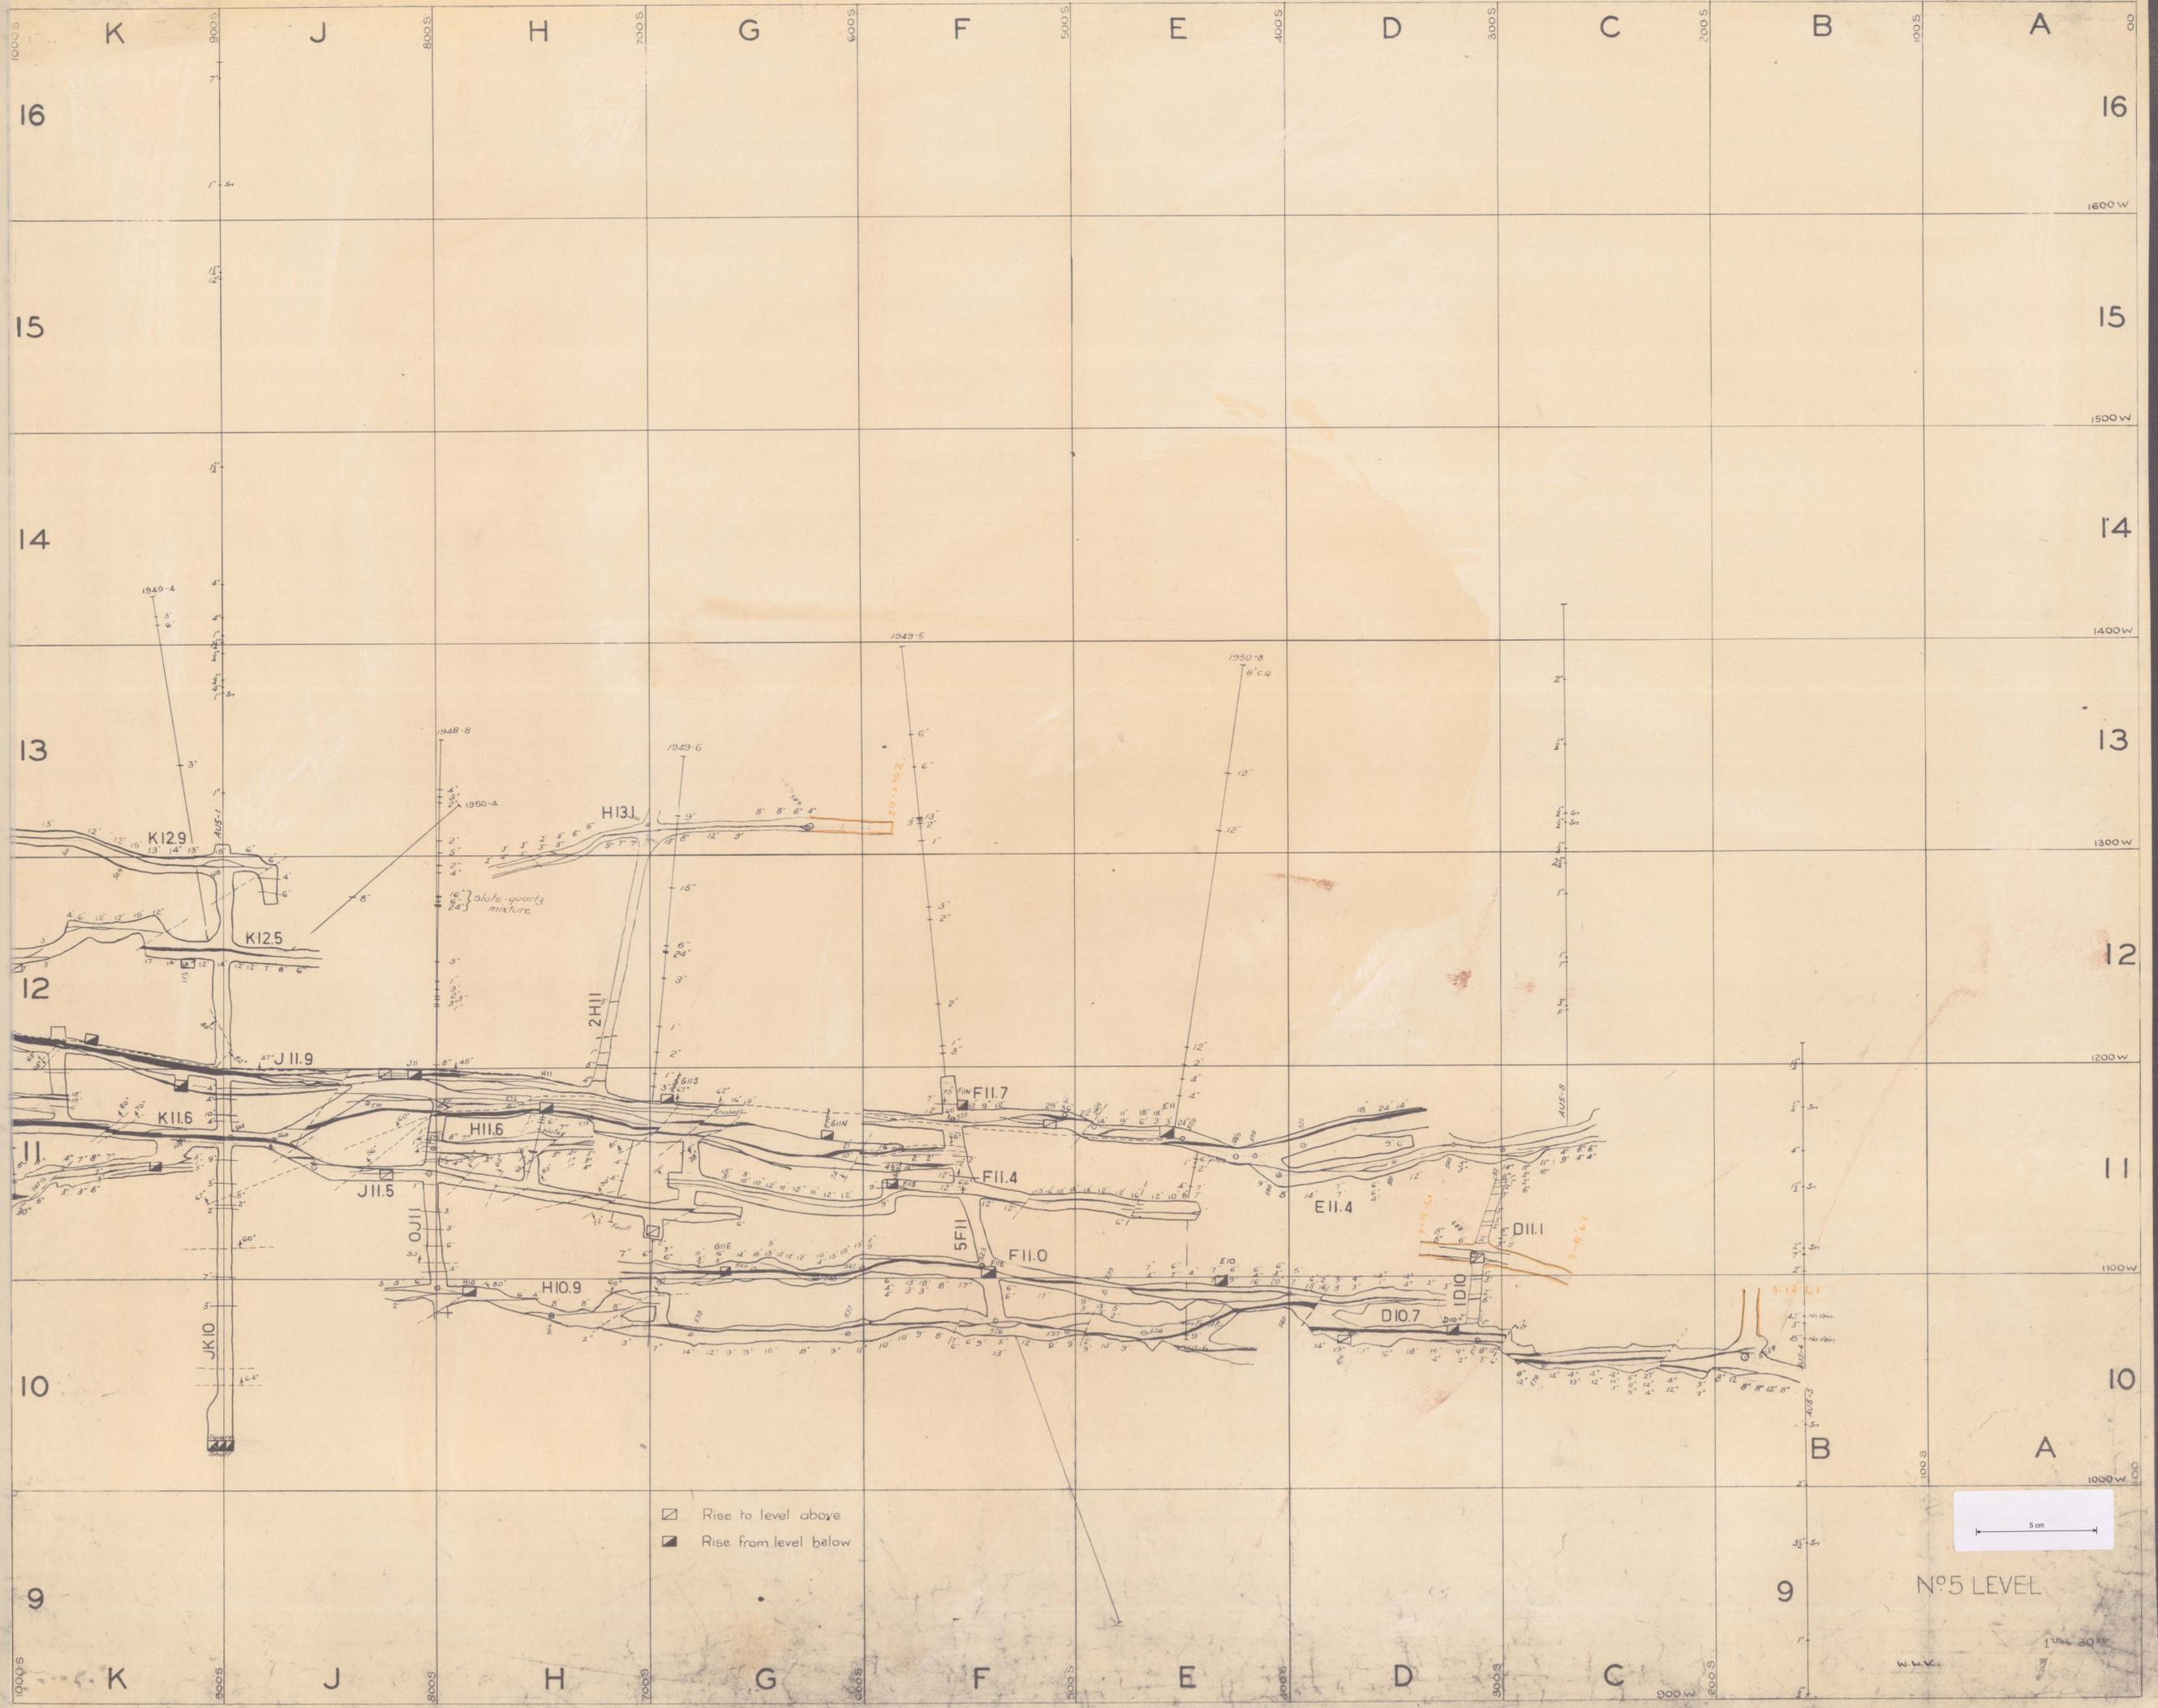

- ▣ Rise to level above
- ▣ Rise from level below

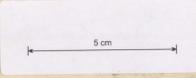

N°5 LEVEL

W.W.V.