
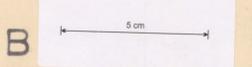


0023_054

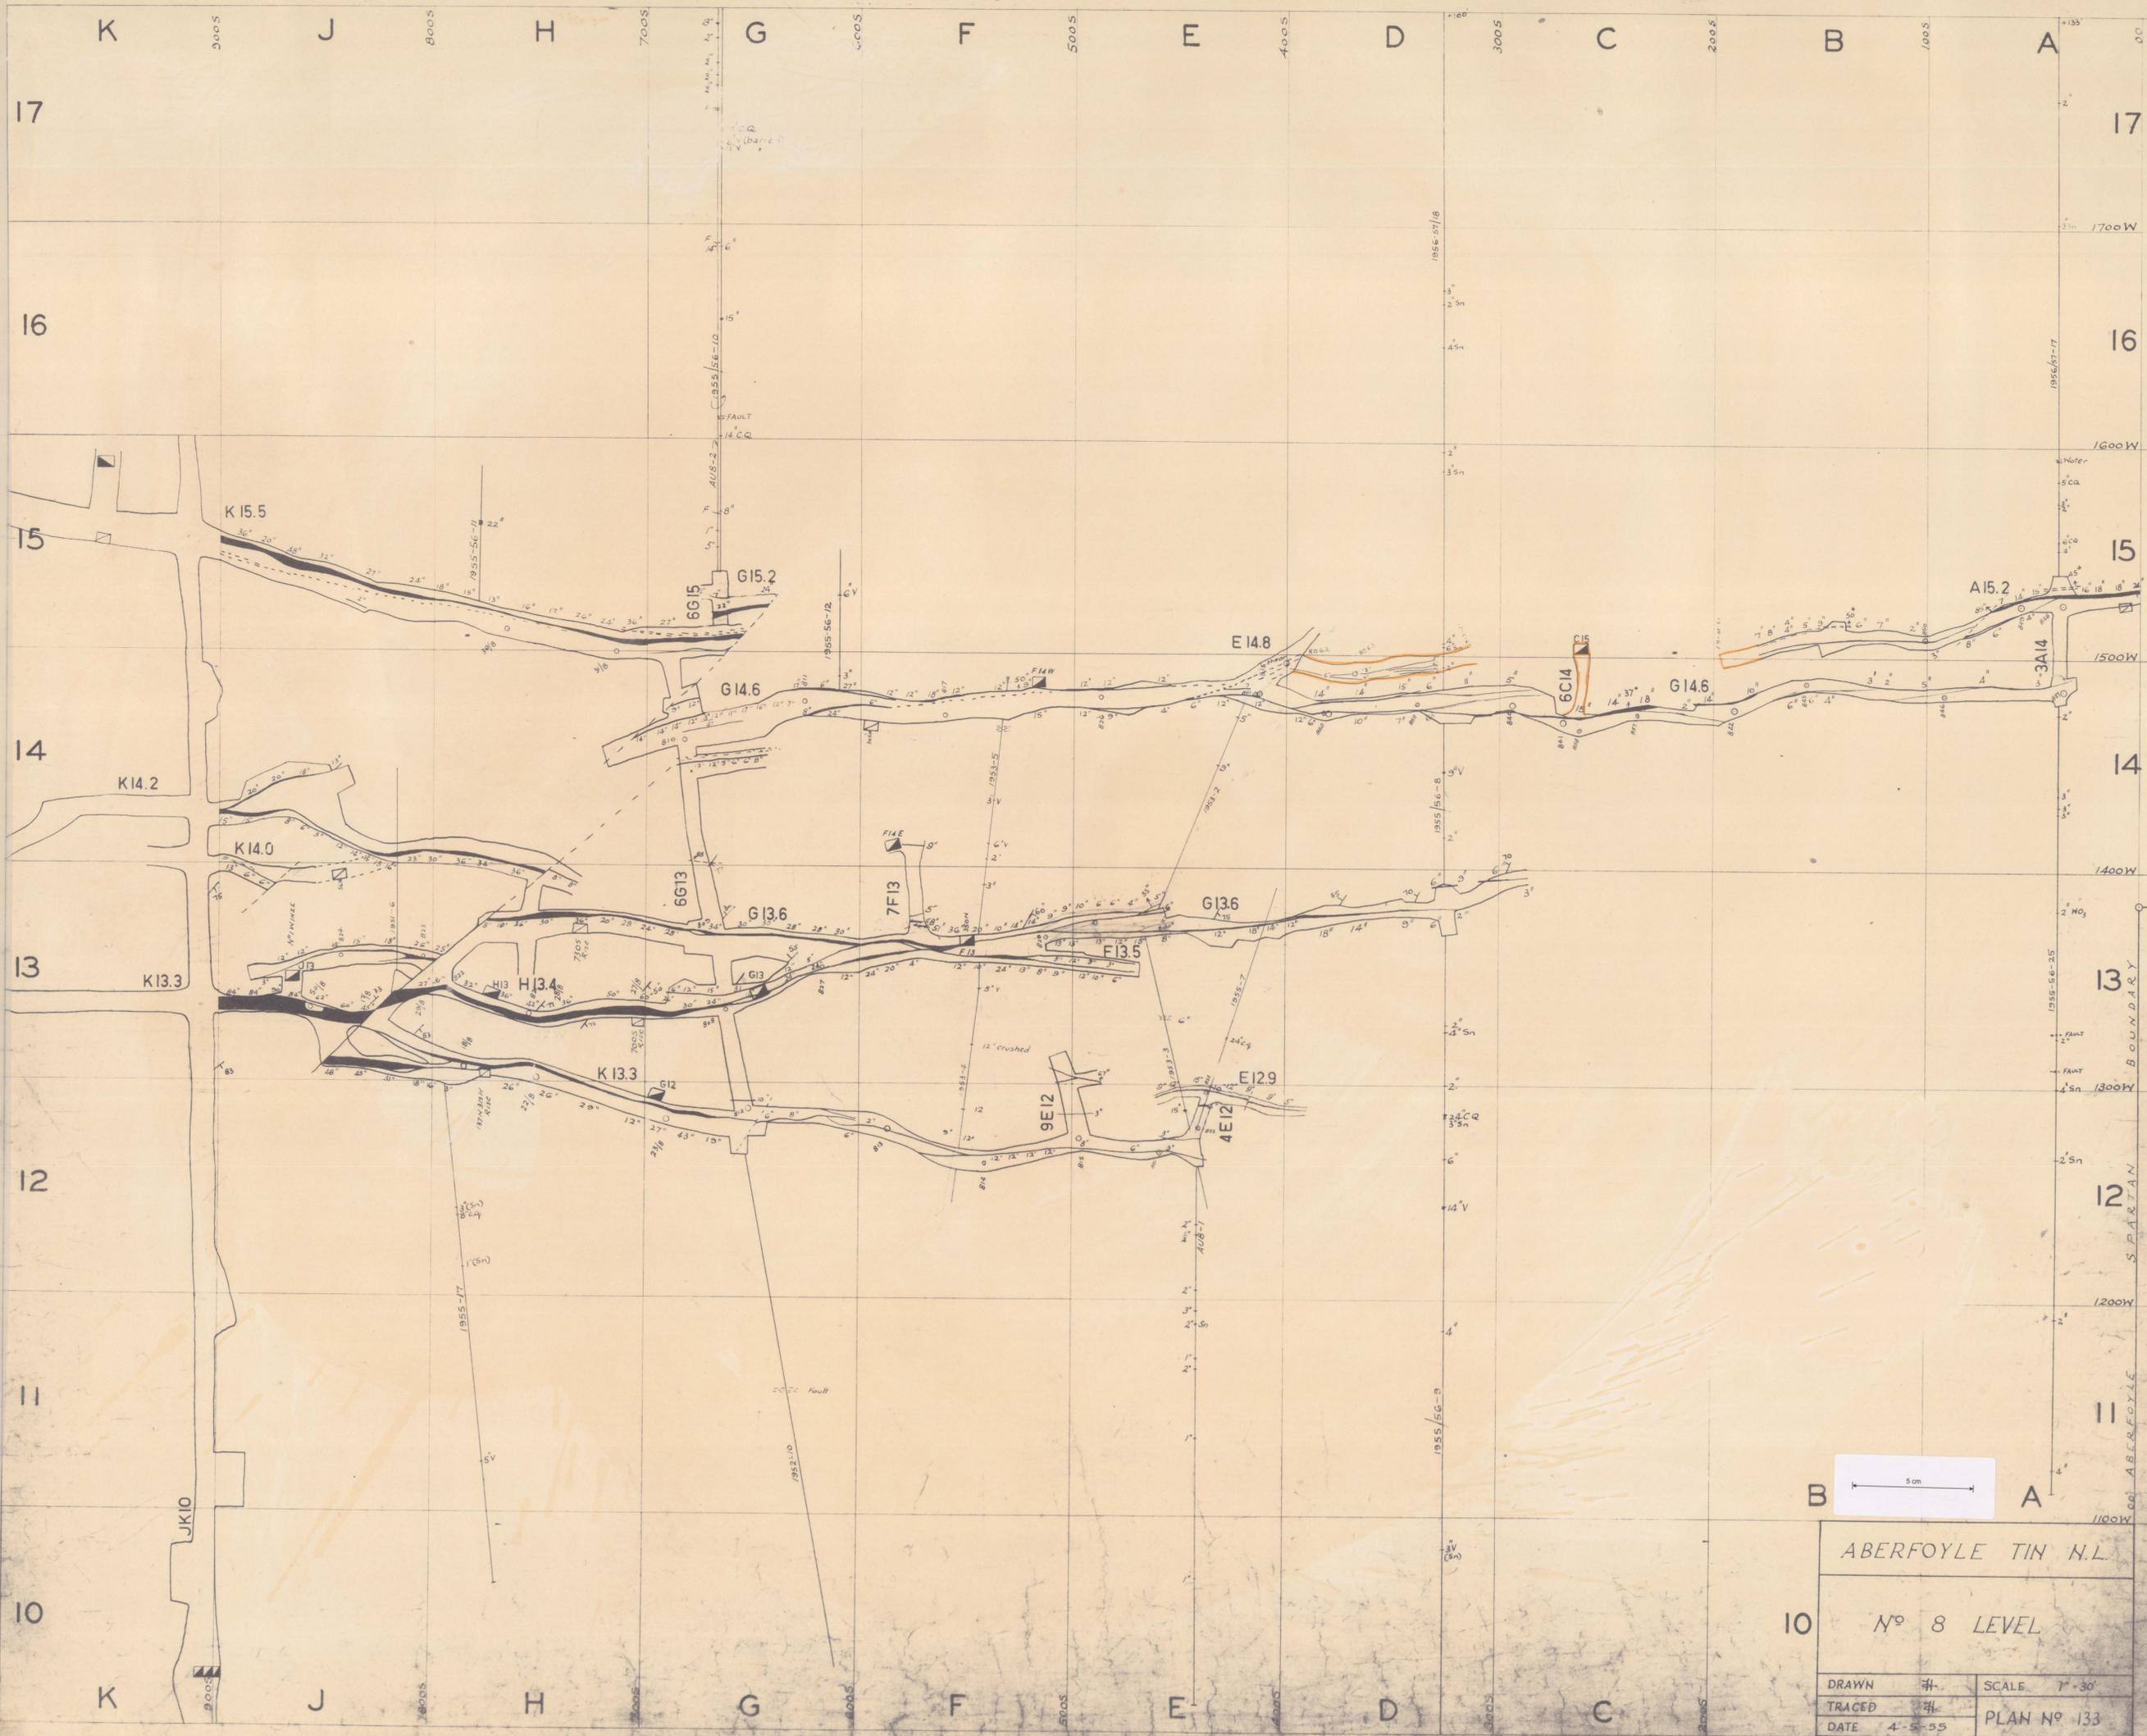

ABERFOYLE TIN N.L.

No 8 LEVEL

DRAWN	#1	SCALE	1" = 30'
TRACED	#1	PLAN No	133
DATE	4-5-55		