


25-01

PLAN OF UNDERGROUND WORKINGS OF YORK PLAINS COAL MINE

EXTENSION IN RED; MADE THE 9-4-1931

C. E. Knight, A. M. S. E. Asst.
H. A. H. Surveyor

Scale 40 feet to an inch

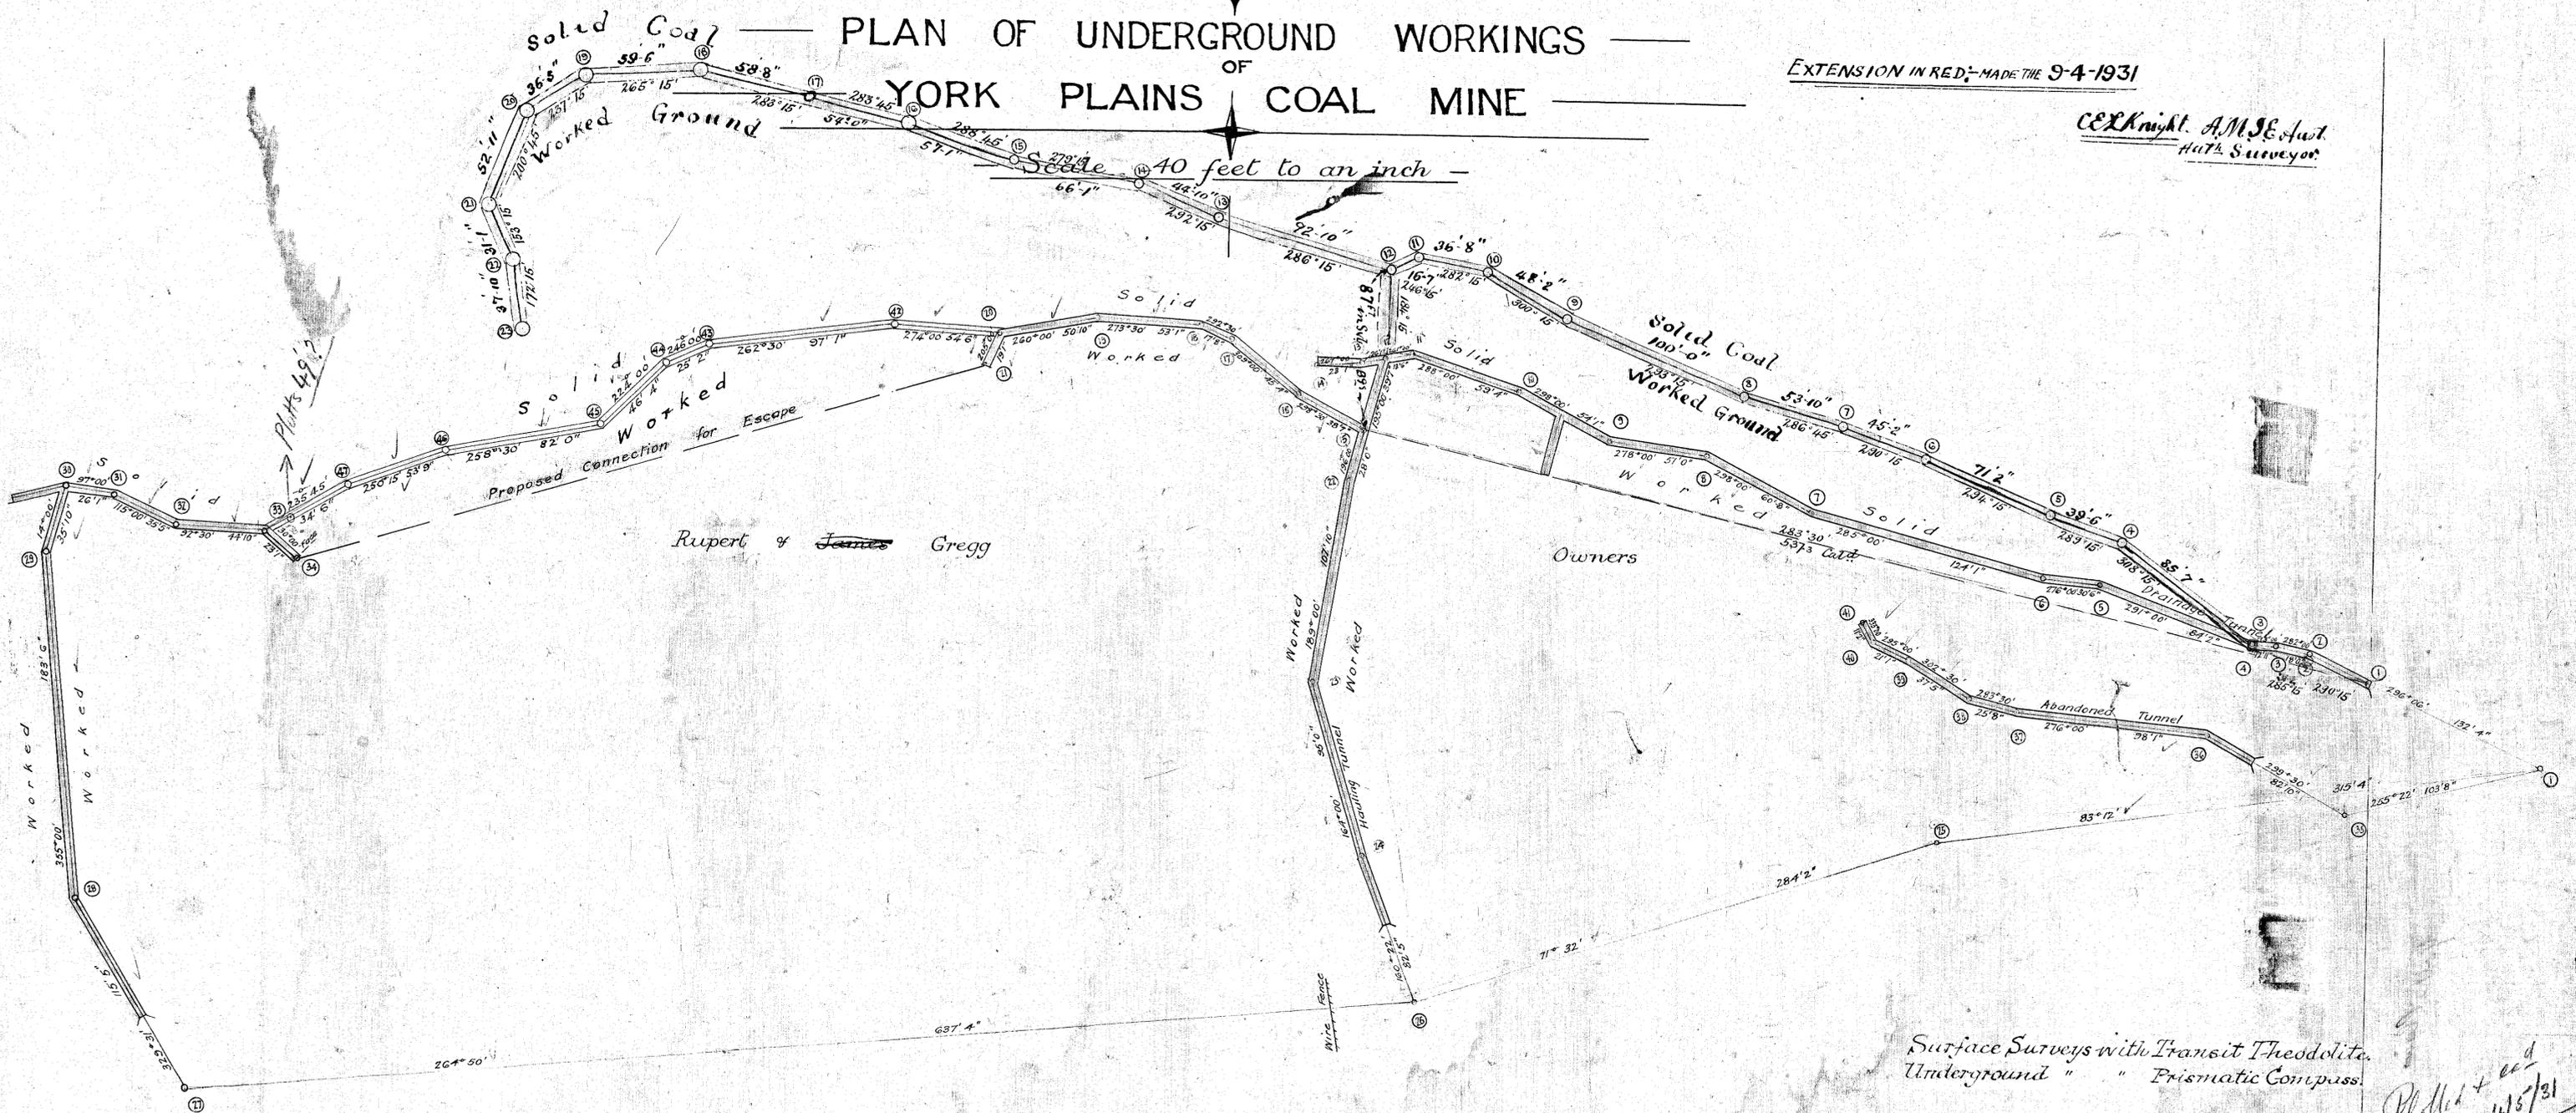

Surface Surveys with Transit Theodolite.
Underground " " Prismatic Compass.

Plotted + co'd
4/5/31

L. Adams

25-01

13/9/31
O.L.A. 10/6/31