
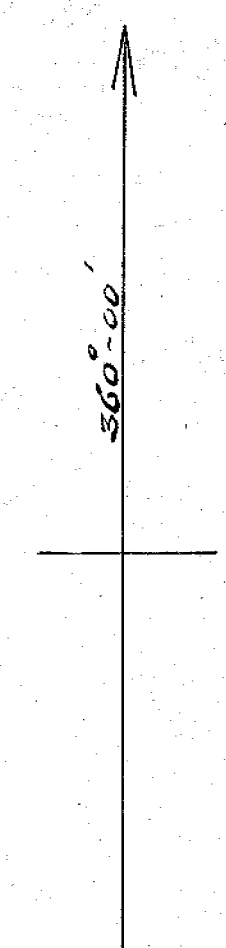


27

3211
5-2-23-24

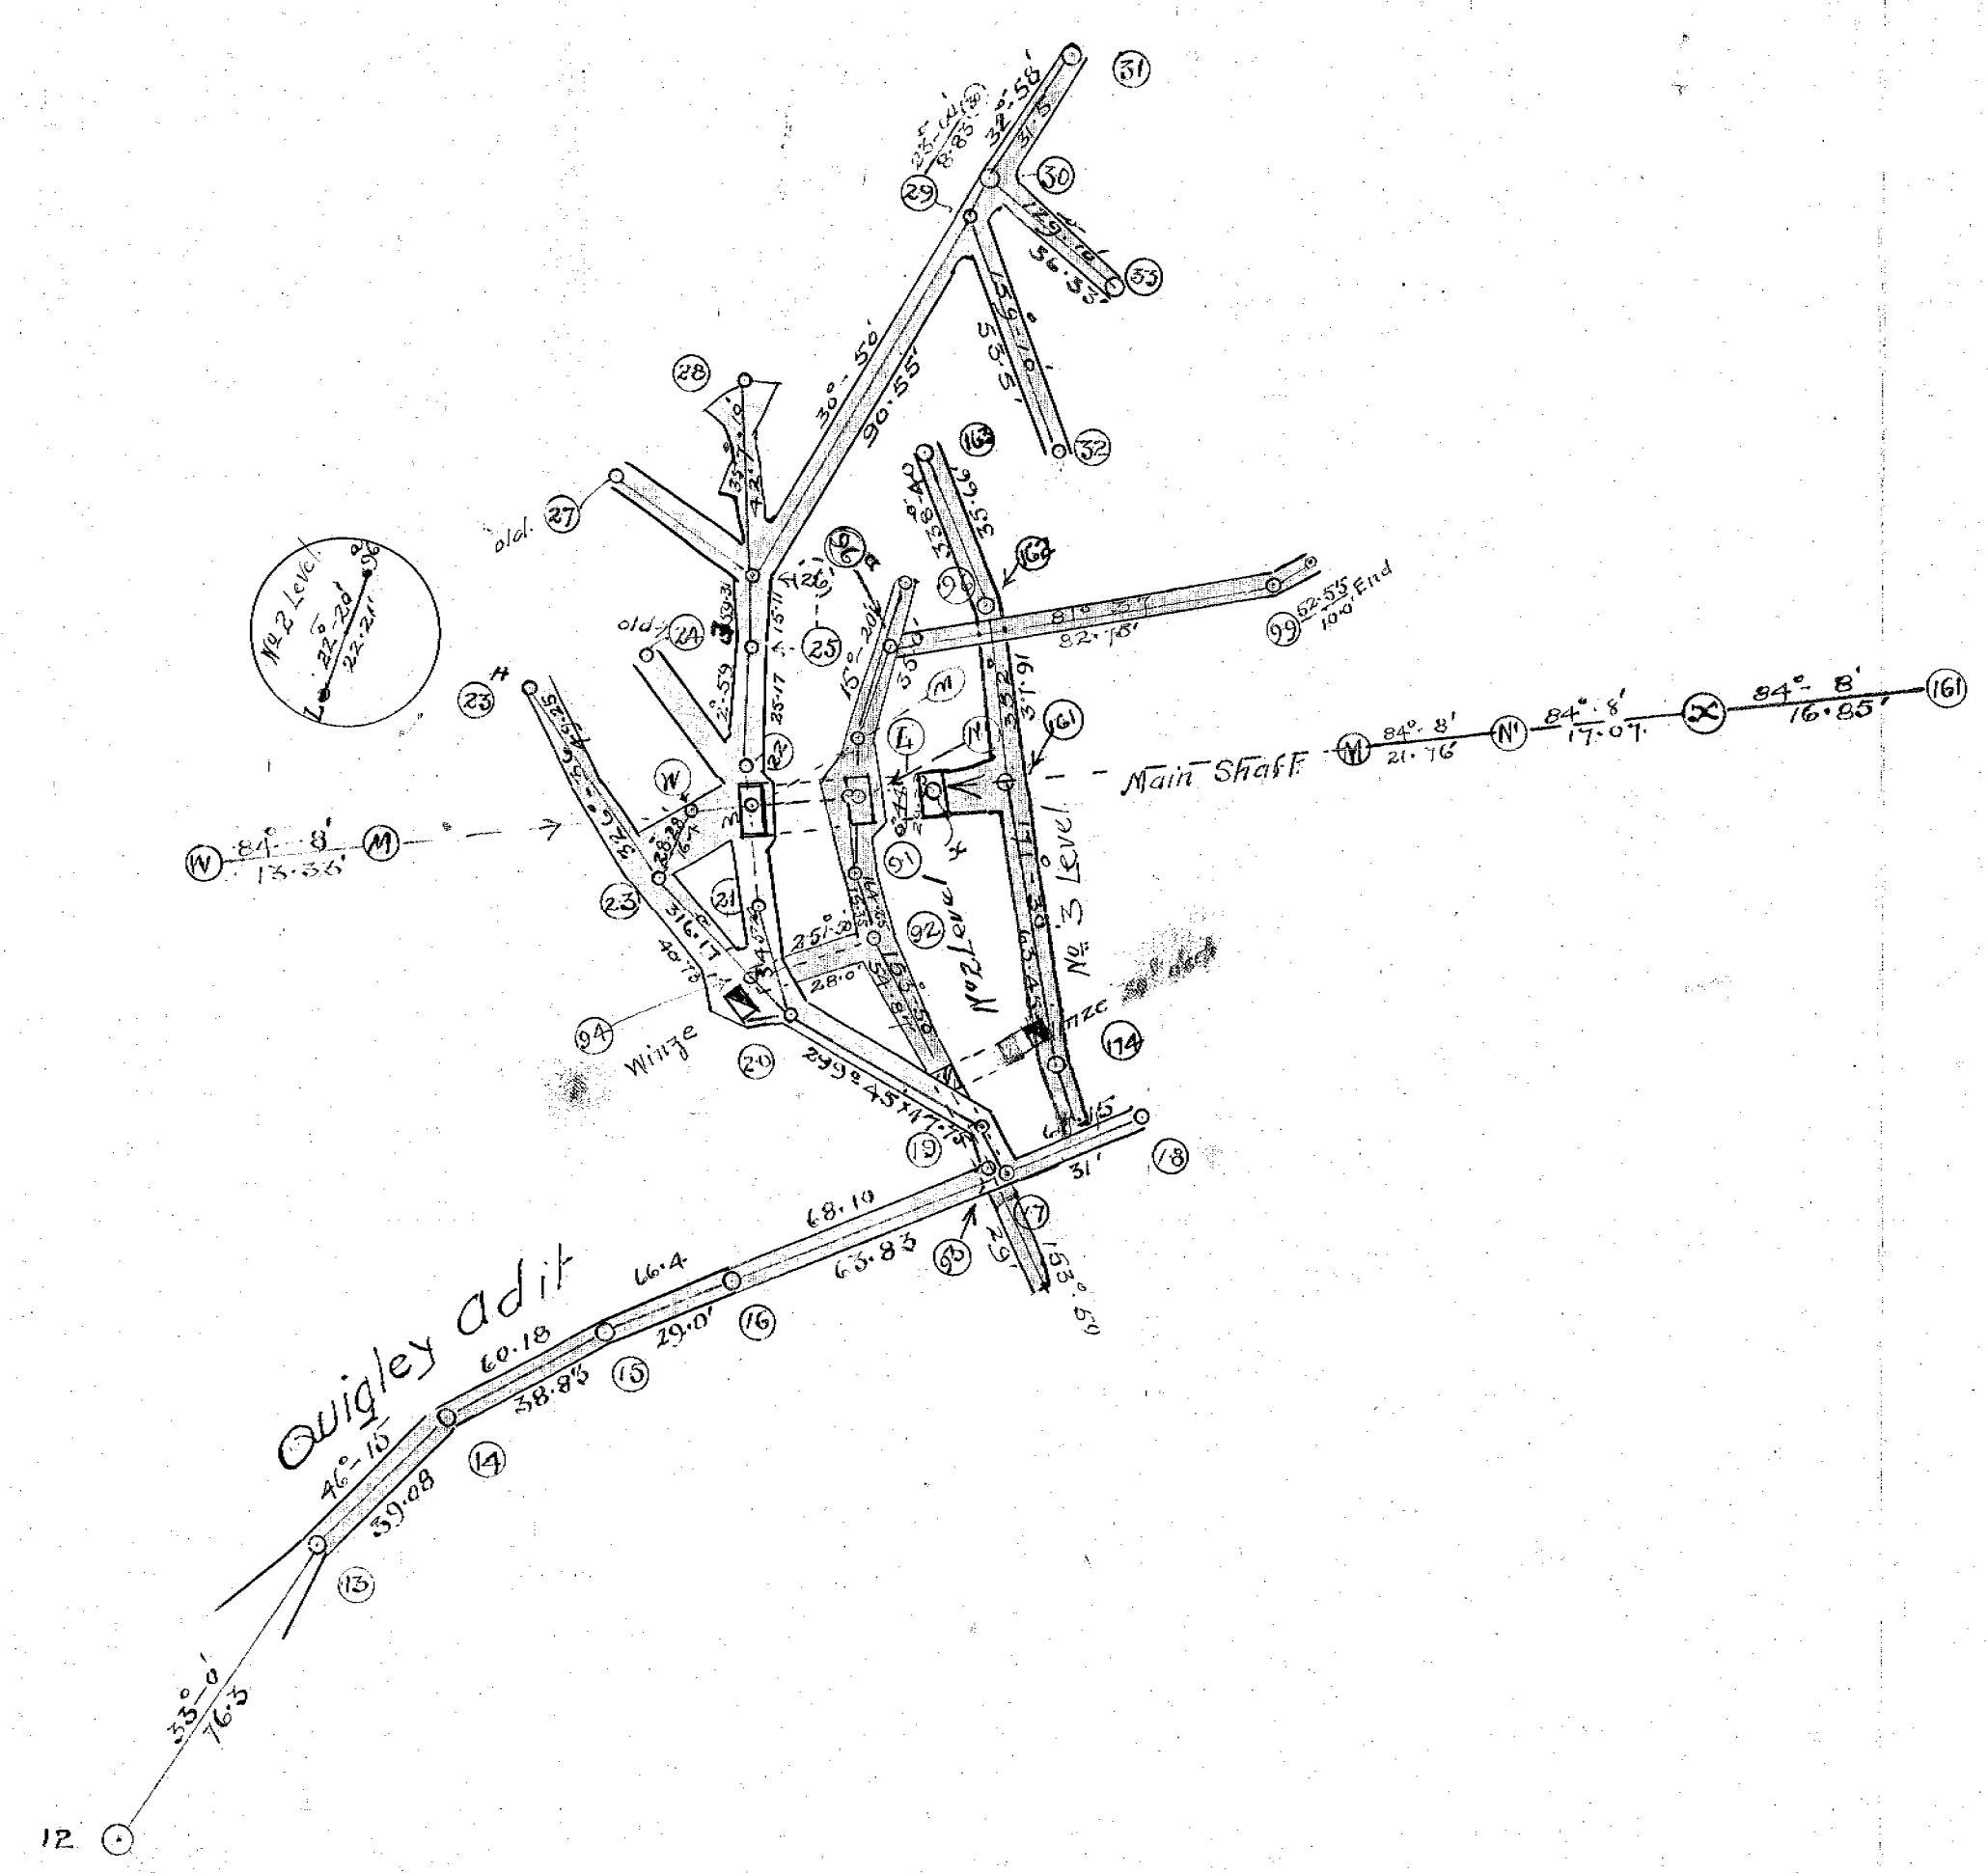


NIKE M. CO NL

SCALE - 40 FEET TO ONE INCH.

Showing work done to 31st Dec. 1918. T.B. rough




-188-67 M.-

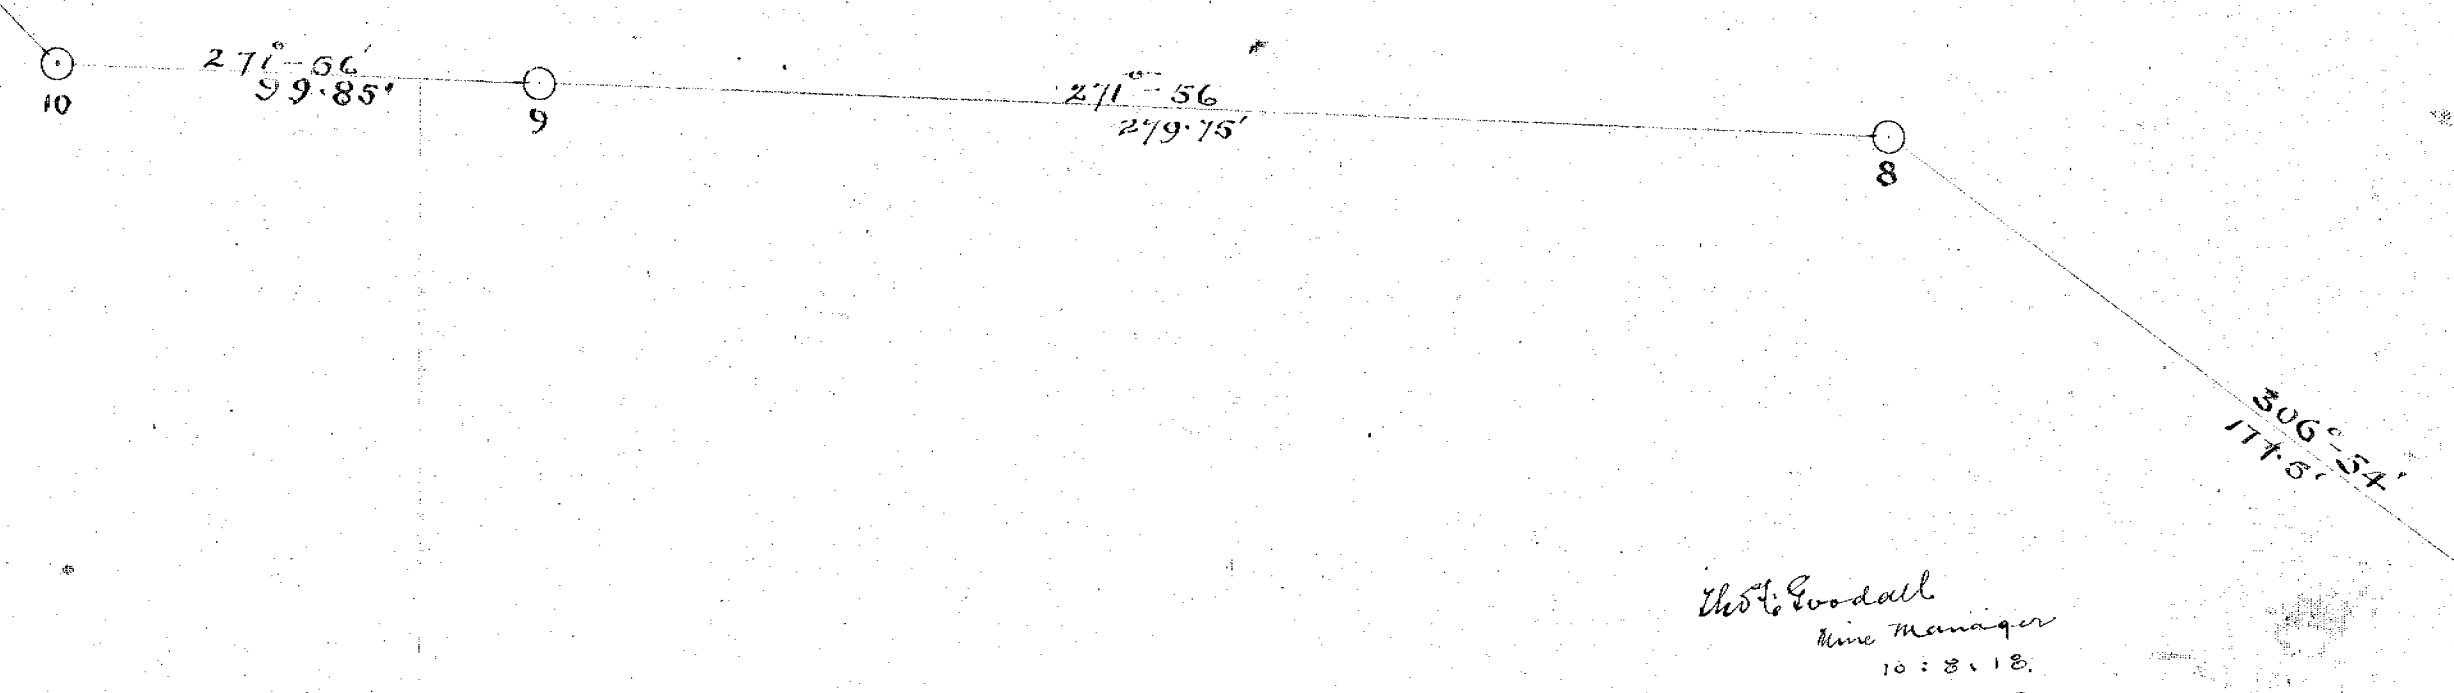

Eastern Boundary 360°-00'

Geo. Woodall
Mine Manager
10-2-18
Dec. 26-6-19

27-02

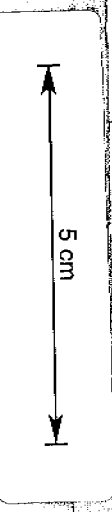

2702