
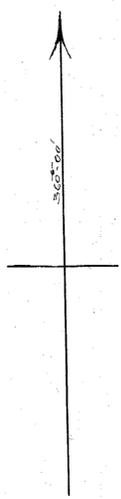


NIKE M. CO.
1917
(31)

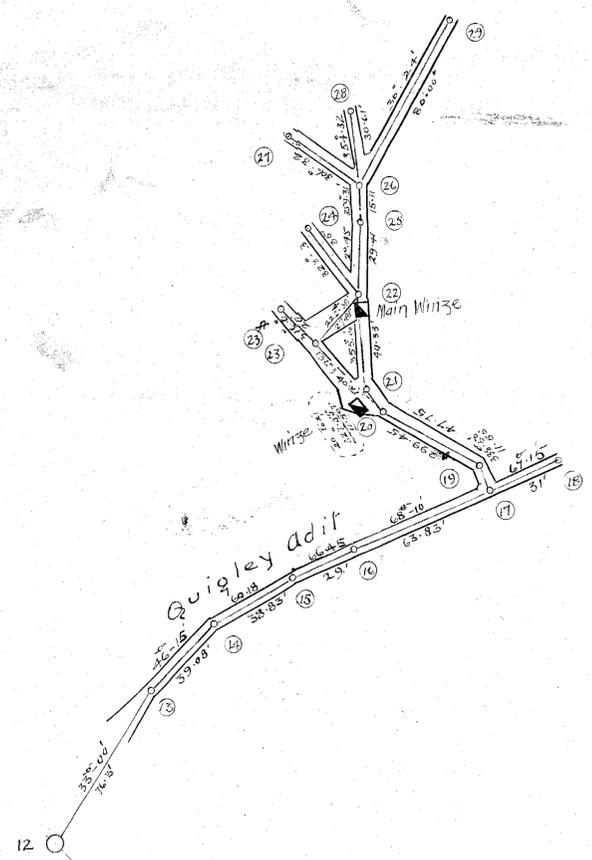


NIKE M CO NL

188
BTM

Scale 40^{FT} to one inch

Plan of Adit Workings to 31-12-16

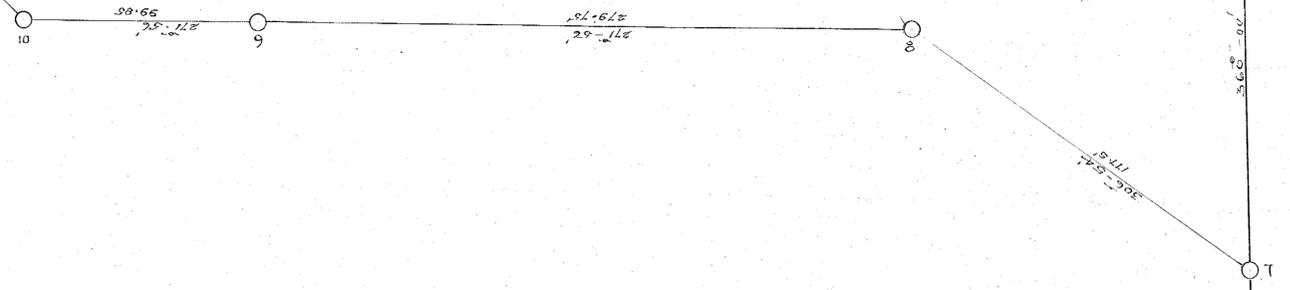

Thos. Goodall
Mine Manager
28th Aug 1917