


5 cm

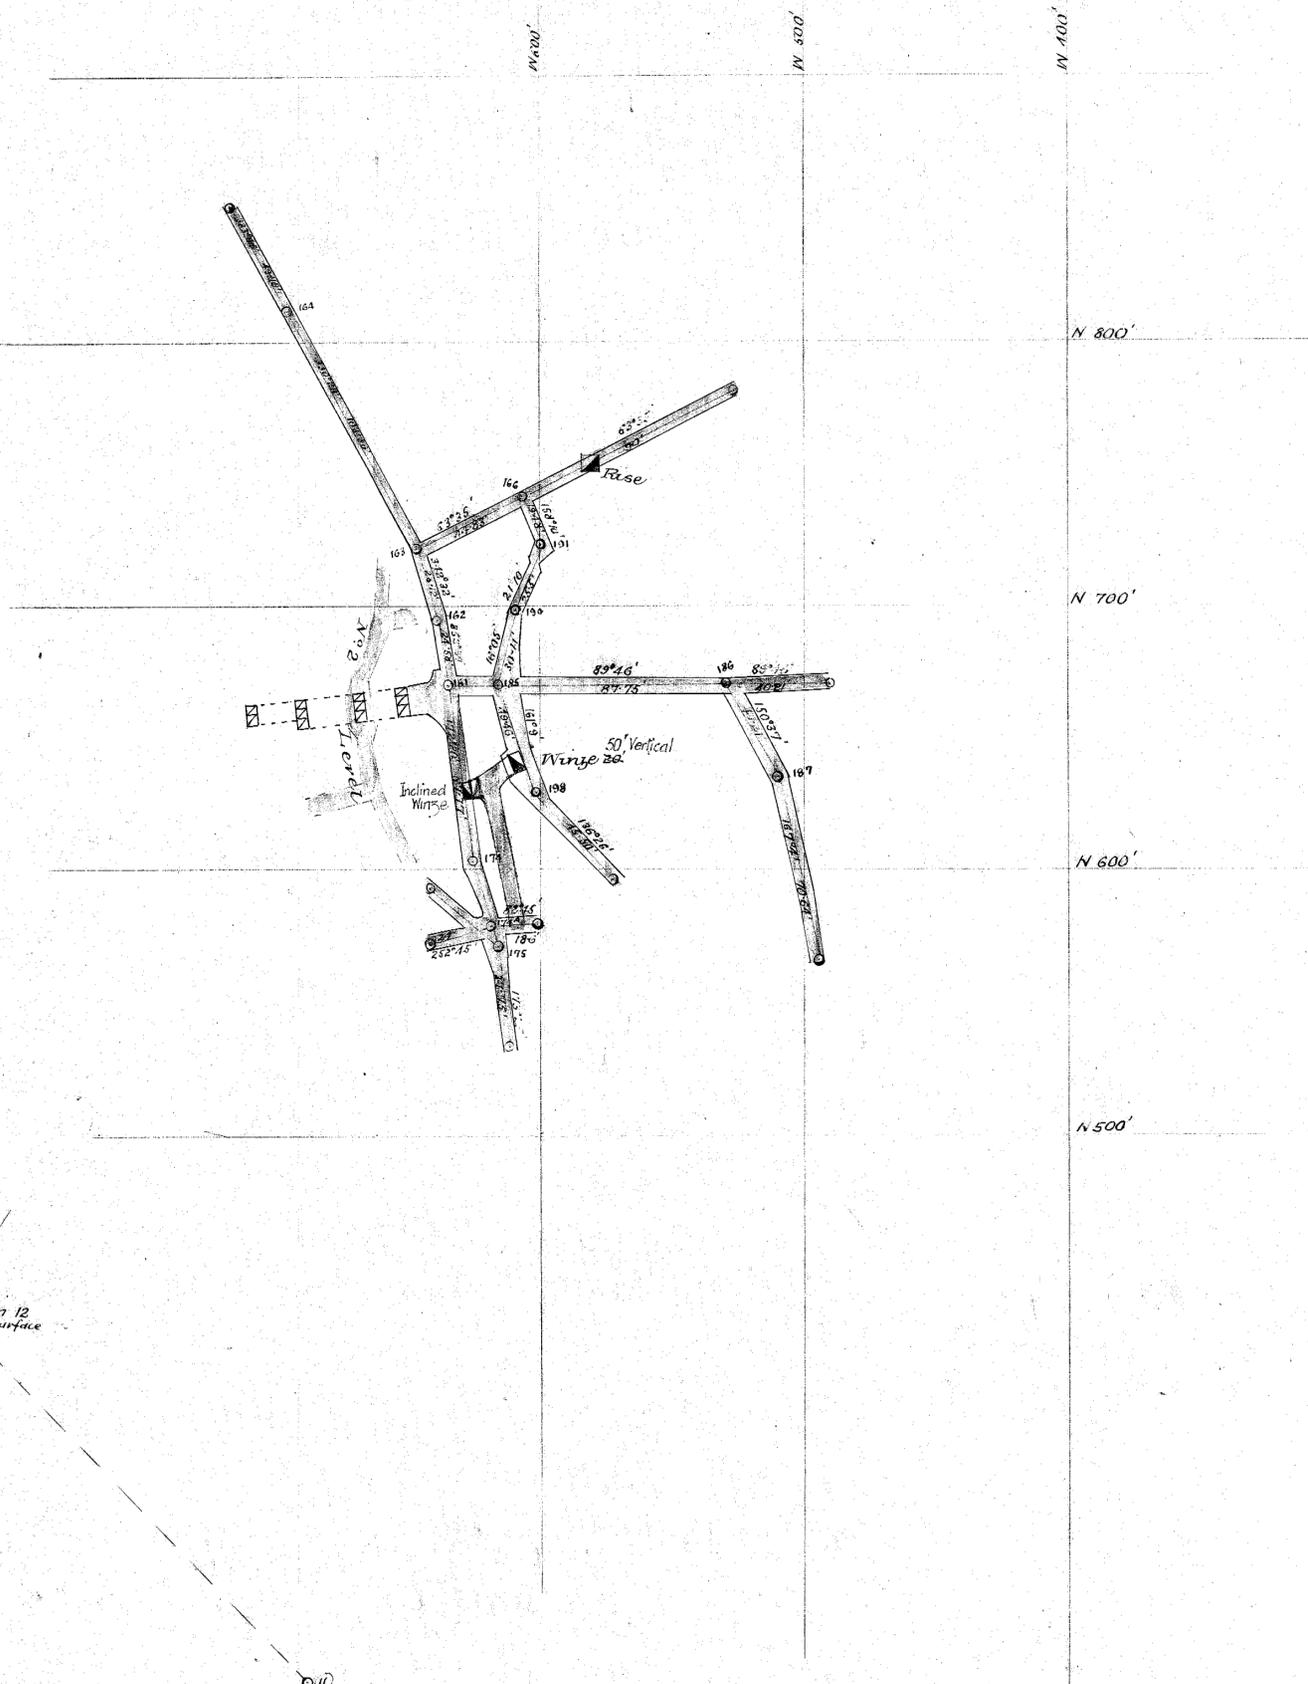

Station 12 on surface

NIKE-M.CO N.L.

Scale 40 feet to an inch

REFERENCE

Nº 2 LEVEL	
" 3 "	
" 4 "	

APPROXIMATE

27-04