
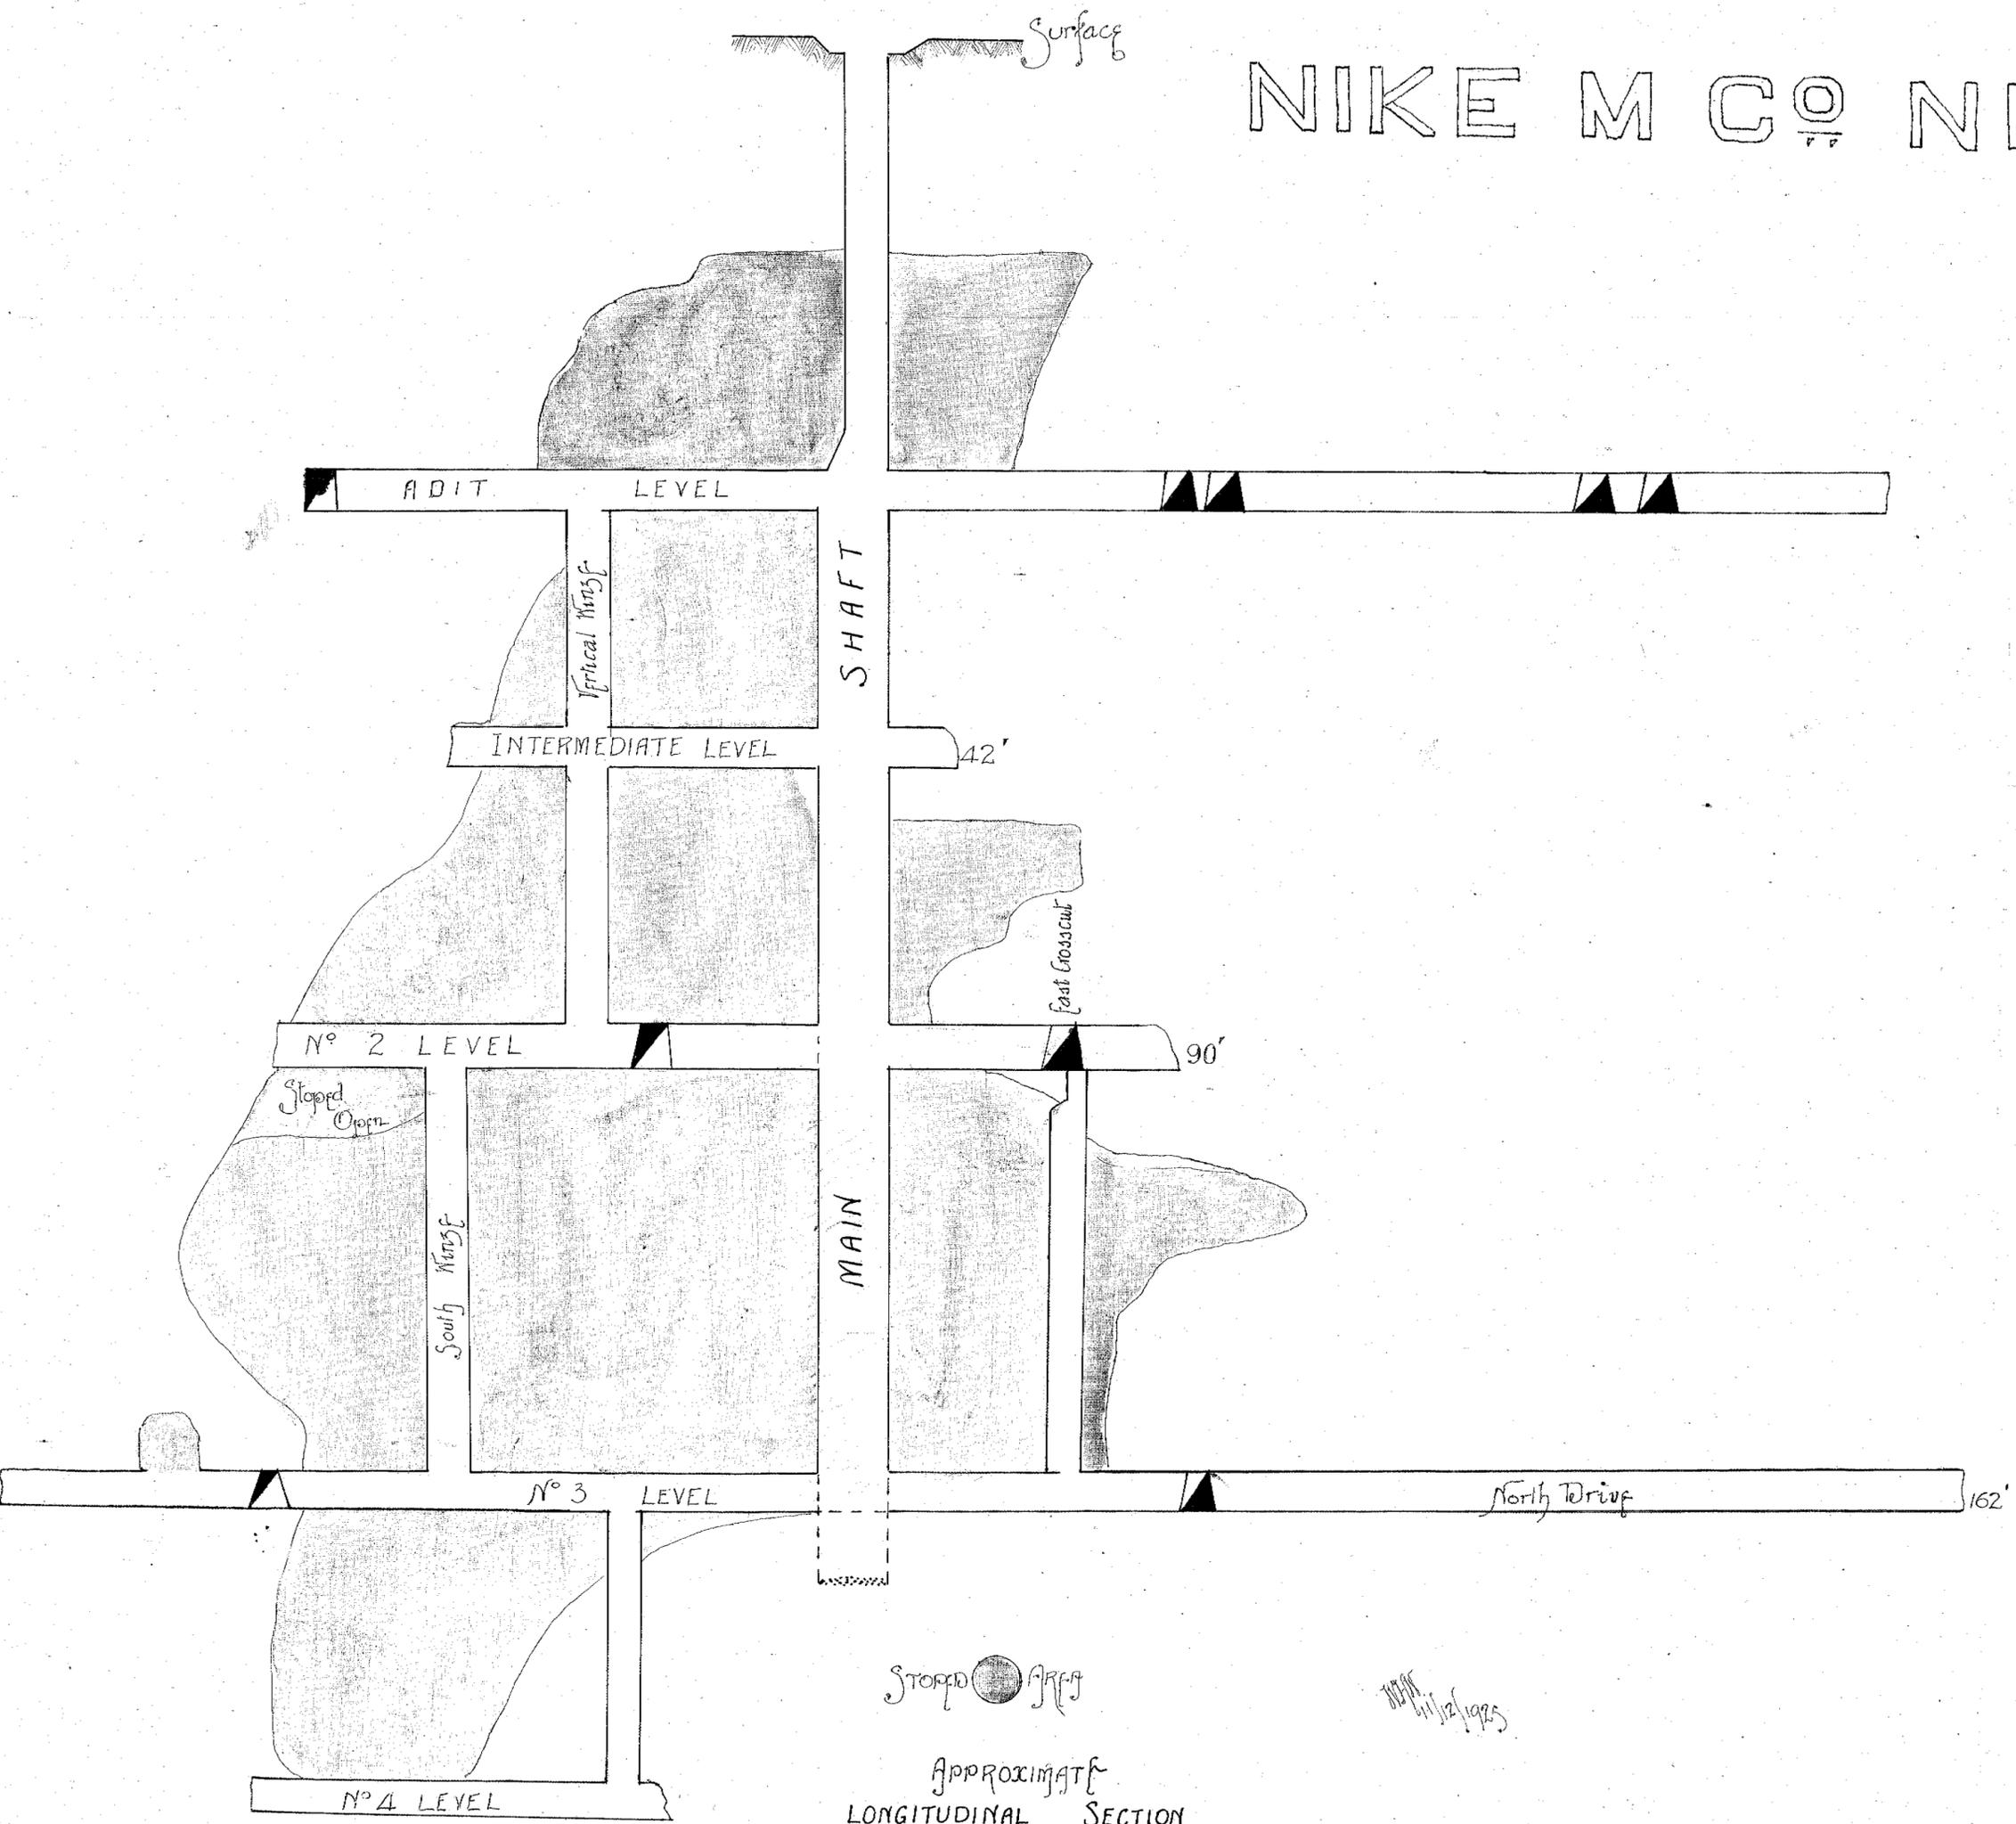


NIKE M CO NL

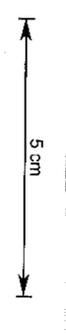

STOPPED AREA

MAP 11/12/1925

APPROXIMATE
LONGITUDINAL SECTION
MAIN LOW WORKINGS
About 20" = 1"

27-06

27-06