
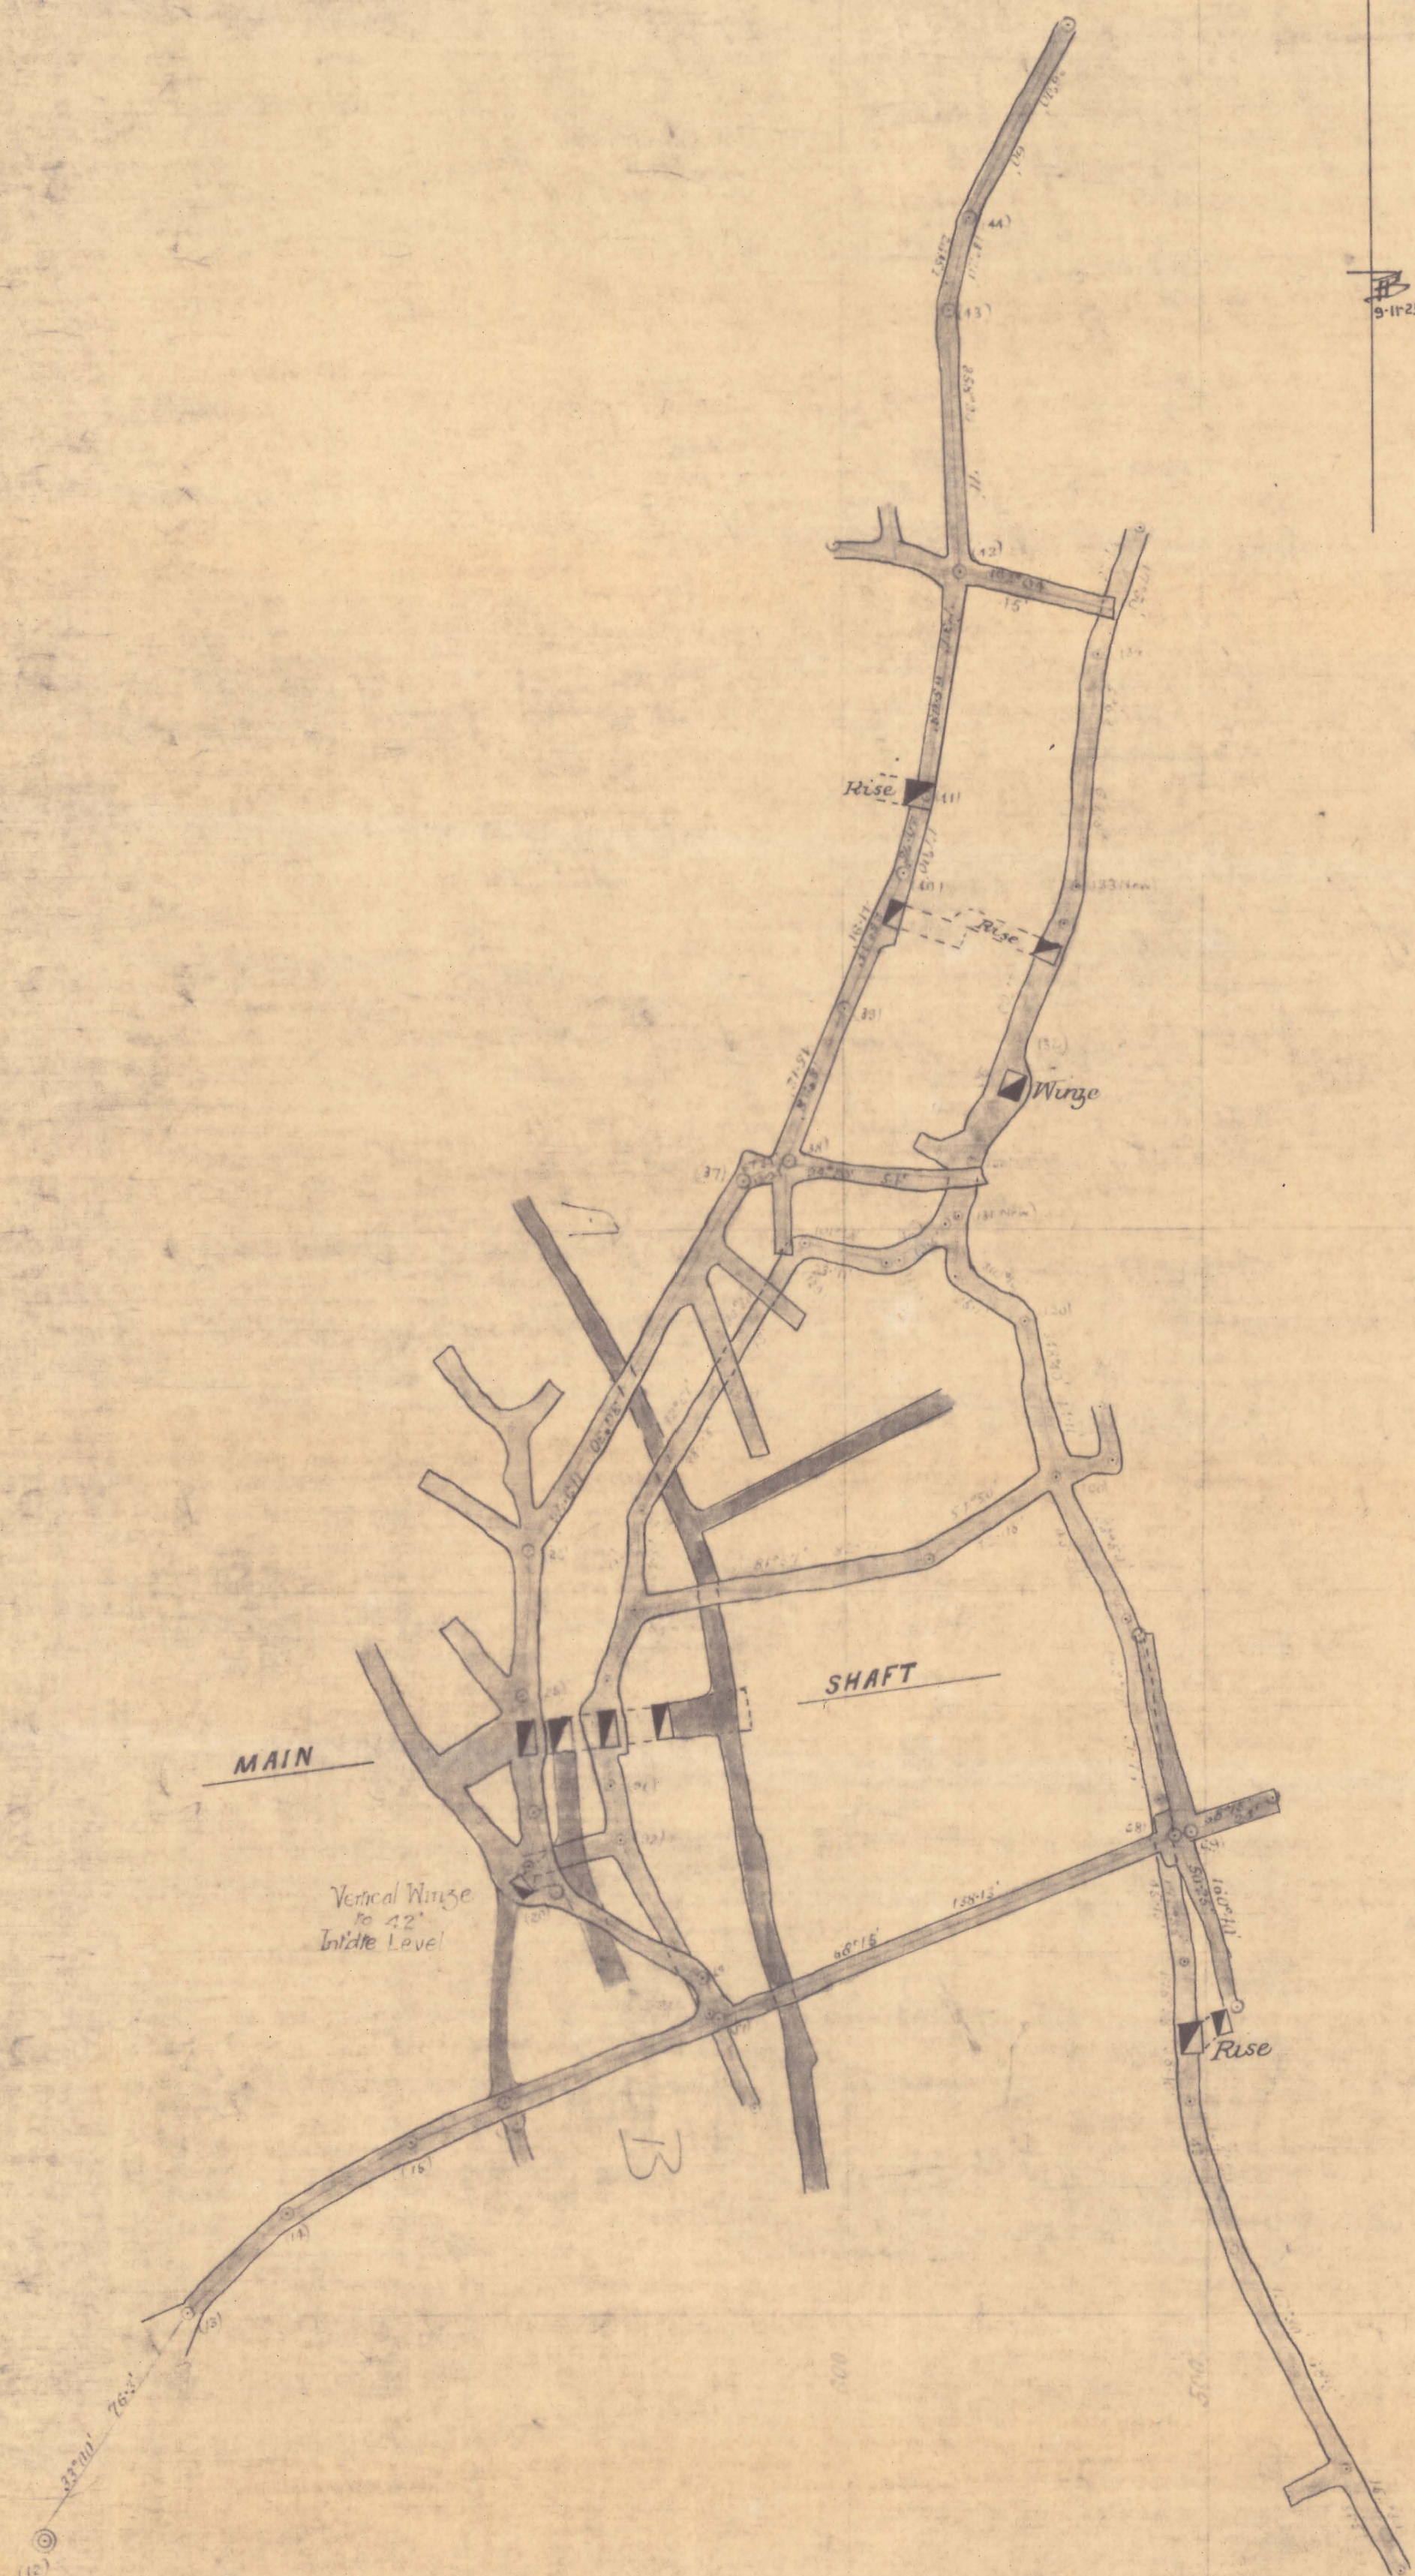


NIKE M. CO. N.L.

SCALE — 40 FEET TO ONE INCH —

Showing Extensions to 31st Dec. 1920

5 cm
0027-008

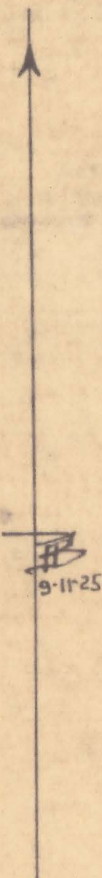

CONSOLIDATED LEASE

— N^o 7456 —
— M —

REFERENCE

N ^o	LEVEL
INTOTE	" 1 "
" 2 "	" 2 "
INTOTE	" 3 "

Eastern Boundary