




5 cm

# MT BALFOUR MURRAY'S REWARD SECTION

555

Murray's Reward

## No 3 TUNNEL (36)

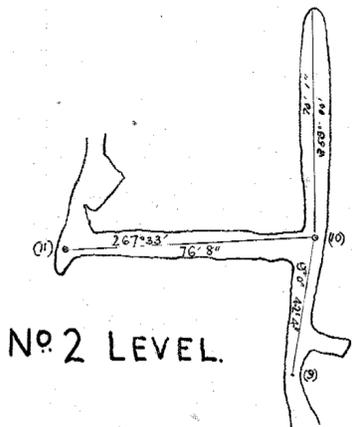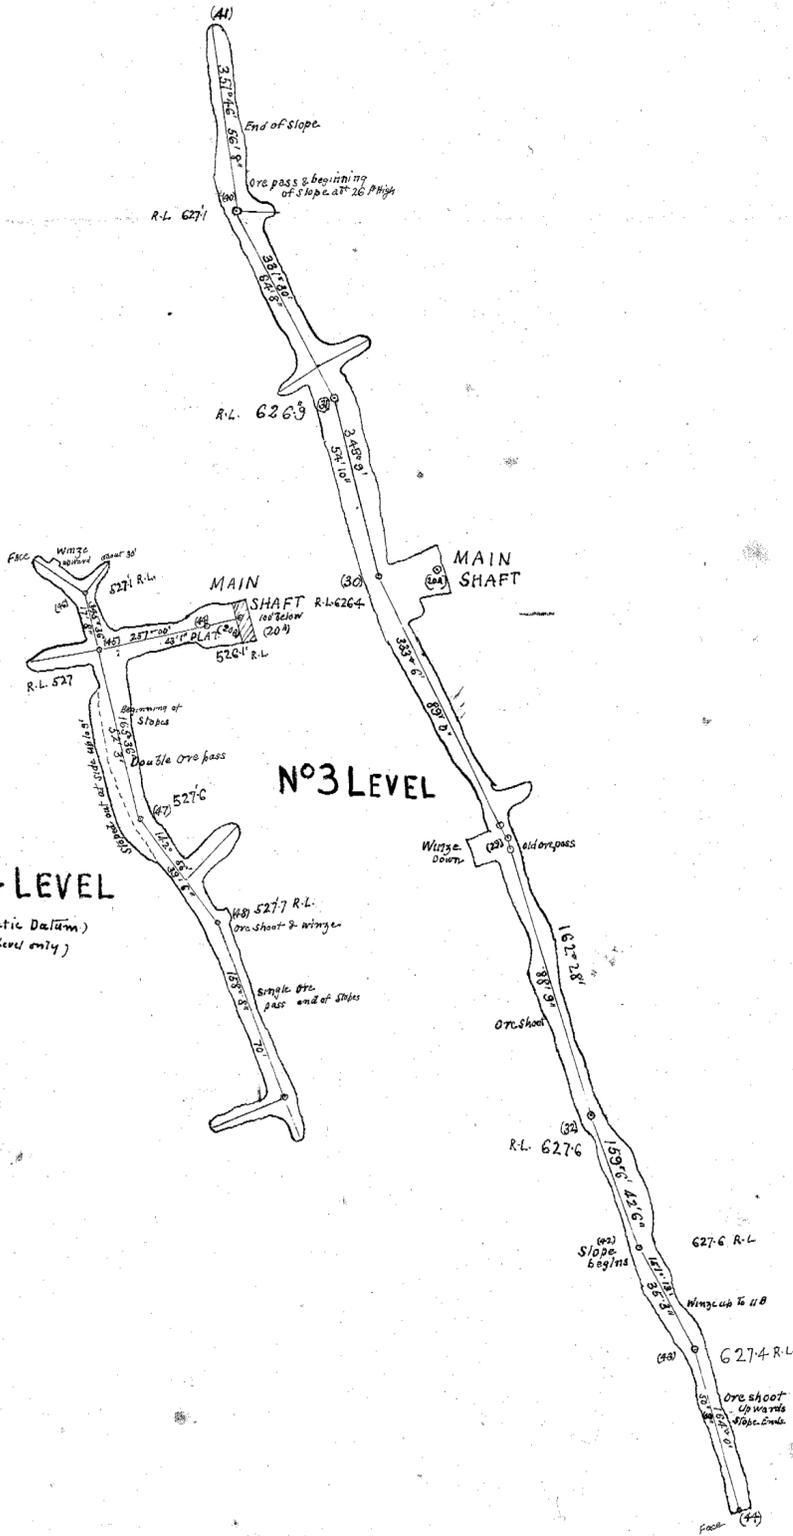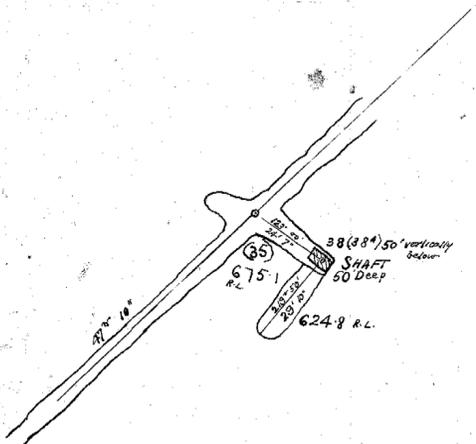

## No 2 LEVEL.



Scale 40 feet to an inch

Additional workings

Surveyed 10<sup>th</sup> & 11<sup>th</sup> April 1912

28-01

J. H. Harrison  
Mining Surveyor