
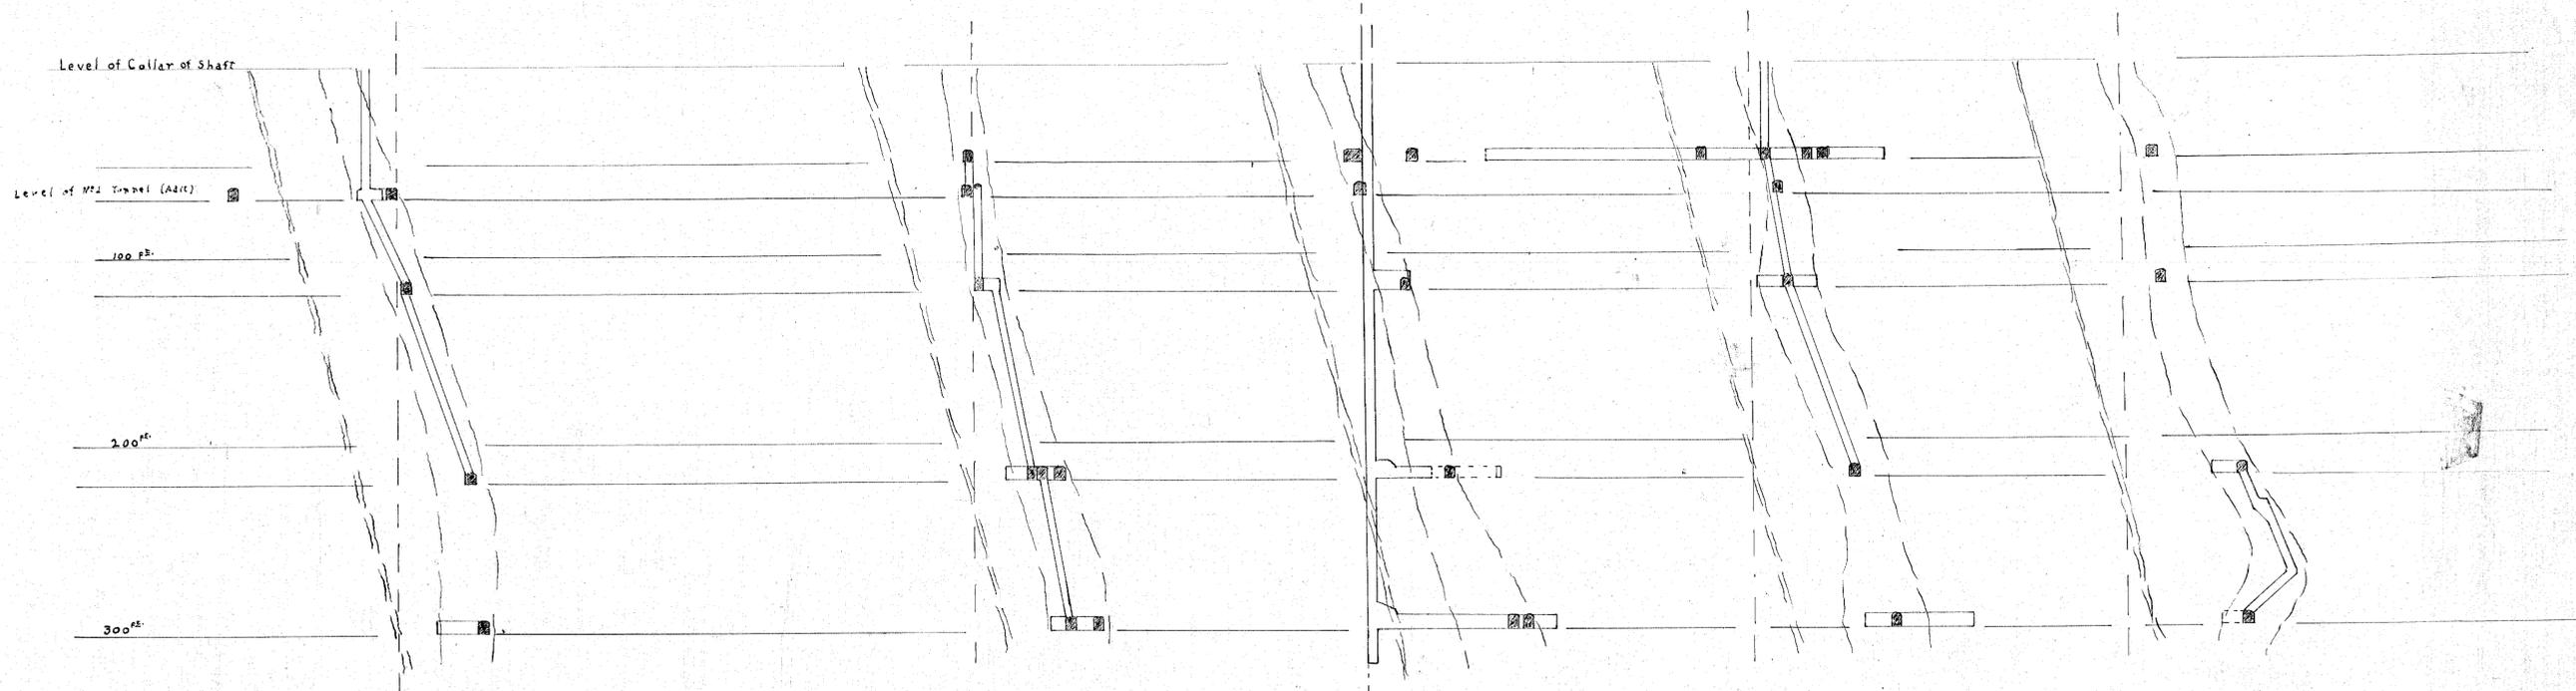


TRANSVERSE SECTIONS
 COPPER REWARD MINE
 MT. BALEOUR
 Scale 1" to 40'


Handwritten notes:
 28-04
 Copper Reward Mine
 Mt. Baleour

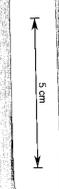

LONGITUDINAL SECTION

Scale 1" to 40'
 Date: 24 May 1911.

Broken Red Lines Indicate Walls of Lode

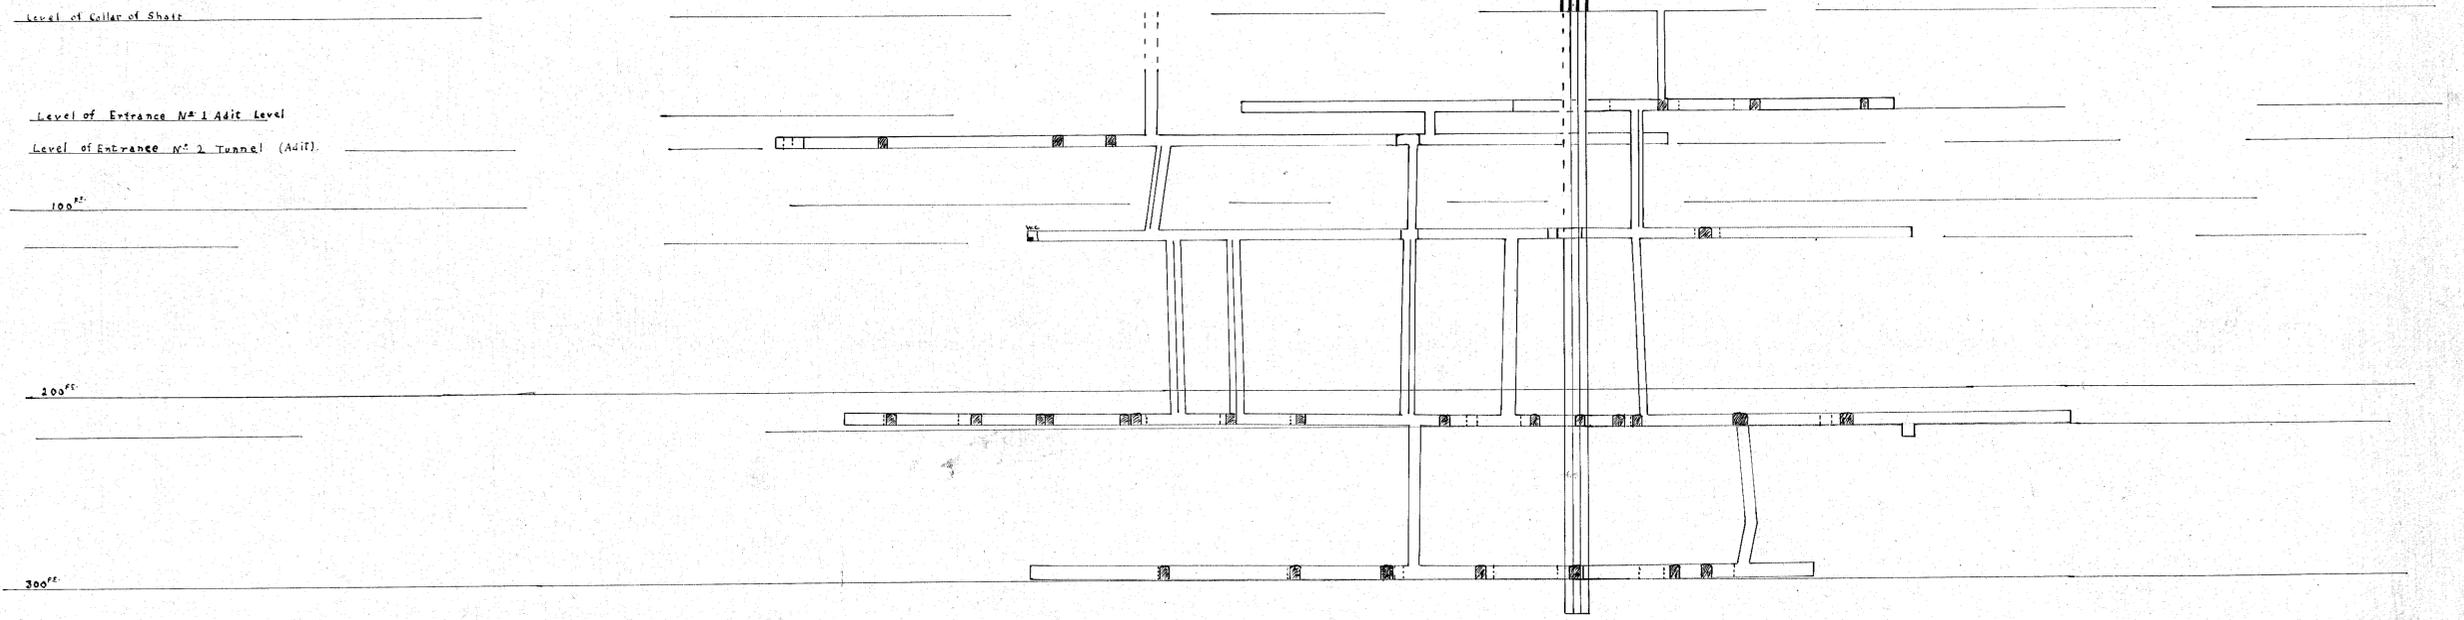

Tracings made by

28-04

Handwritten signature: W. J. Clark D.S. T.
 555

28-04