
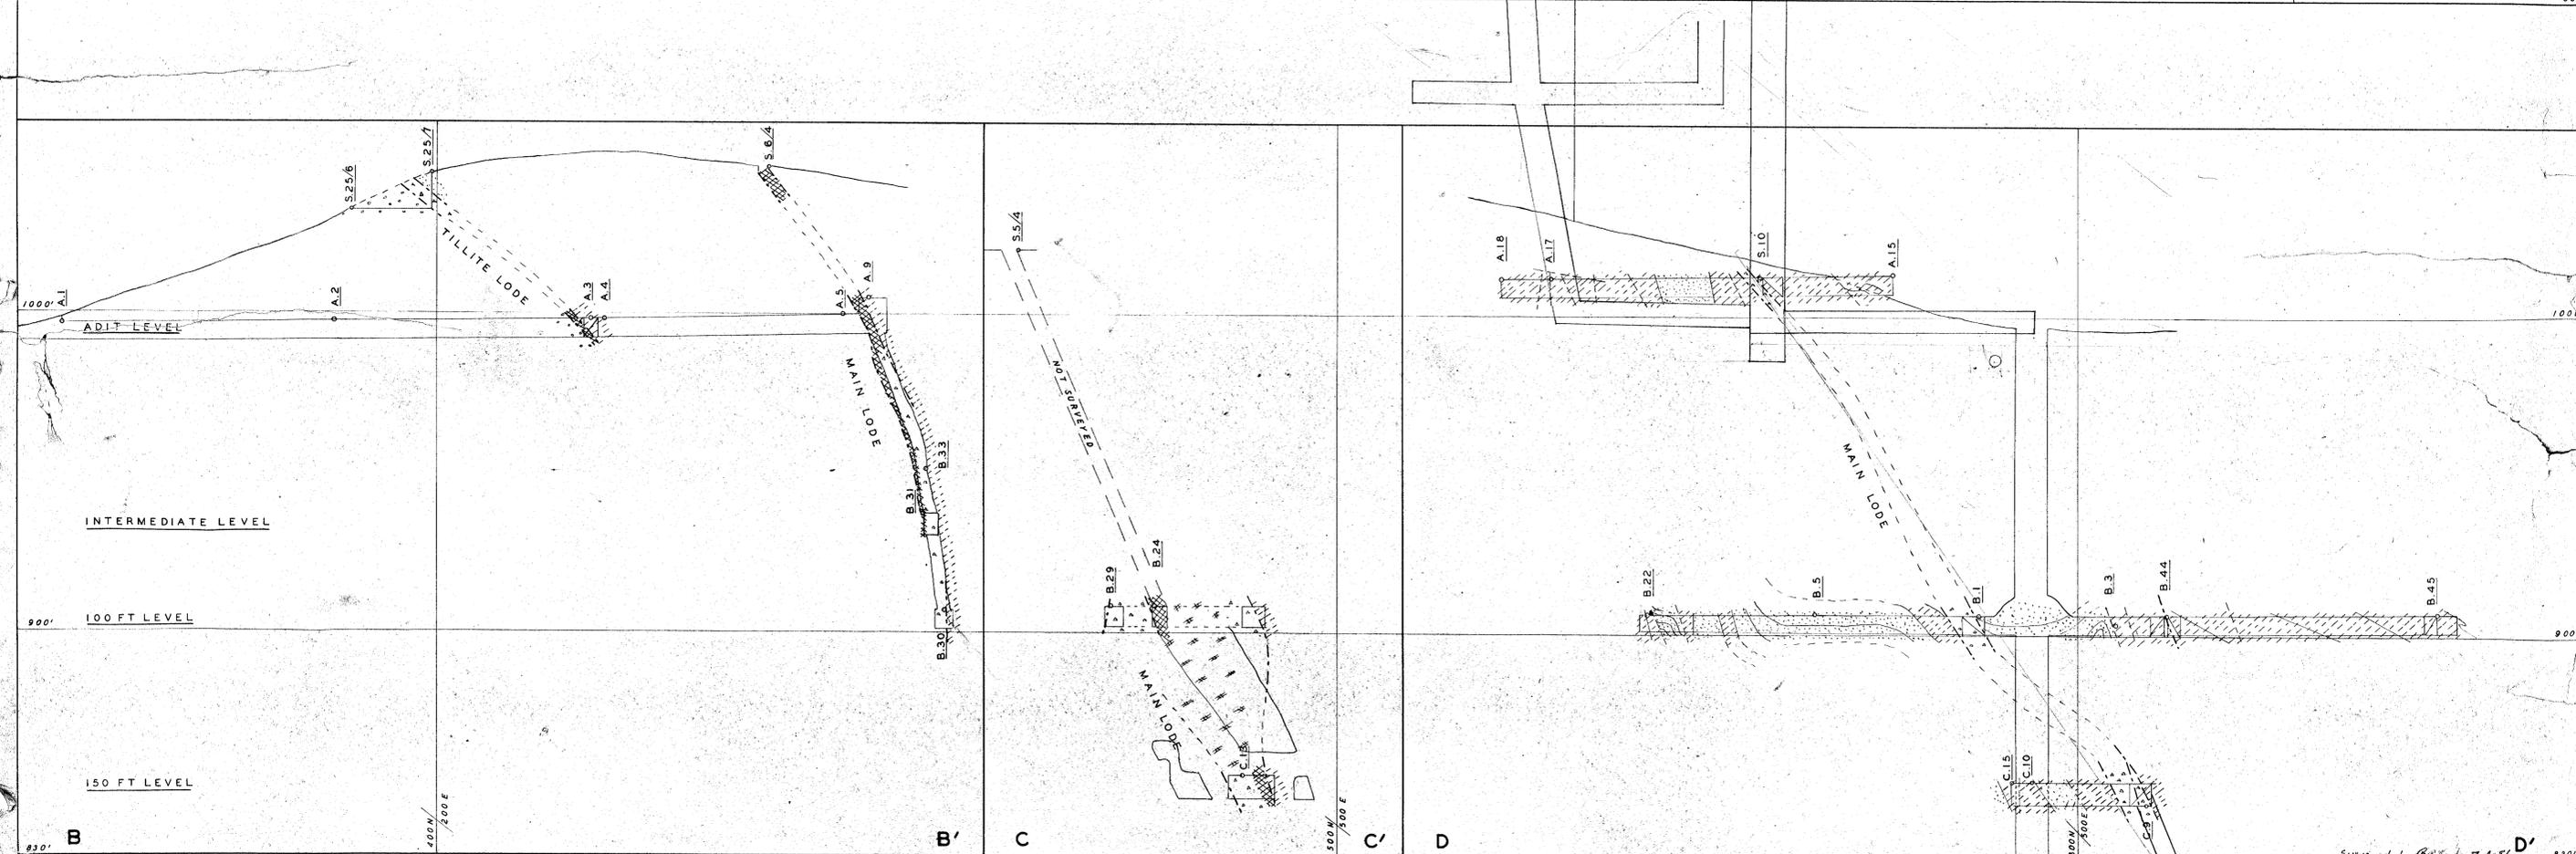


**LEGEND**

- TILLITE
- SHALE
- QUARTZITE
- SURVEY STATION
- WALL OF LODE
- LODE FILLING
- MINERALISED ZONE
- PROBABLE MIN. ZONE

B.S.C. N.Z. A.M.A.I.M.M. ZEEHAN  
 16 NOVEMBER 1951

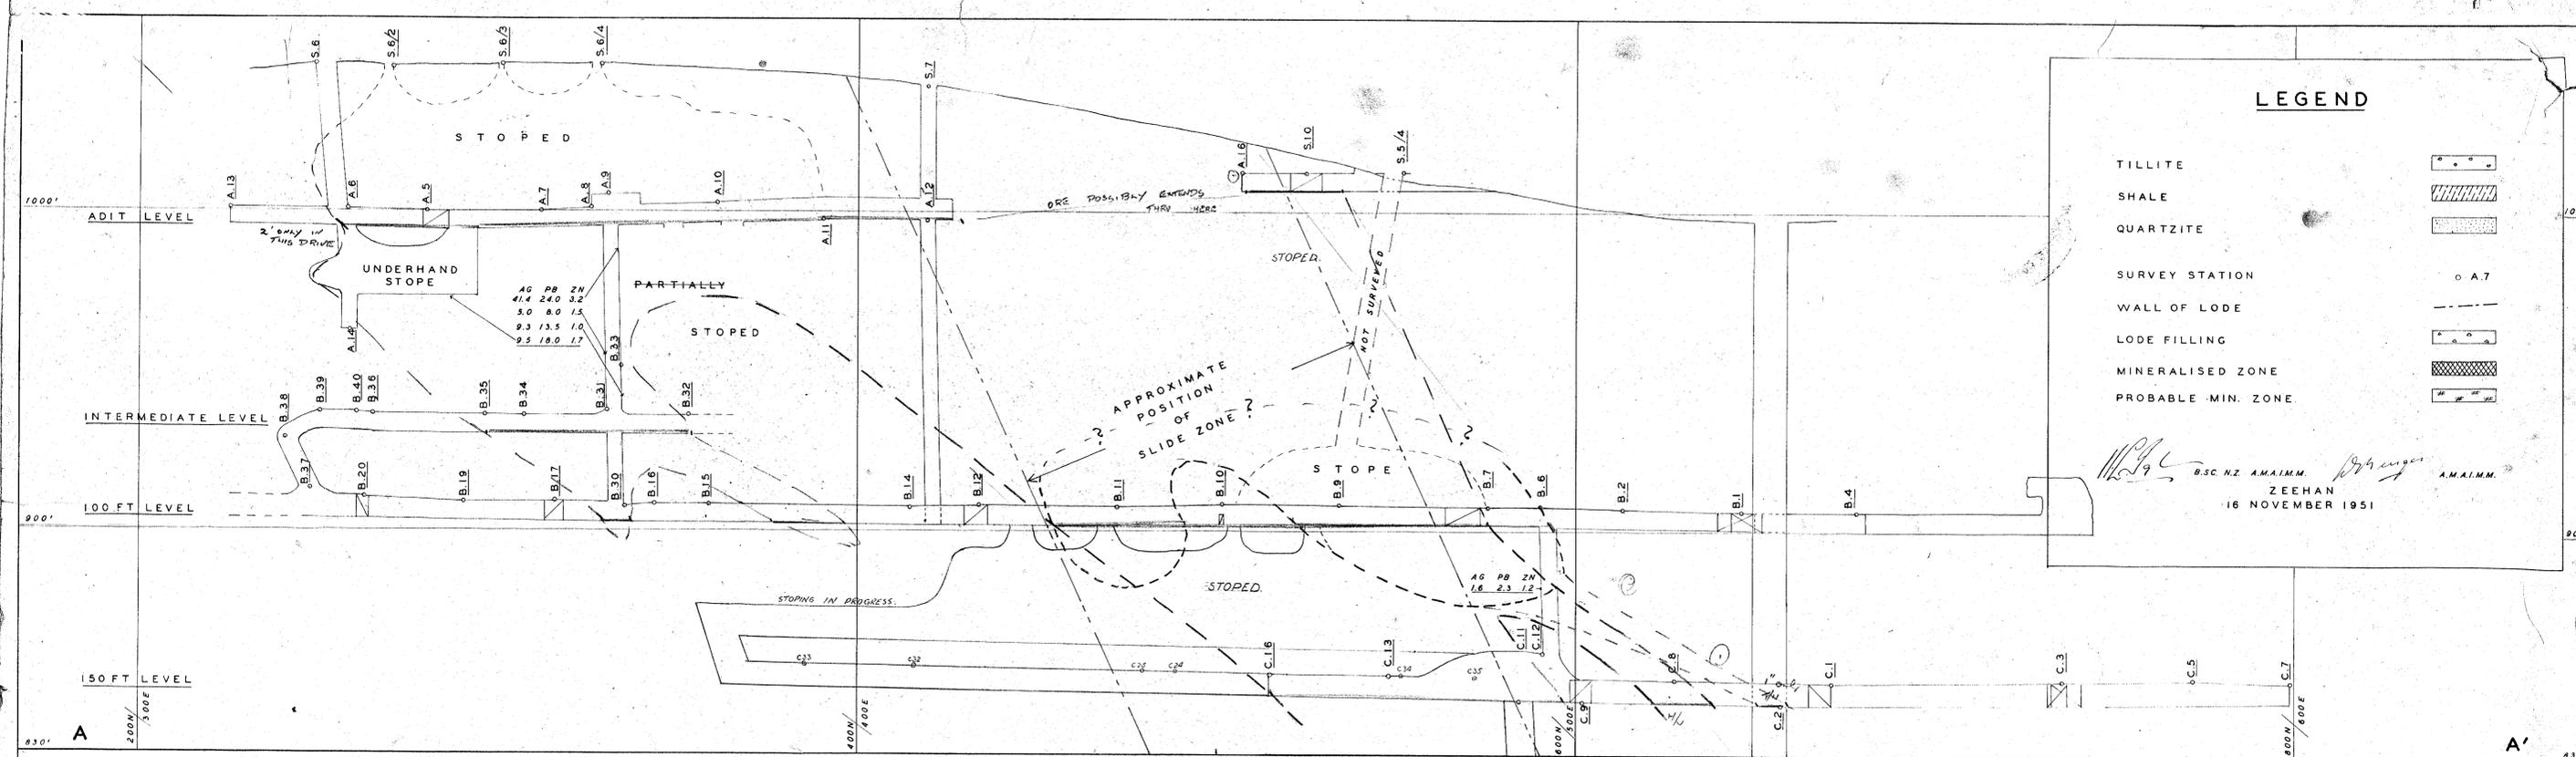

SCALE  
 1 IN = 20 FT  
 BEARINGS  
 MAGNETIC

**MONTANA SILVER-LEAD MINE**  
**LONG & CROSS SECTIONS**  
 DEPARTMENT OF MINES - TASMANIA

Surveyed by B.A. 7.4.56  
 PLAN NO  
 1222-50  
 29-02