


5 cm

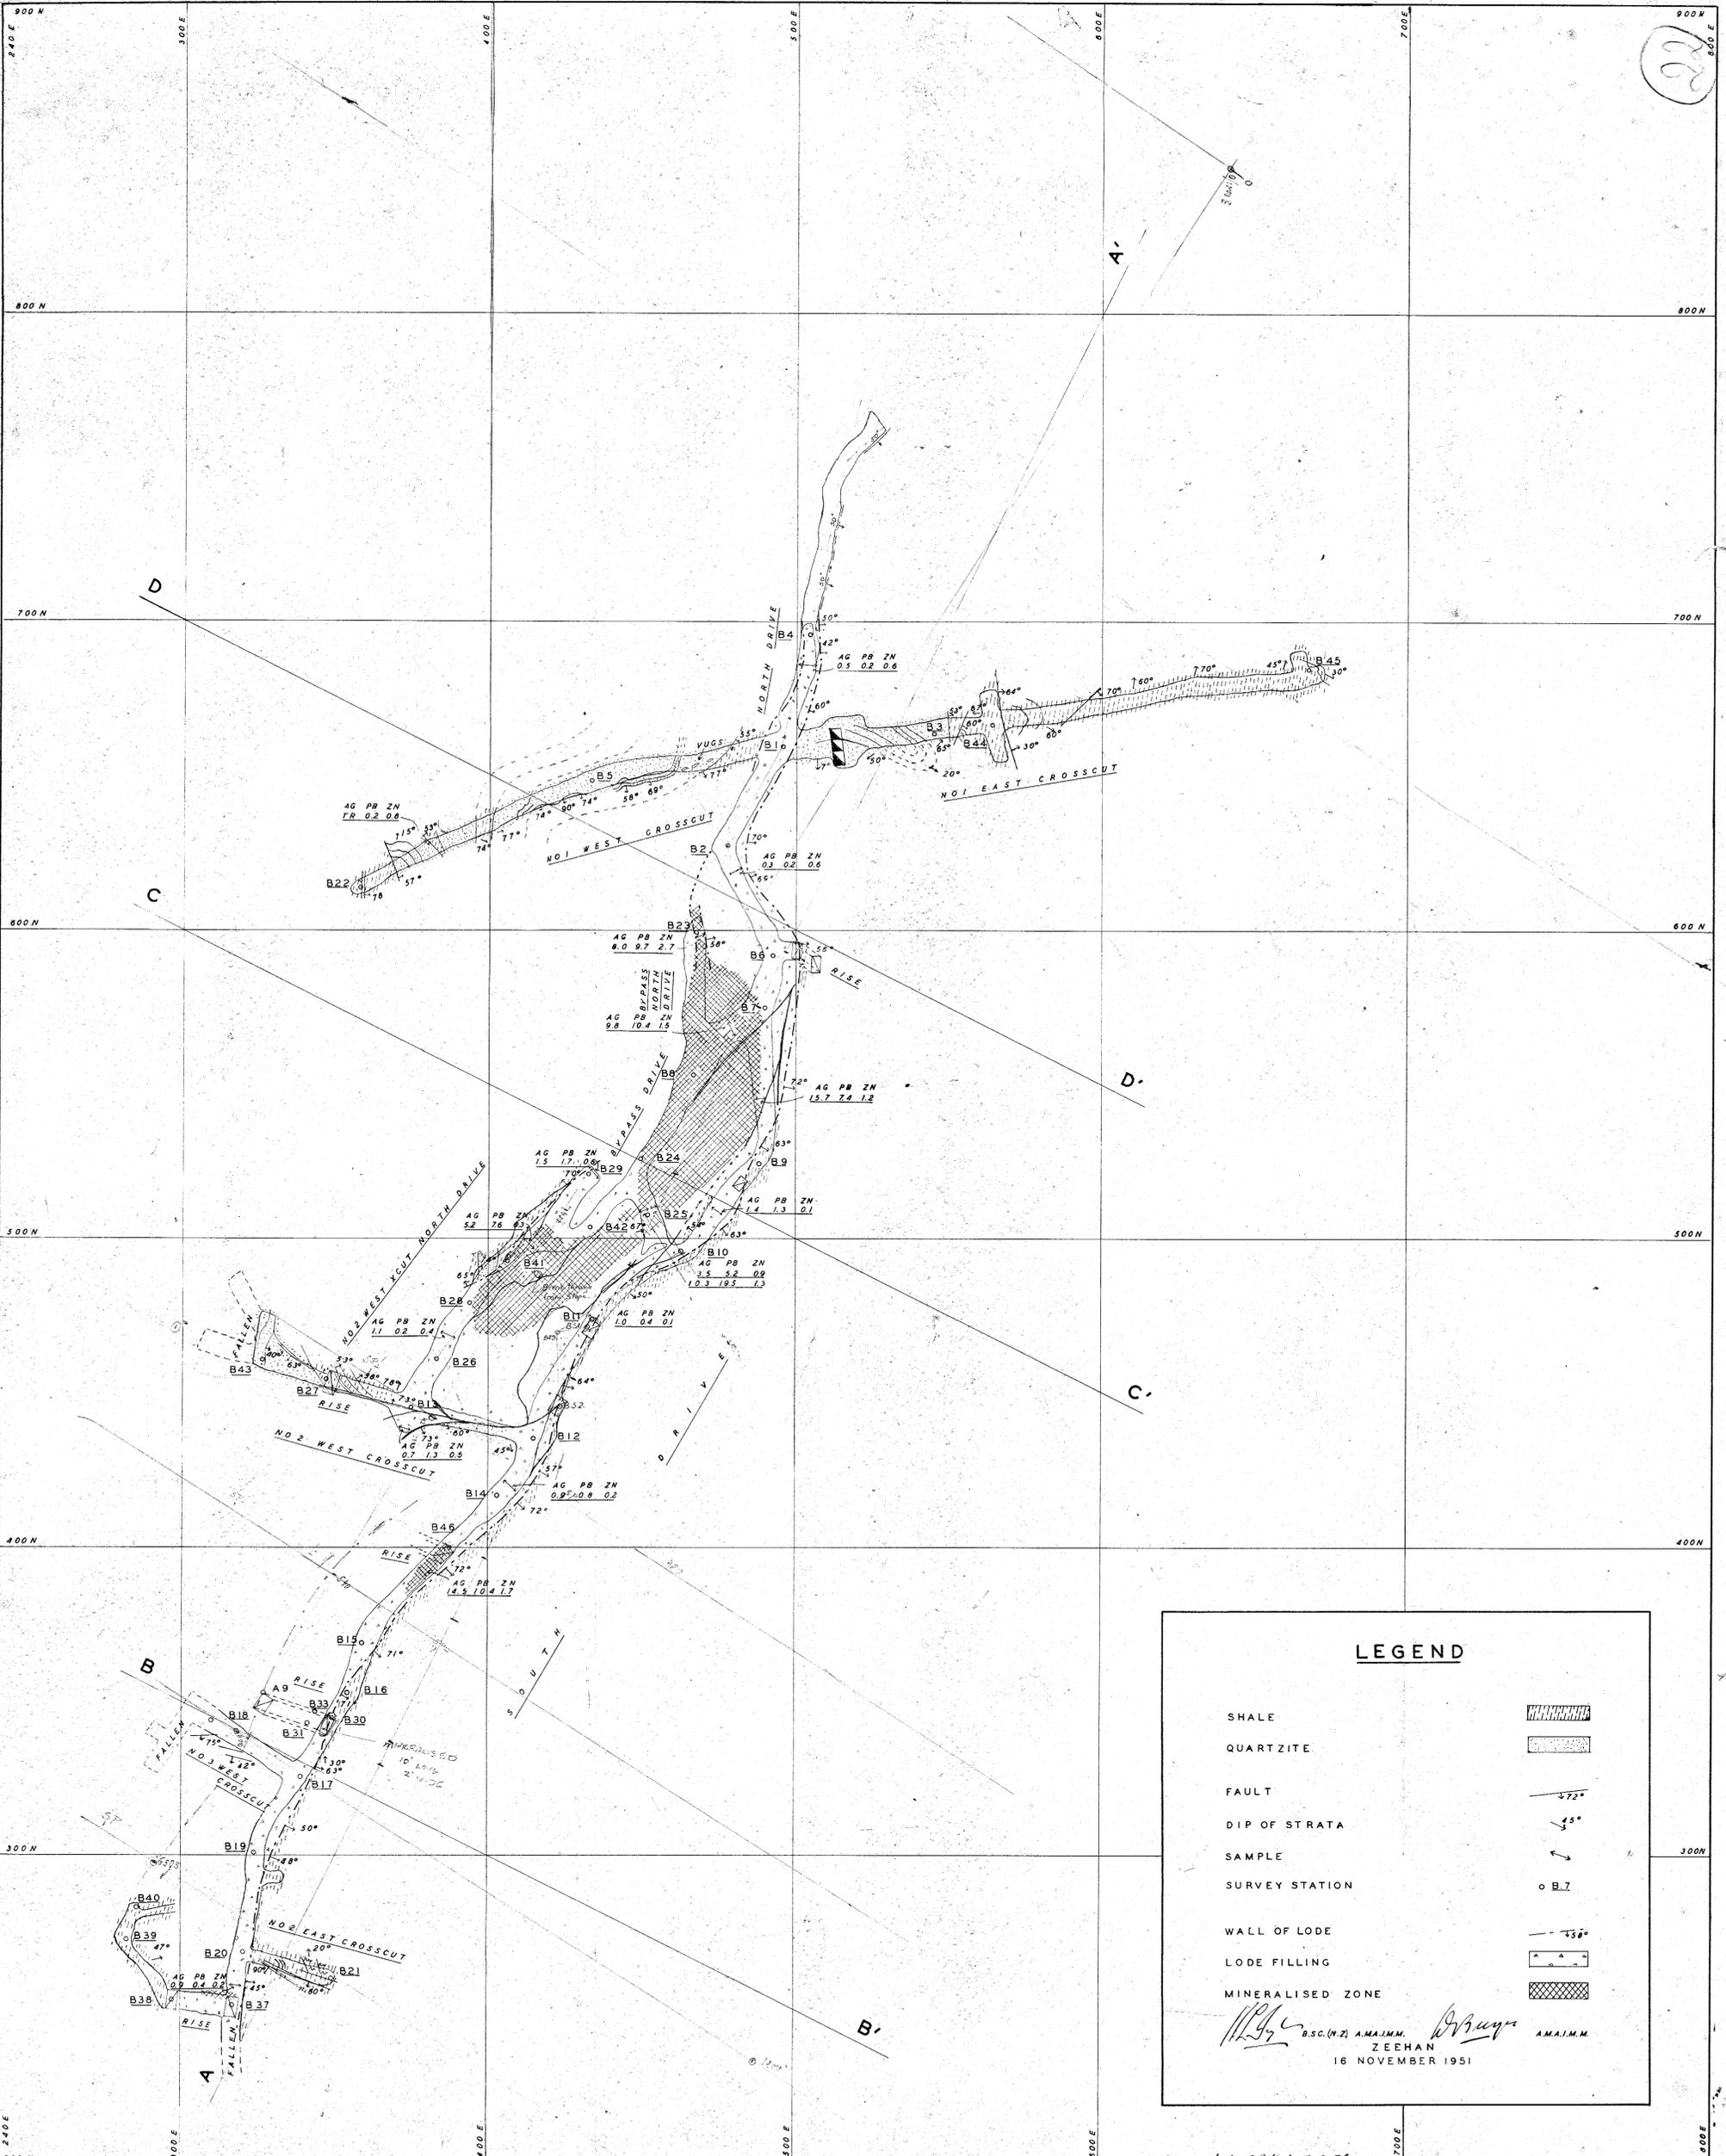

LEGEND

SHALE	
QUARTZITE	
FAULT	
DIP OF STRATA	
SAMPLE	
SURVEY STATION	
WALL OF LODE	
LODE FILLING	
MINERALISED ZONE	

[Signature] B.S.C. (N.Z.) A.M.A.I.M.M. *[Signature]* A.M.A.I.M.M.
 ZEEHAN
 16 NOVEMBER 1951

Surveyed by R.R. 7-A-56

SCALE
 1 IN = 20 FT
 BEARINGS
 MAGNETIC

MONTANA SILVER-LEAD MINE
100 FT LEVEL
 DEPARTMENT OF MINES - TASMANIA

PLAN NO
 1220 - 50
 29-05