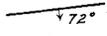
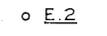
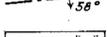
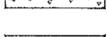



5 cm

### LEGEND

- SHALE 
- QUARTZITE 
- FAULT 
- DIP OF STRATA 
- SAMPLE 
- SURVEY STATION 
- WALL OF LODE 
- LODE FILLING 
- MINERALISED ZONE 

*[Signature]* B.Sc.(N.Z) A.M.A.I.M.M. *[Signature]* A.M.A.I.M.M.  
 ZEEHAN  
 3 JULY 1958

*Brought Up To Date 24/1/58 P. Saunders. Sams.*

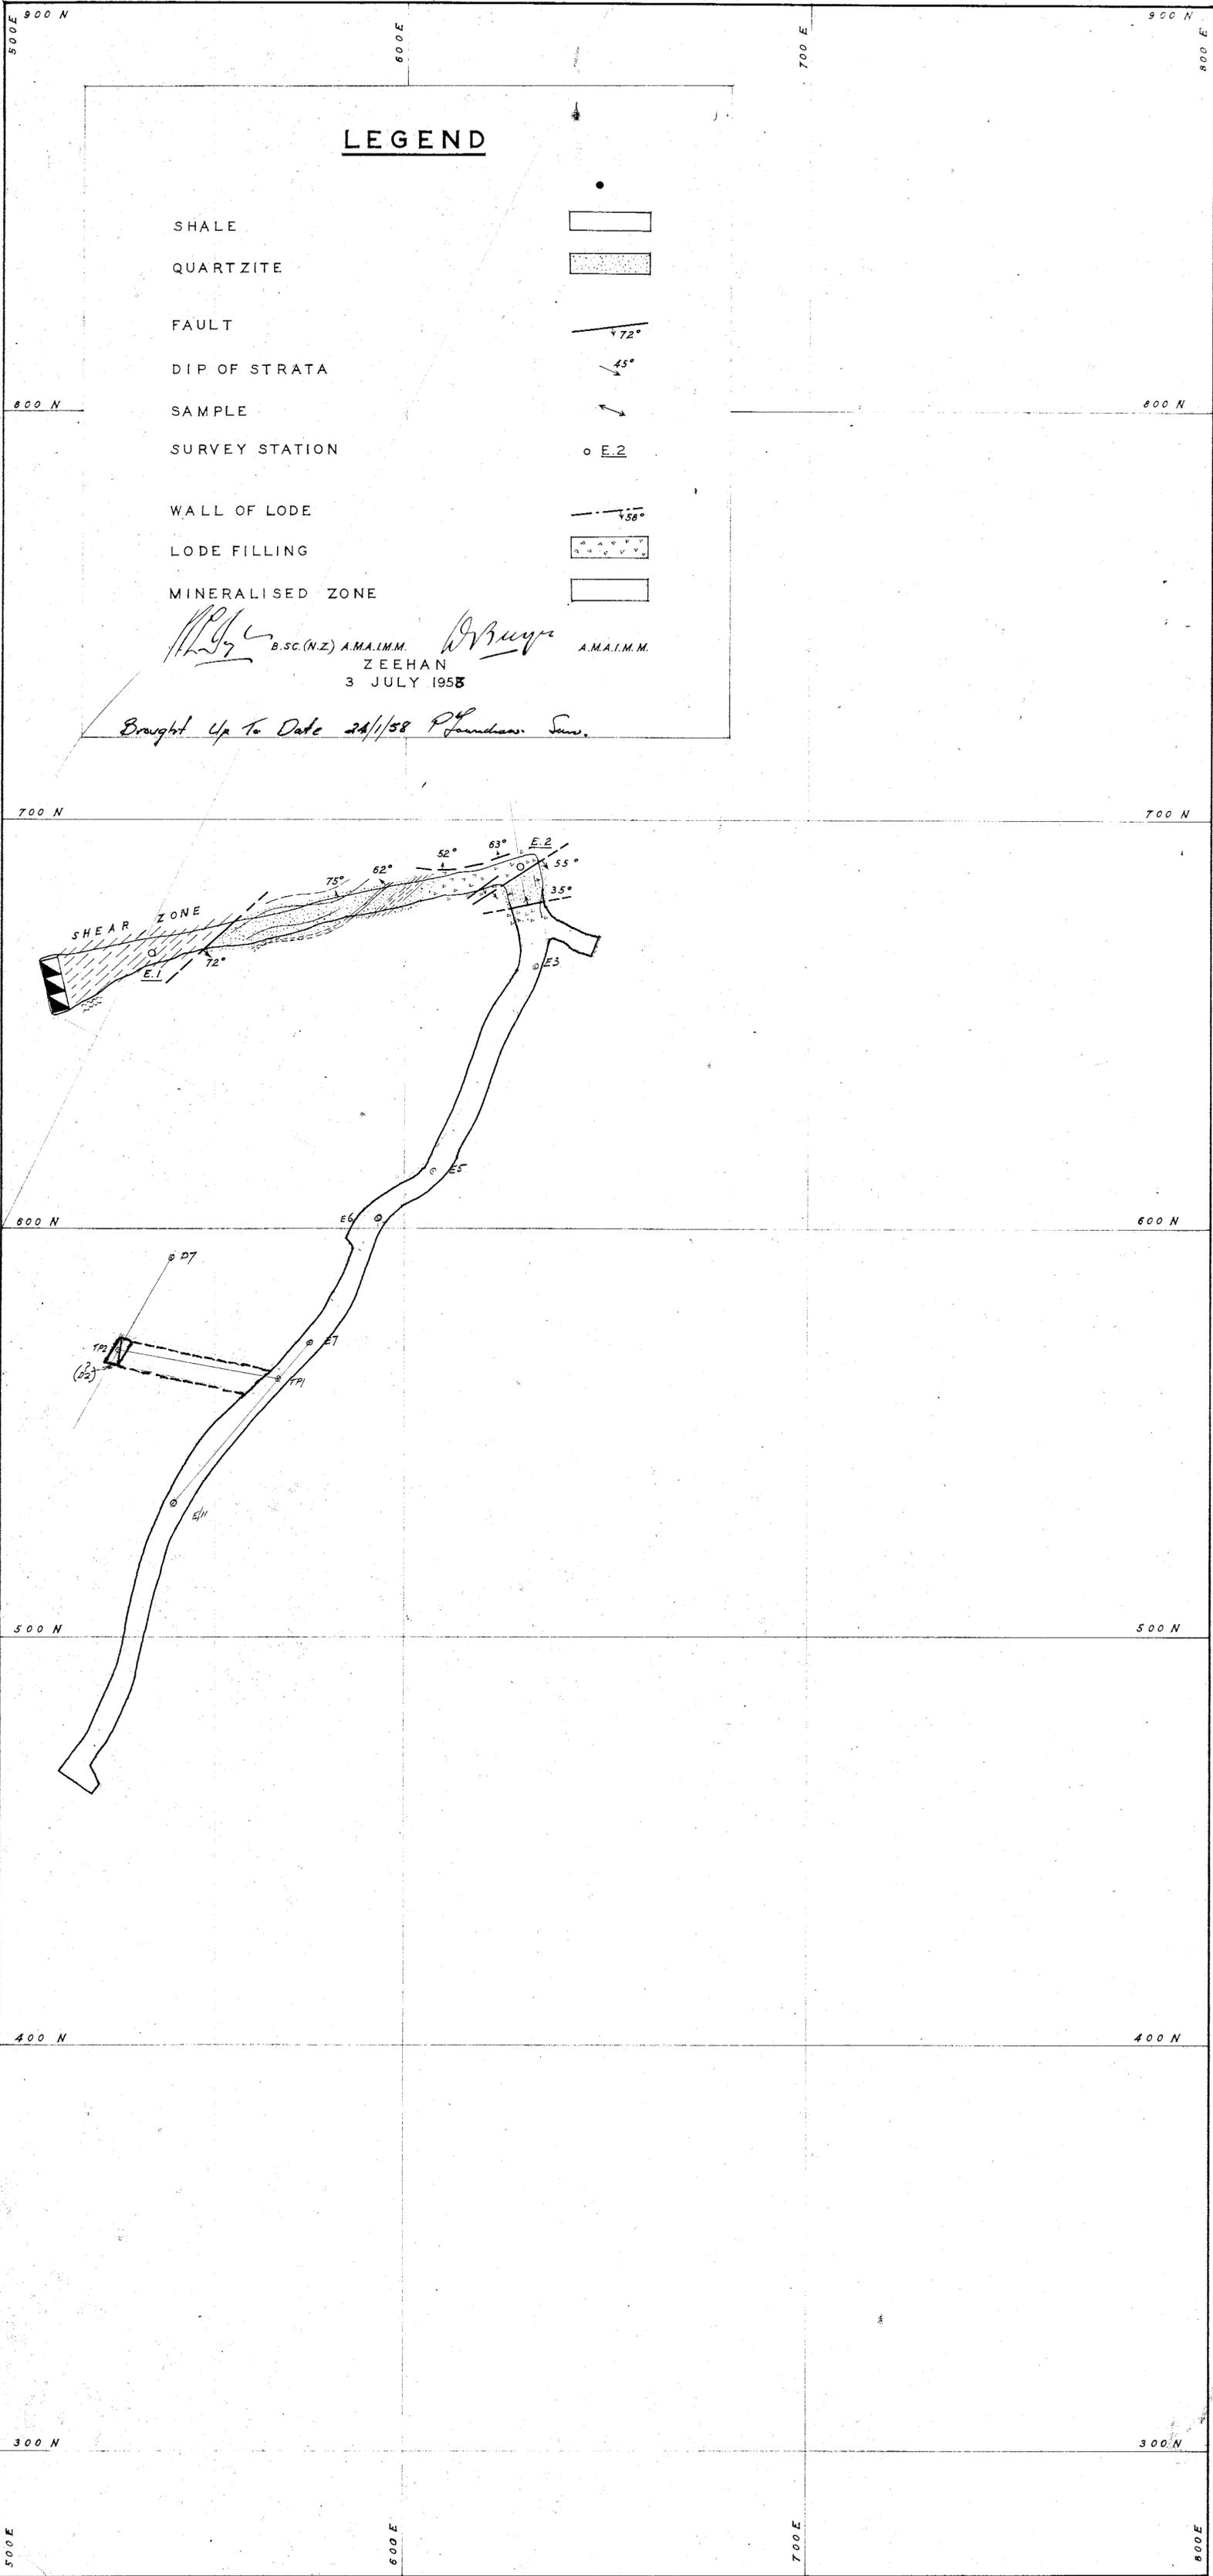

PLAN N°  
 1294-50

## MONTANA SILVER-LEAD MINE 270 FT. LEVEL

SCALE  
 1 IN. = 20 FT.  
 BEARINGS  
 MAGNETIC

29-08