



5 cm

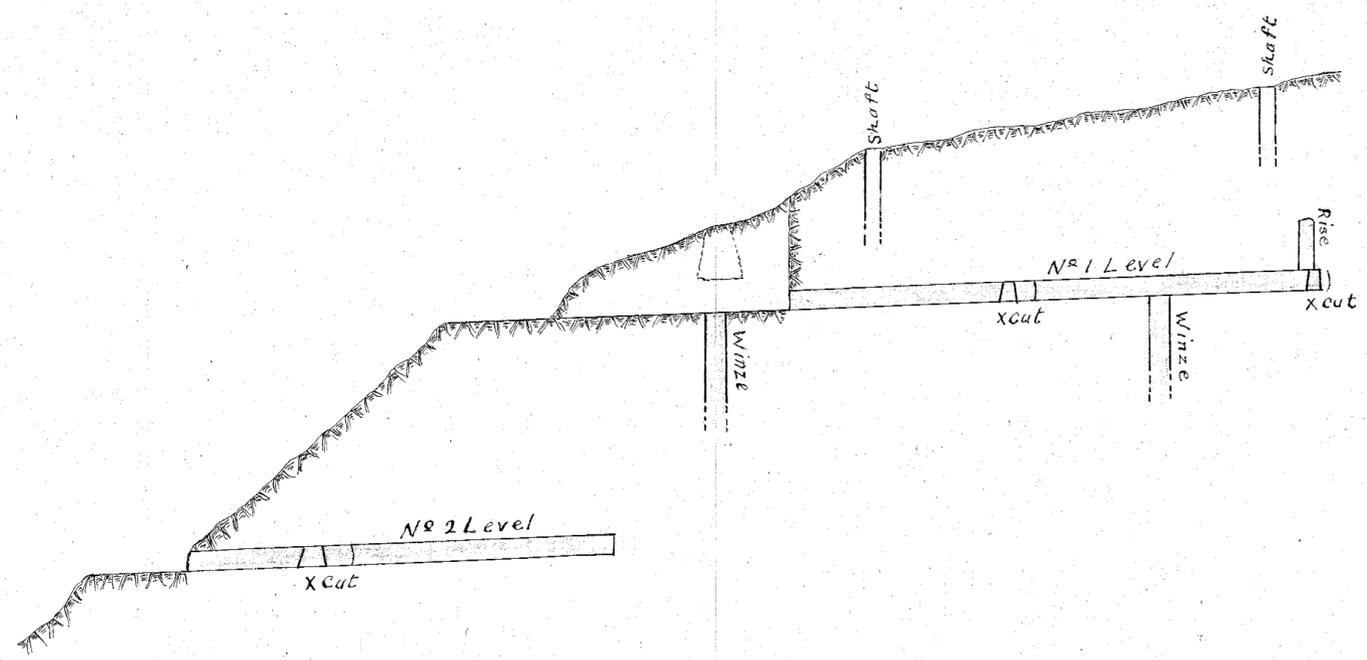

Projection of Workings on a vertical plane lying North and South.

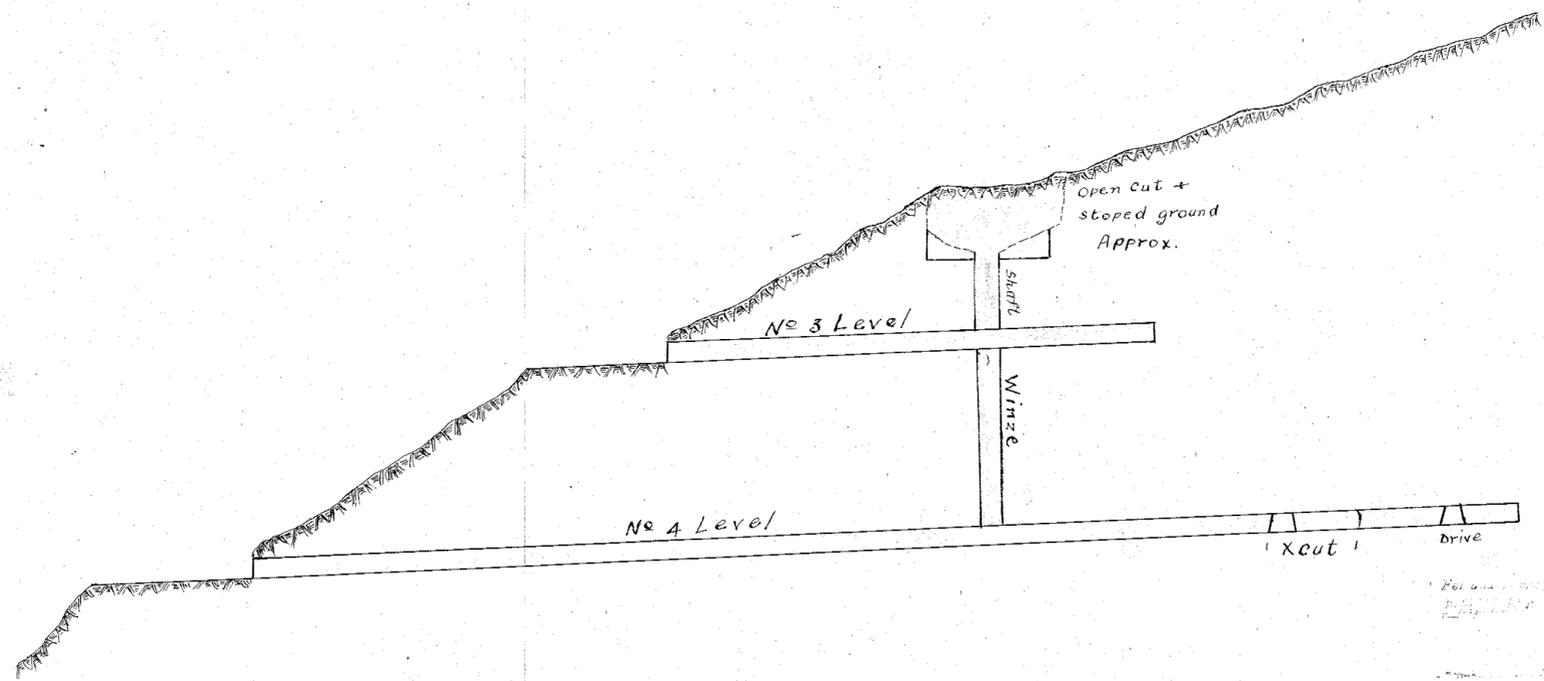

Projection of Workings on a vertical plane bearing 55° E of N.

Scale 1 inch = 40 feet

For and on behalf of THE MINES LTD. G. W. H. E. 7/11/1911

