


30-02



5 cm

Prepared and Published by
 FISHER & WOLFE
 40, MARK LANE, LONDON, E.C. 3
 G. Wolfe
 1936

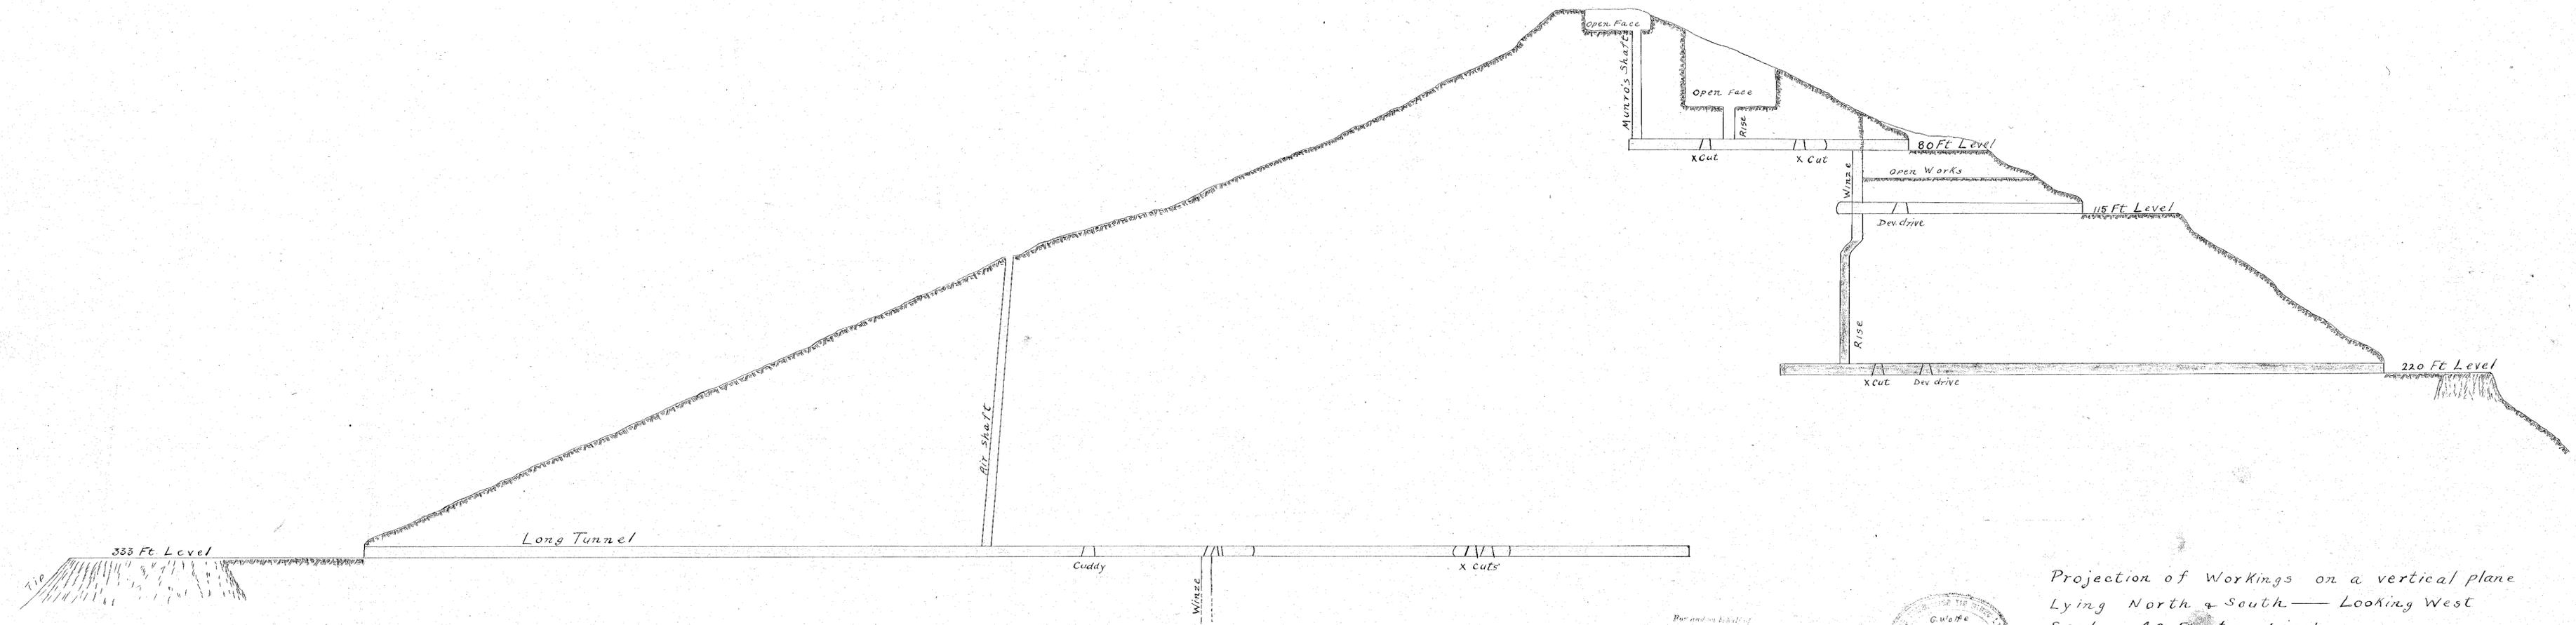

Projection of Workings on a vertical plane
 Lying North & South — Looking West
 Scale 40 Ft to 1 inch

G.W. 25/3/36

30-02