


5 cm

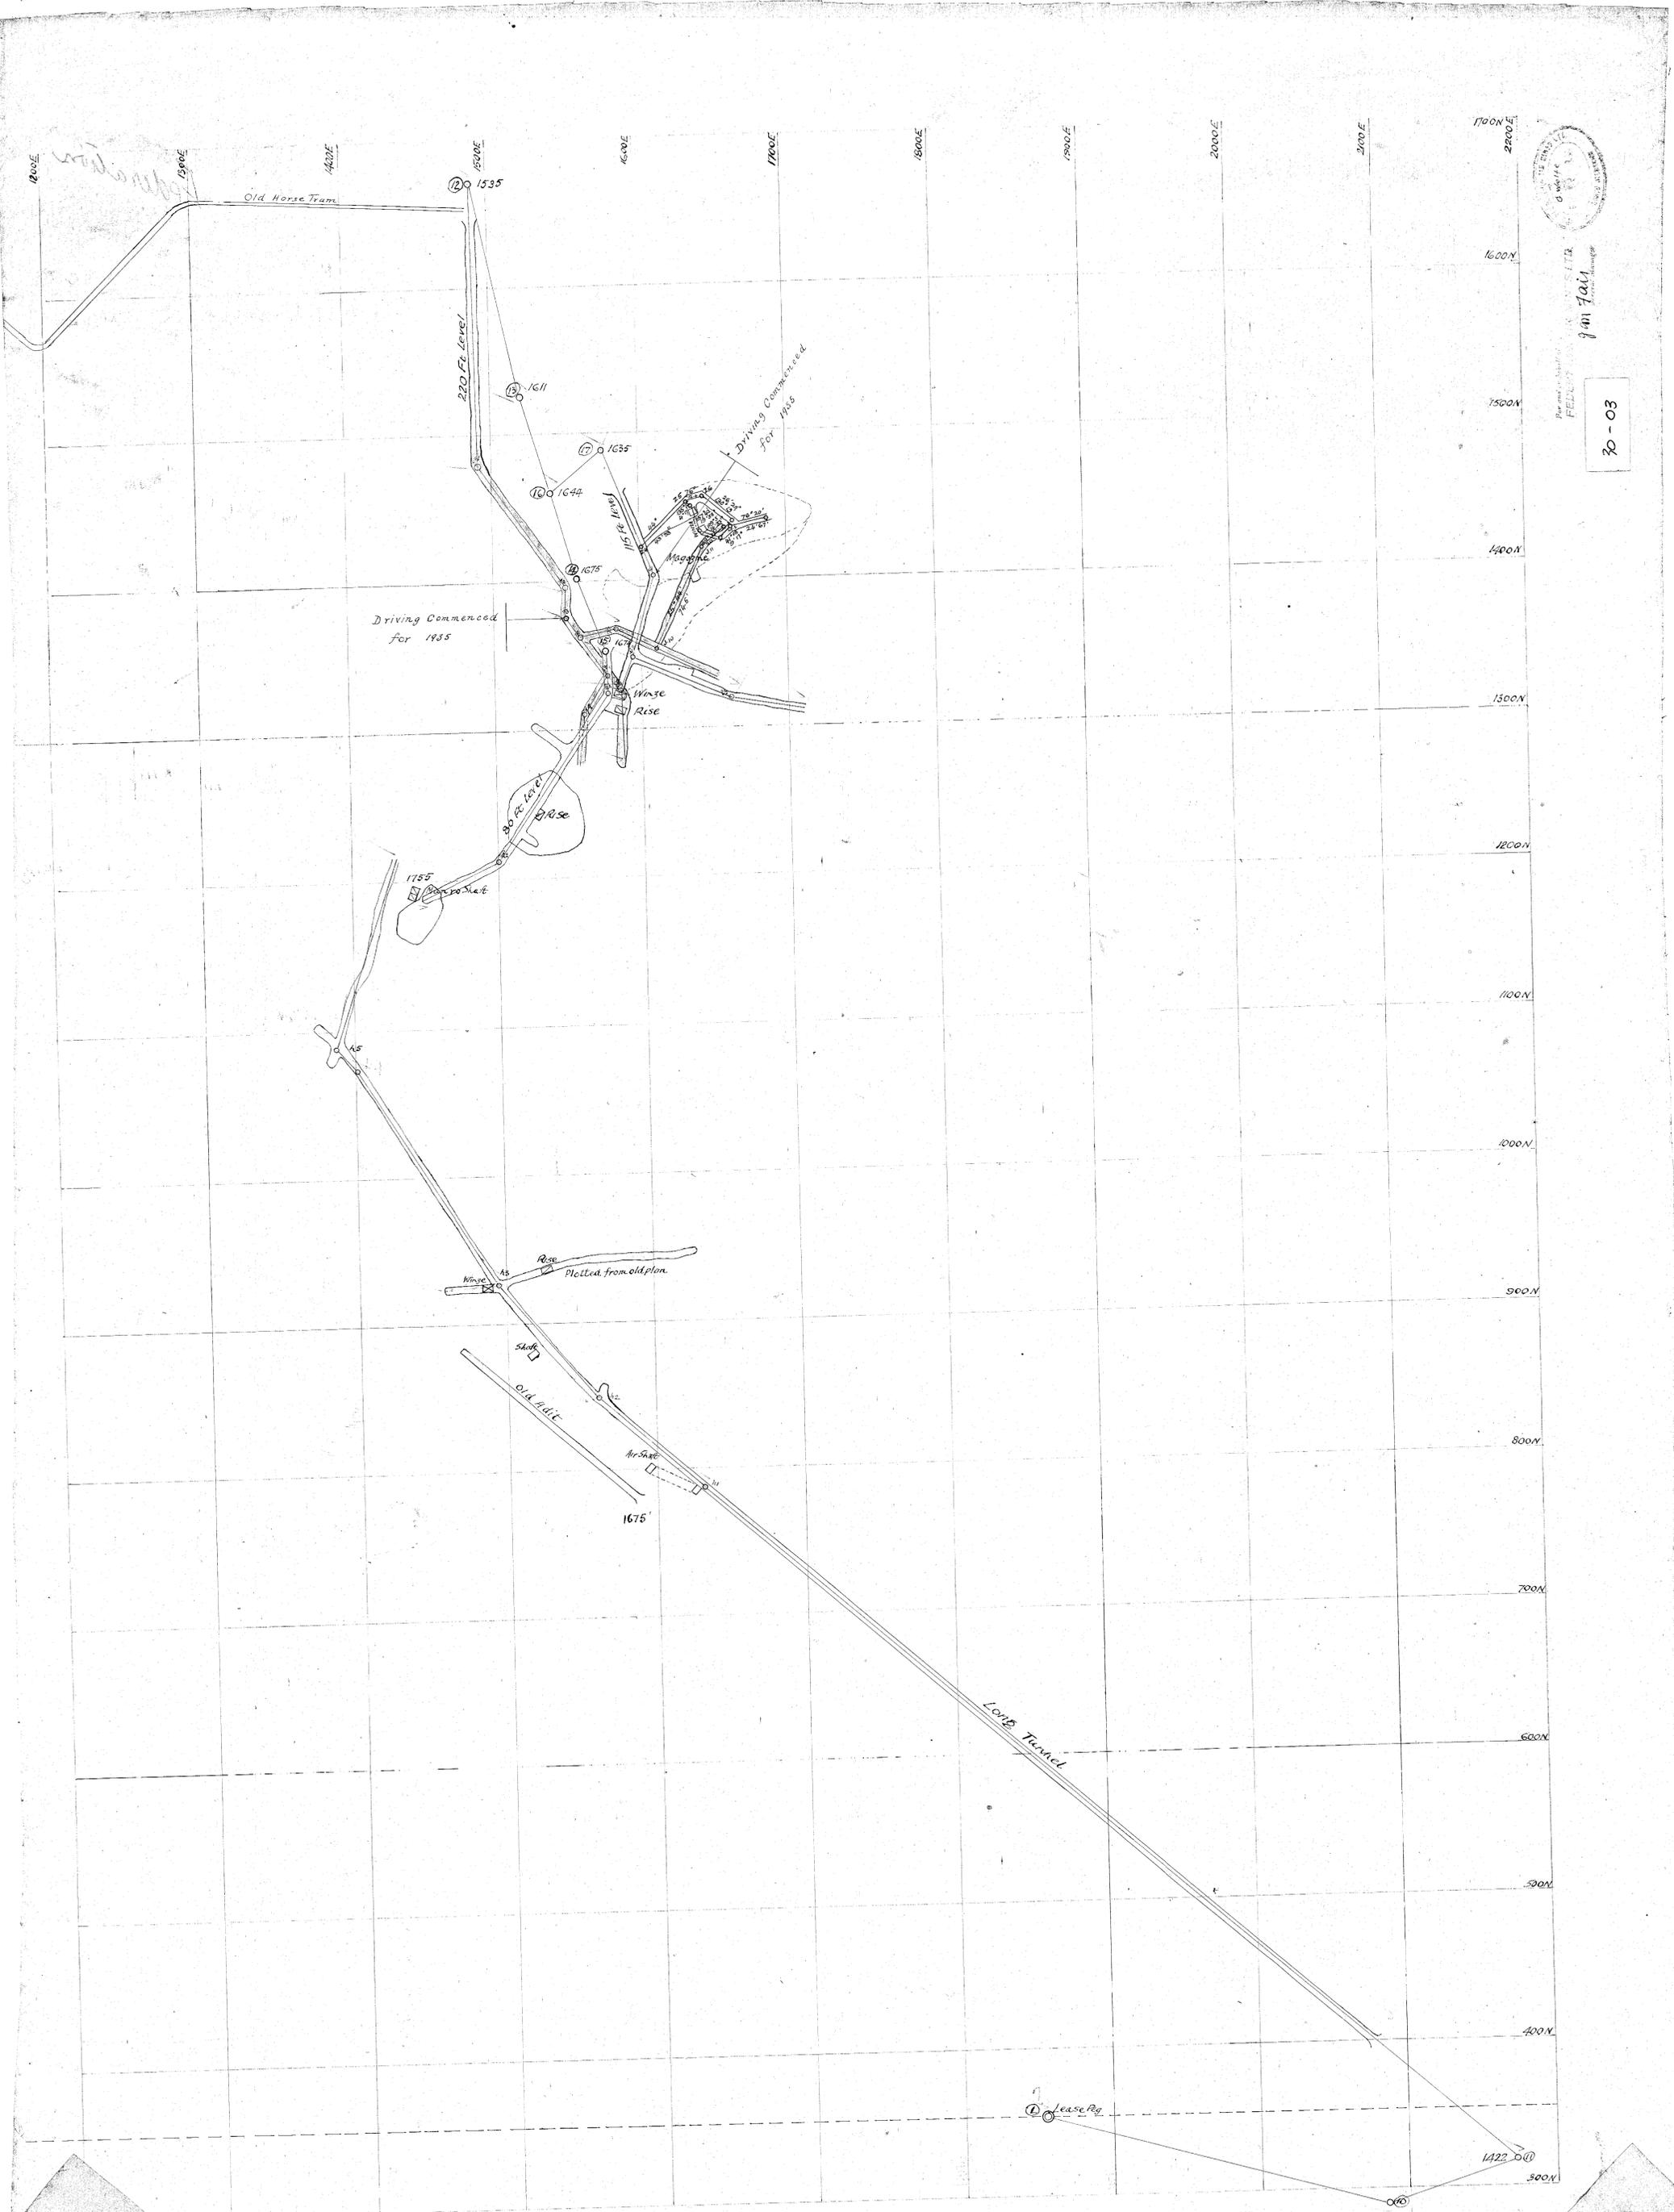

For use only in
FIELD OFFICES
JAN 7 1941
FEDERAL BUREAU OF SURVEY
U.S. DEPARTMENT OF THE INTERIOR

30-03