


5 cm

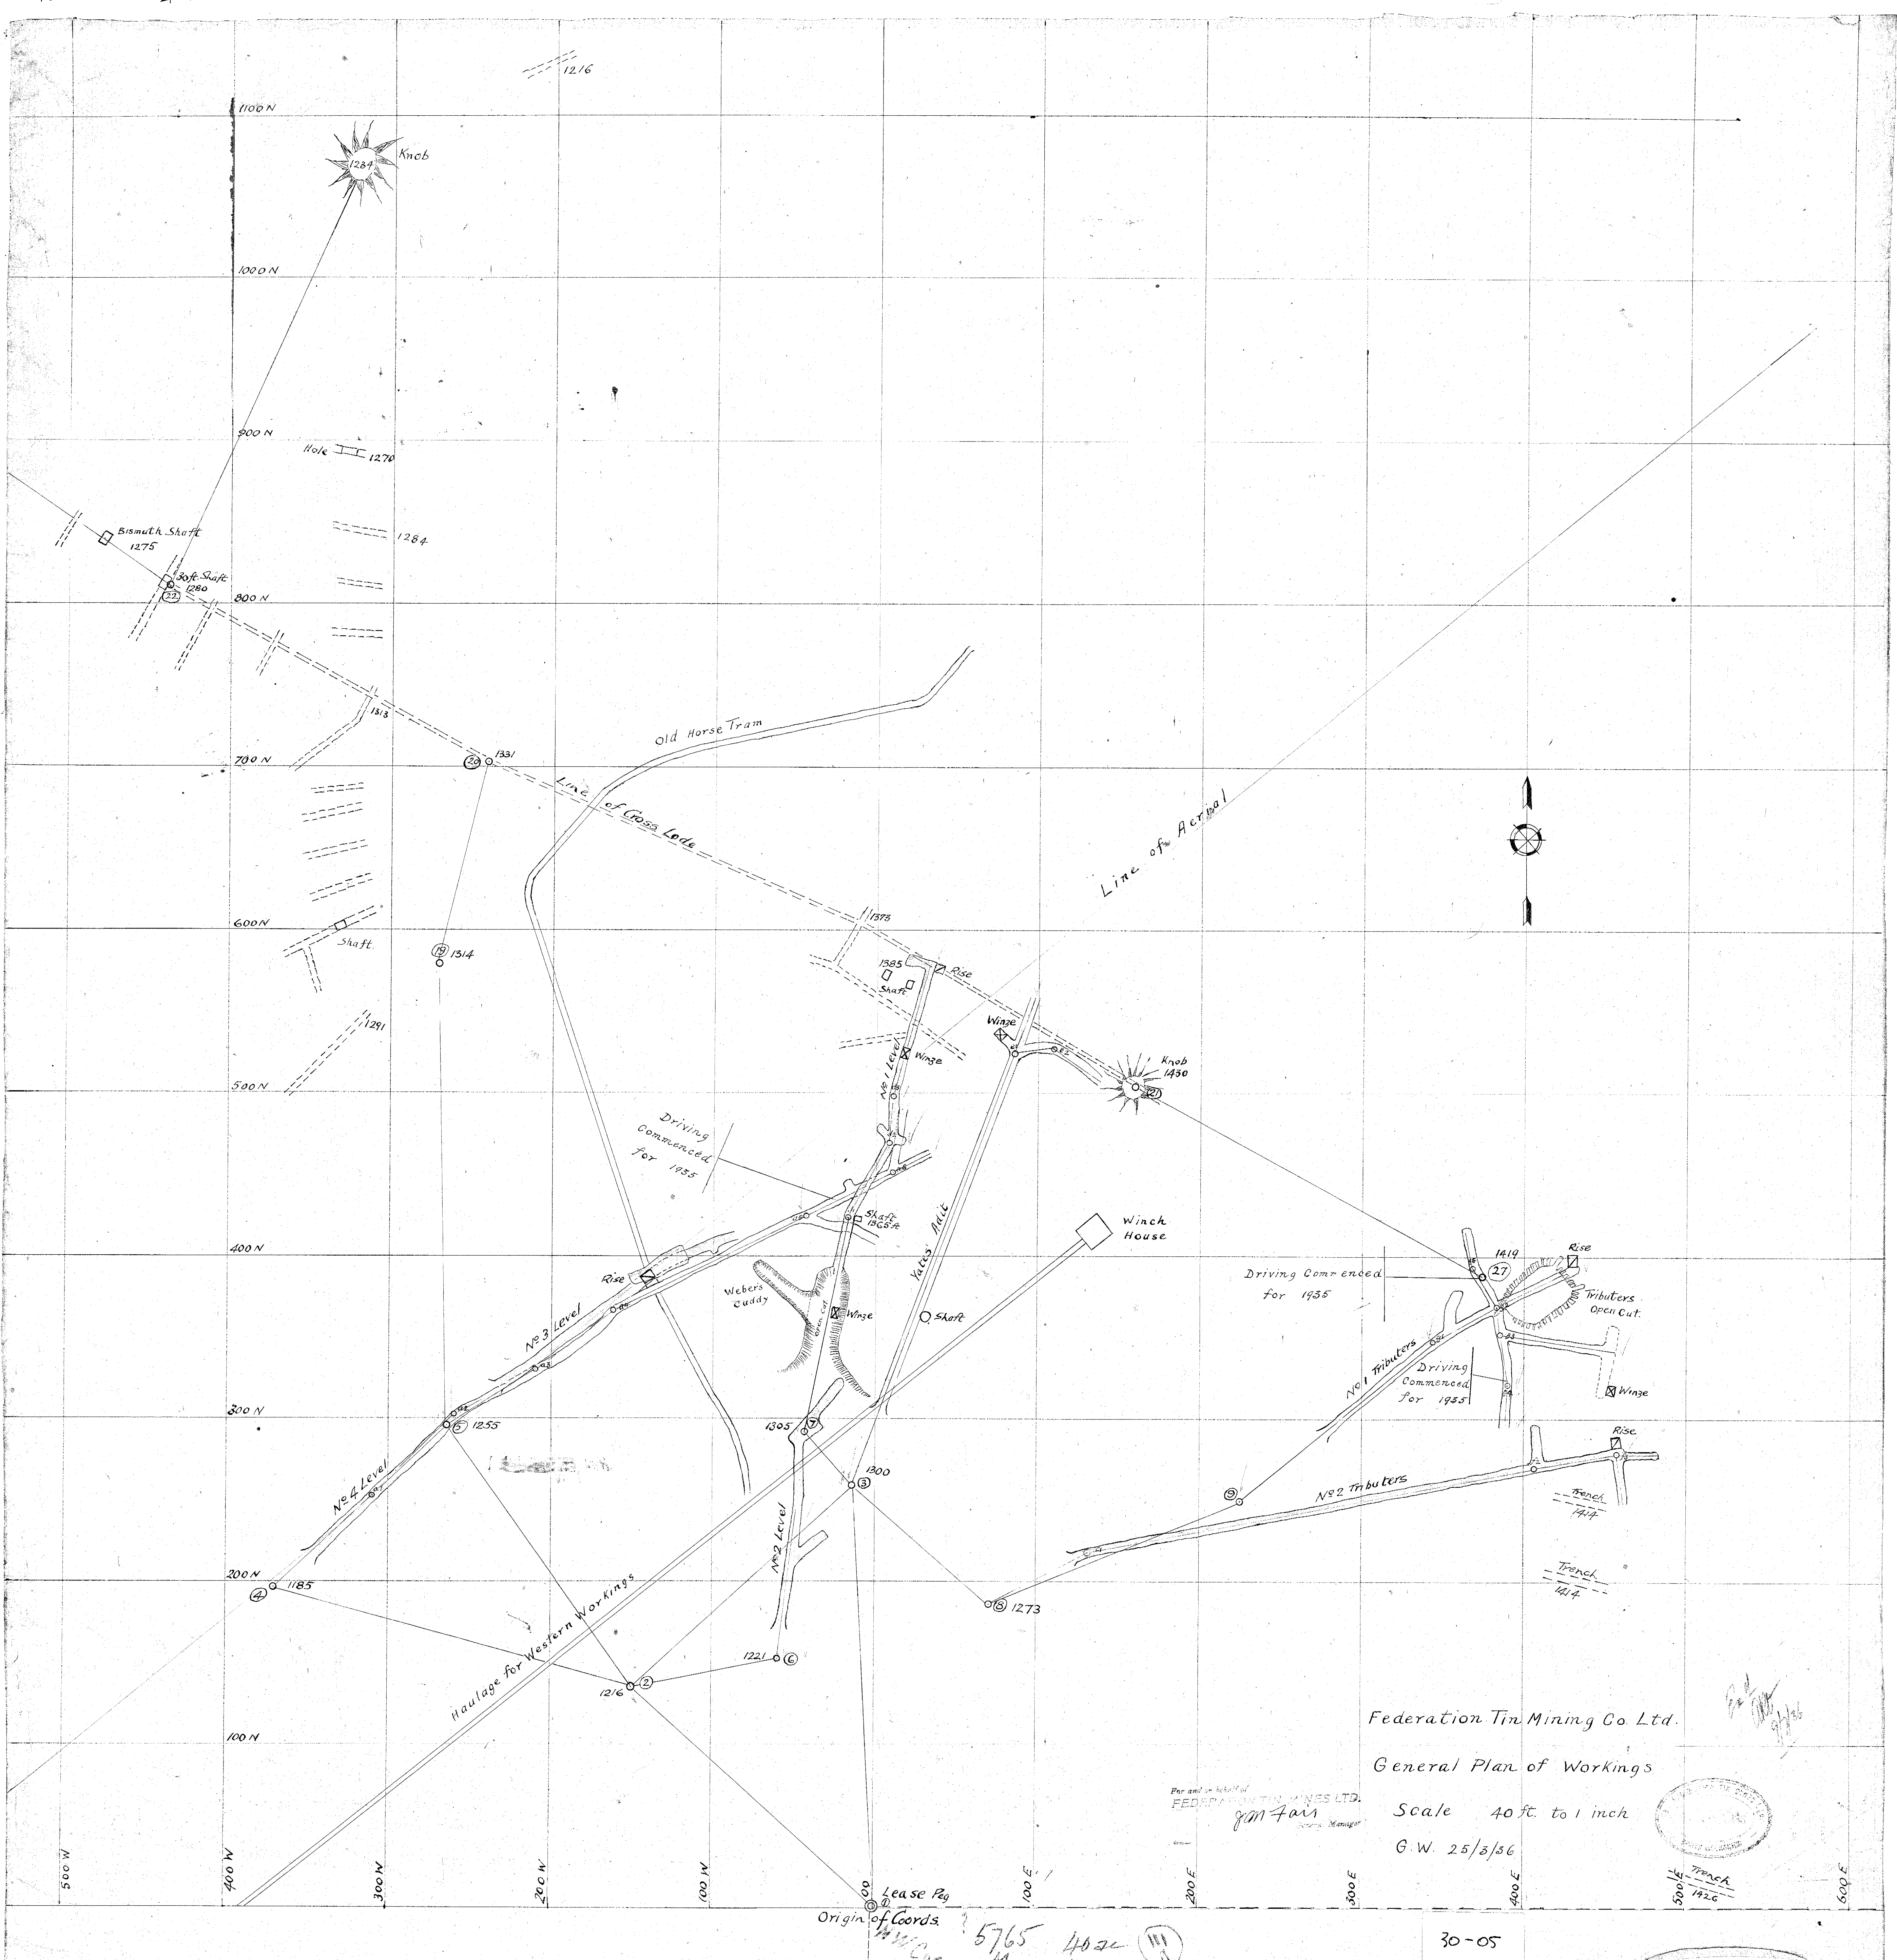


Federation Tin Mining Co Ltd.

General Plan of Workings

Scale 40 ft. to 1 inch

G.W. 25/3/36

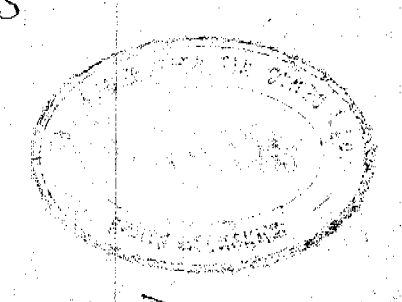

Lease Pq
Origin of Coords
5765
4032
11