
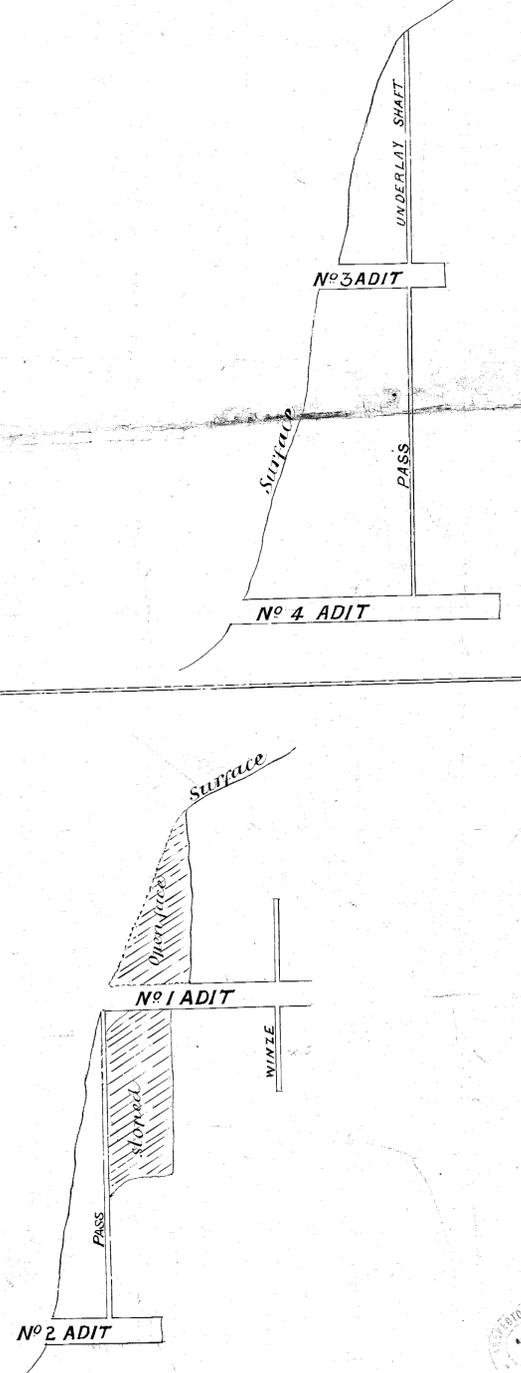


PLAN  
OF  
WORKINGS  
OF  
NEW WEST CUMBERLAND TIN MINE

HEEMSKIRK

Scale 25 feet to an inch

SECTION  
Scale { Horizontal 2 chains to an inch  
Vertical 20 feet . . .

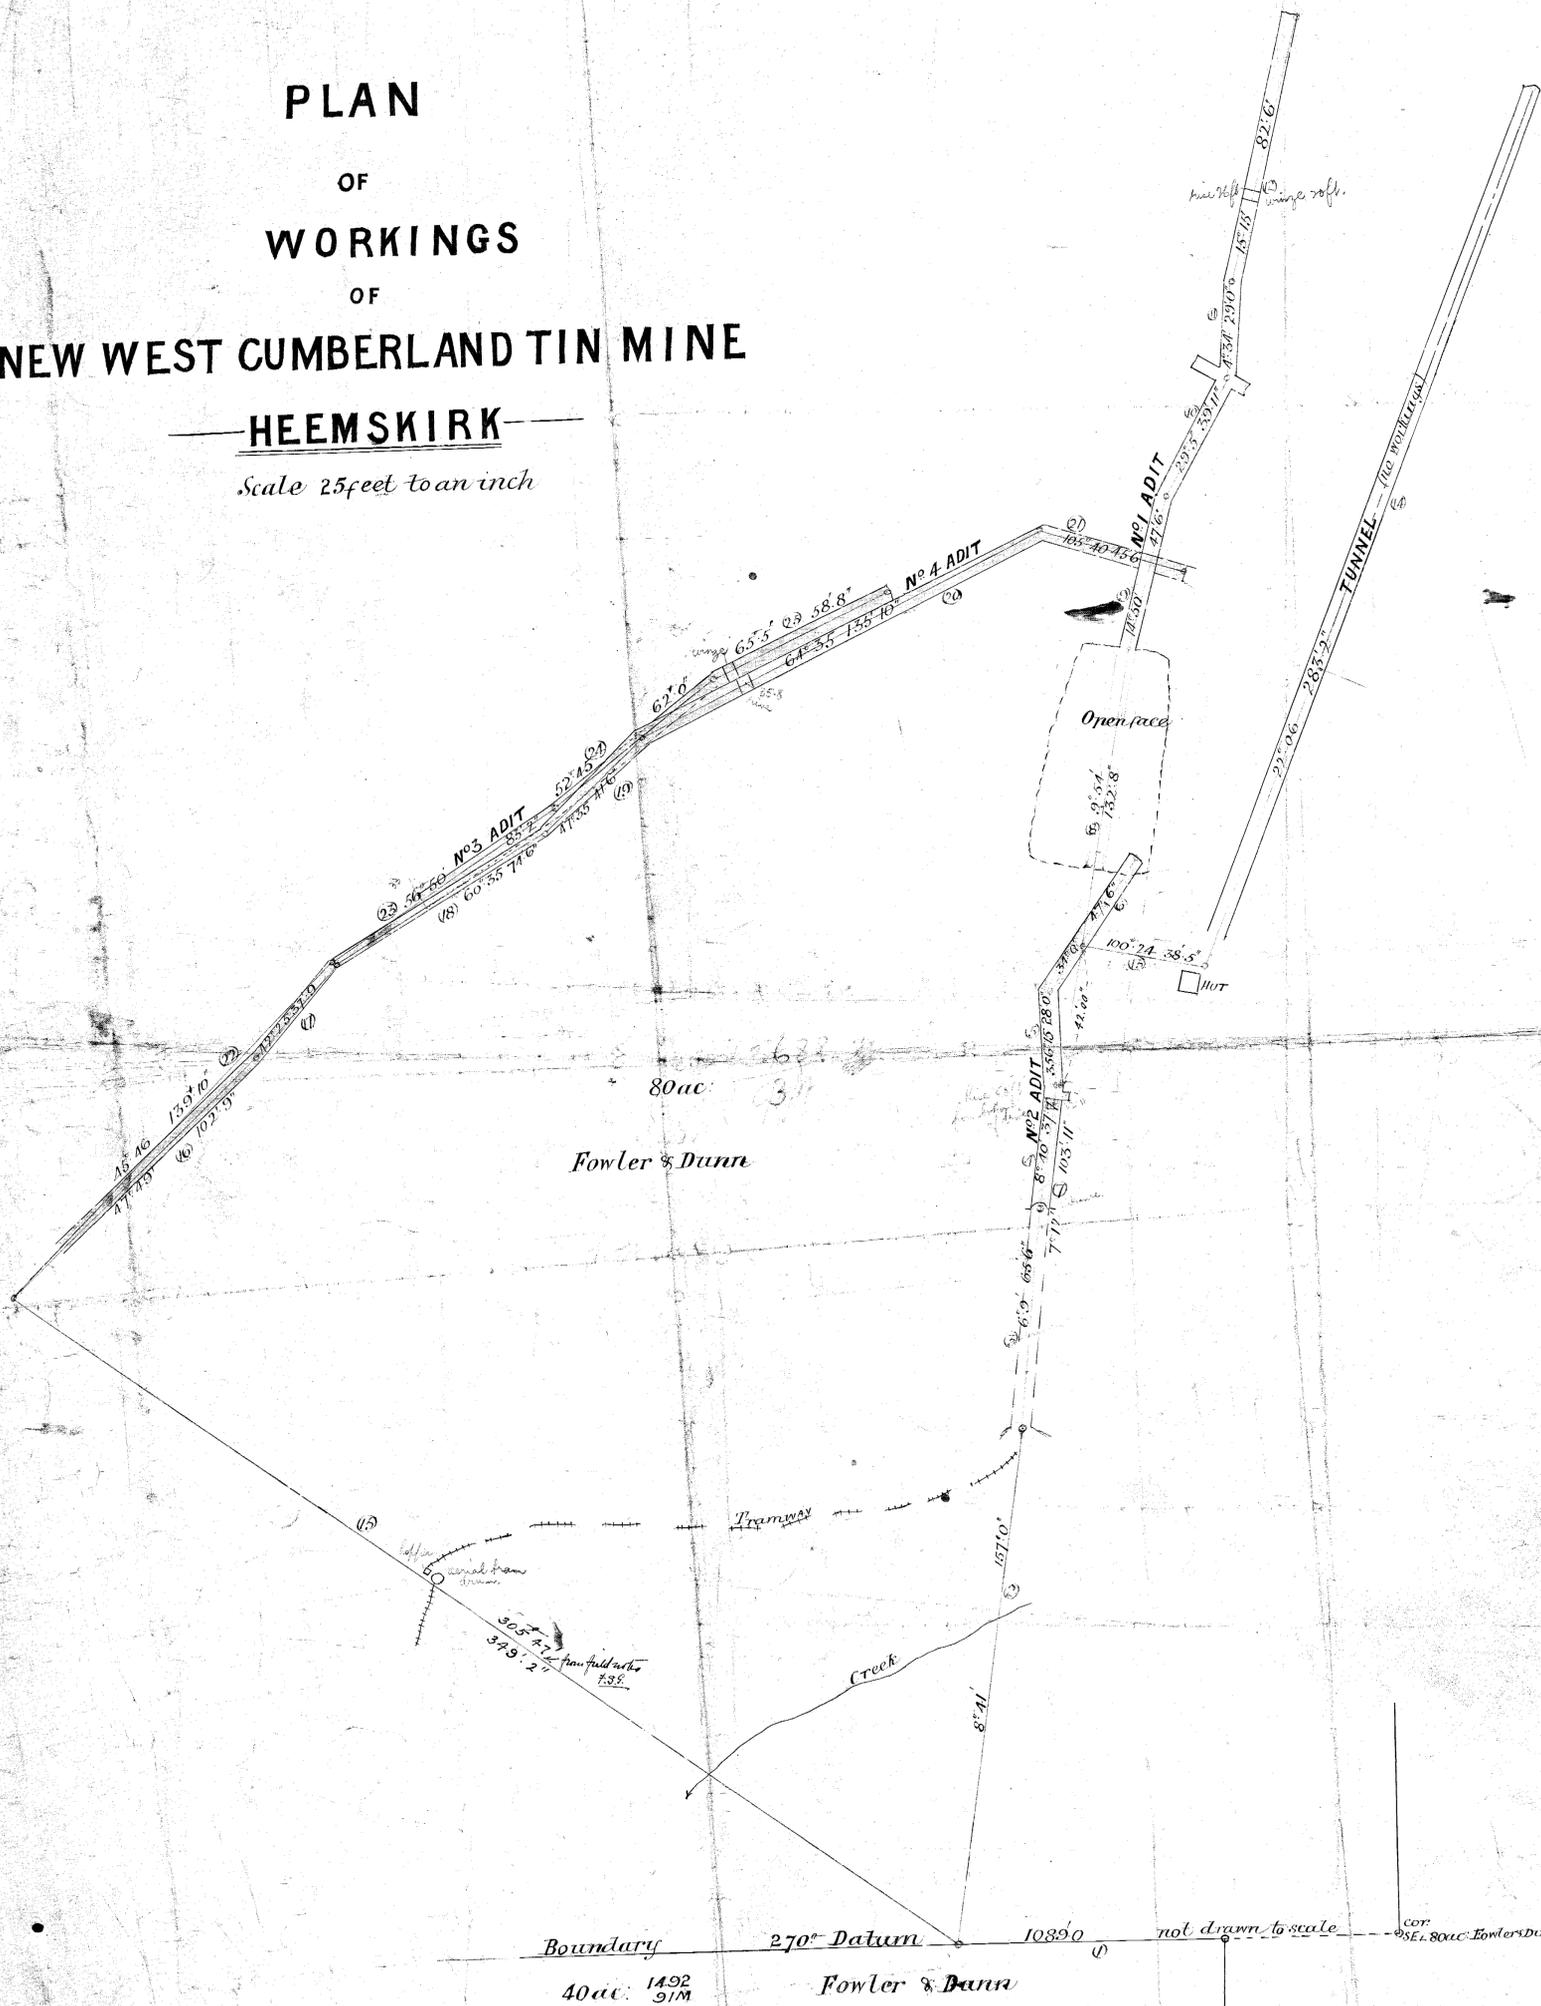

Fowler & Dunn

Boundary 270° Datum 10890 not drawn to scale  
40ac. 1492 91M Fowler & Dunn



Theodolite Survey  
by  
E. J. Smith  
Aust. Surveyor  
April 1895

30-08