


5 cm

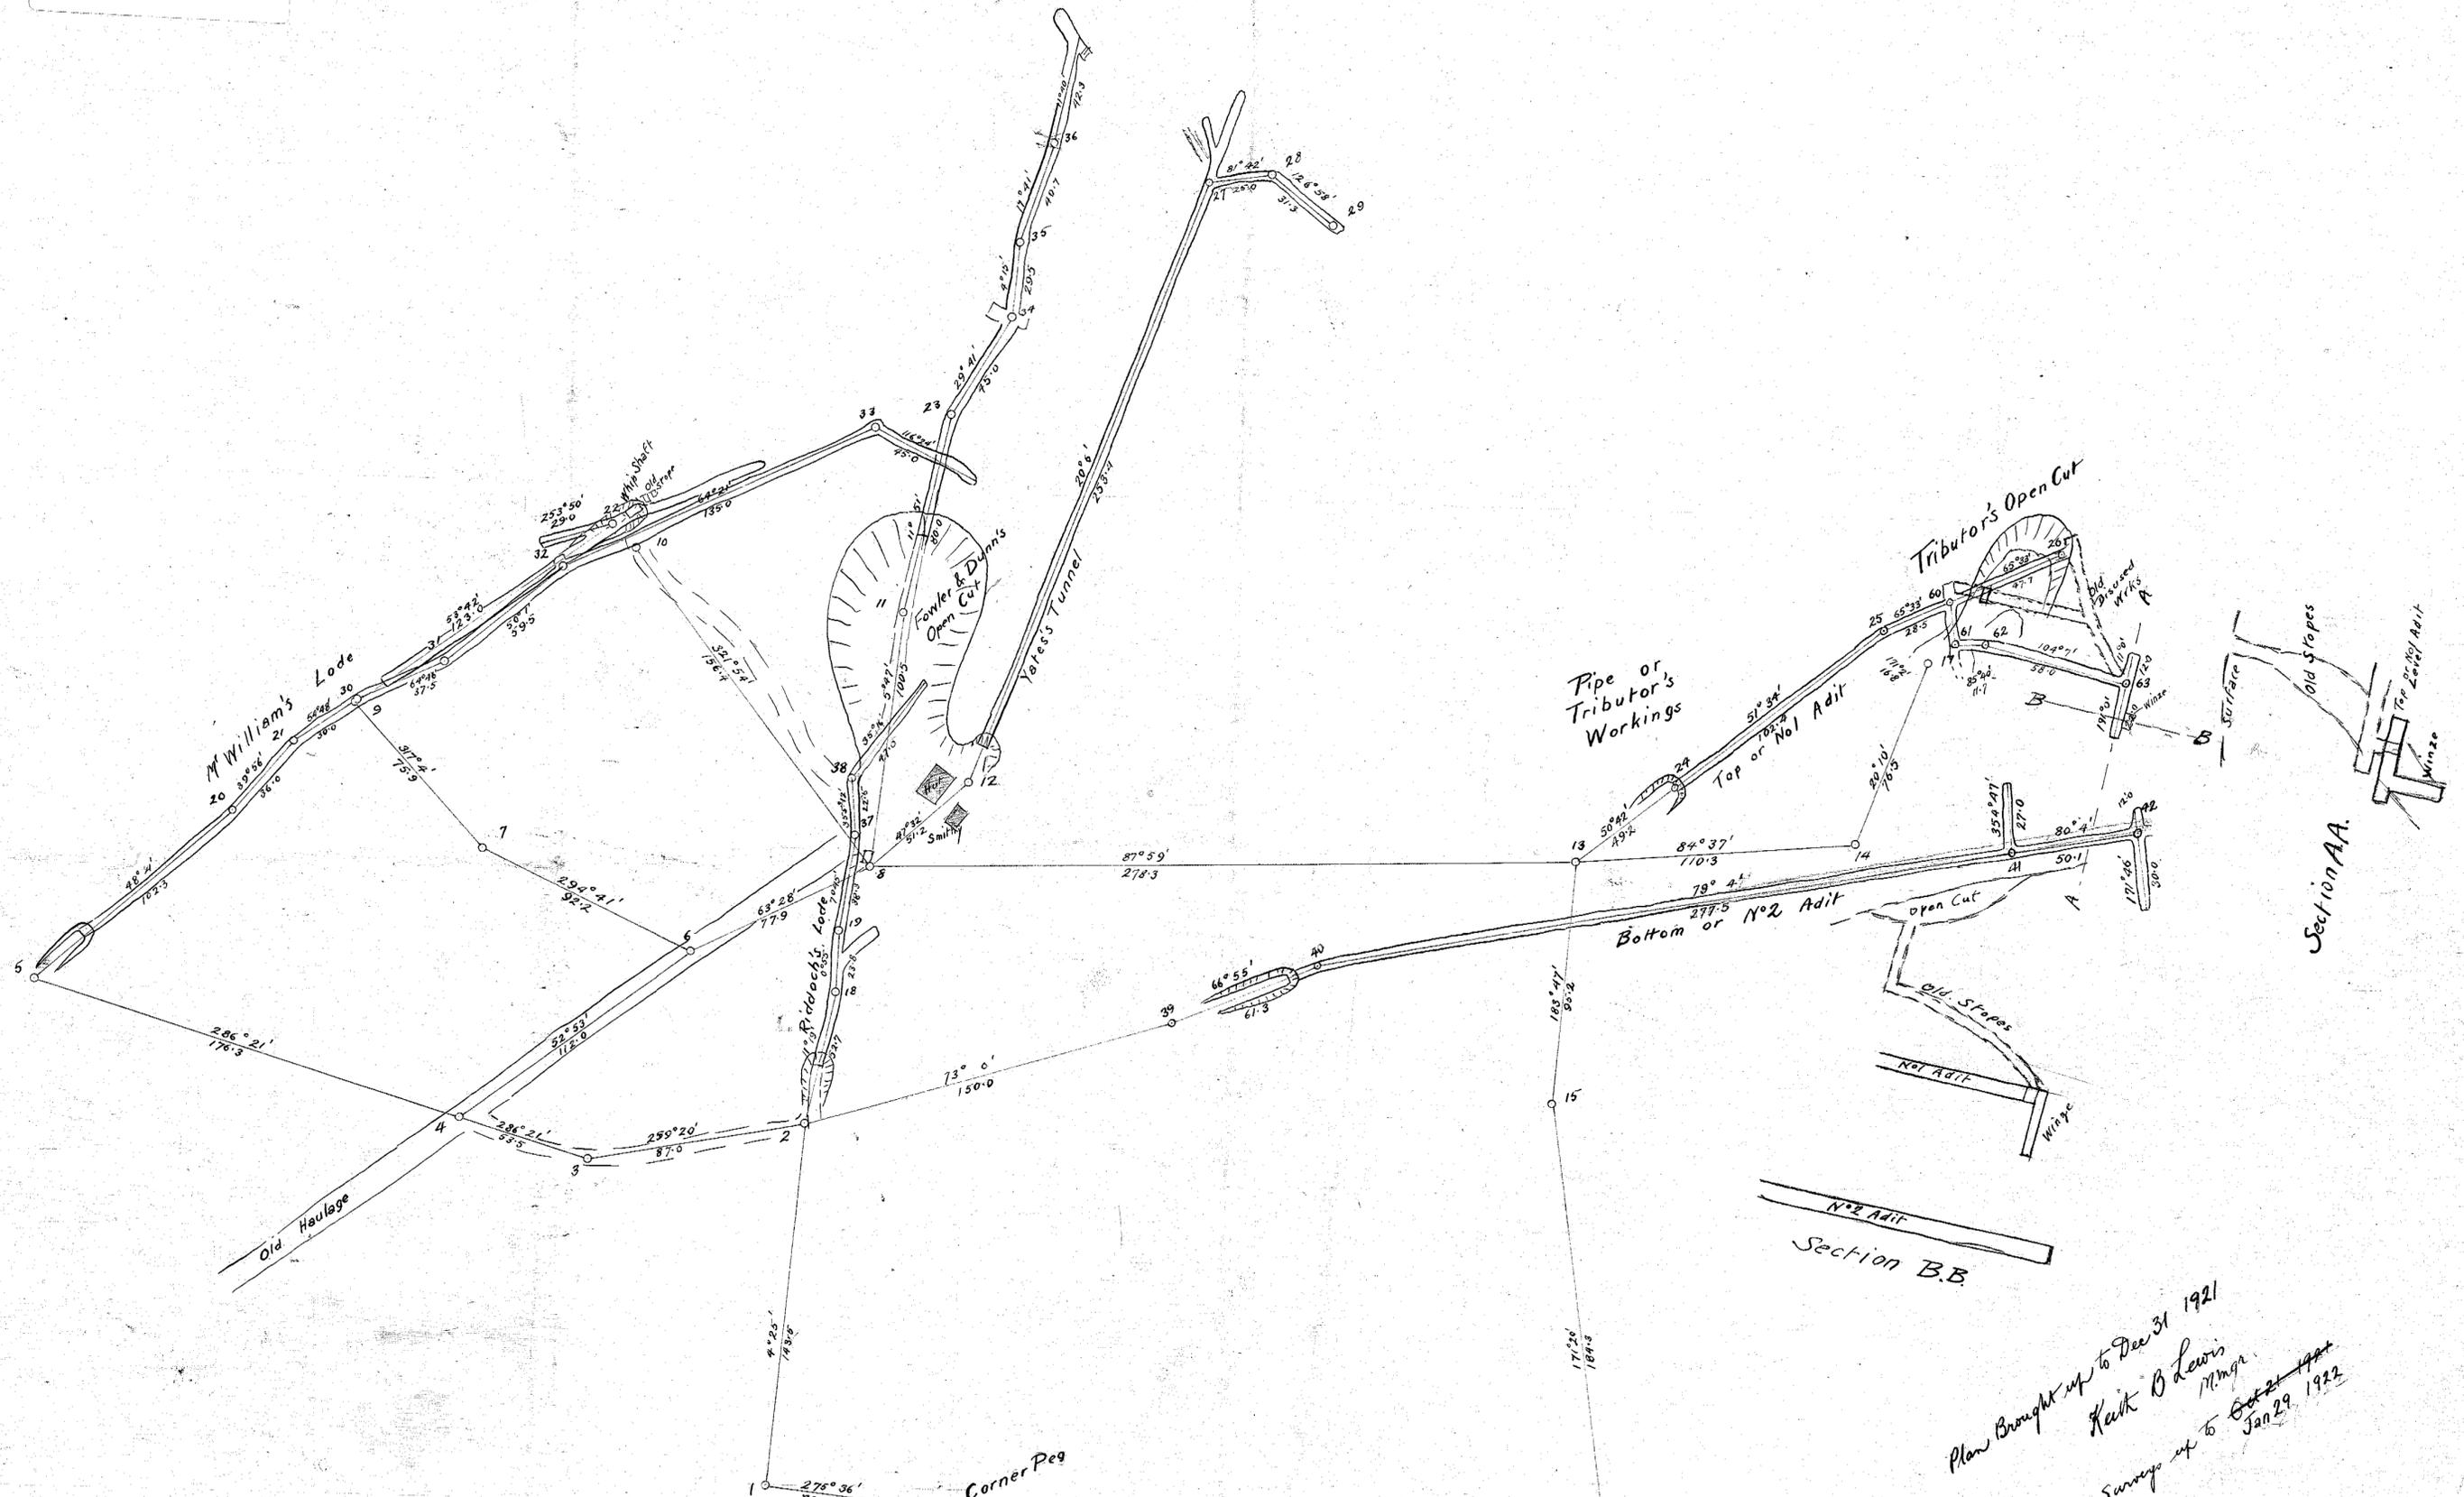

Federation Tin No. 12
 Plan Western Workings
 Scale - 40 Feet = 1 Inch

Instruments Used -
 4" T. & S. Tacheometer (bearings)
 100' Steel Tape (distances)

Ex. d.
 6-4-22

Plan Brought up to Dec 31 1921
 Keith O. Lewis Mgr.
 Survey up to ~~Oct 21 1921~~
 Jan 29 1922

30-09

Federation Tin
 Mine