

5 cm

FEDERATION TIN MINES LTD.


FIELD NOTES OF UNDERGROUND WORKINGS — BROUGHT UP TO 5<sup>th</sup> JAN. 1937

CERTIFIED CORRECT *Geo Wolfe* SURVEYER

FOR TAS. GOVT. MINES DEPT.

*Geo Wolfe* MINE MANAGER

INSTRUMENT USED: 5" THEODOLITE.

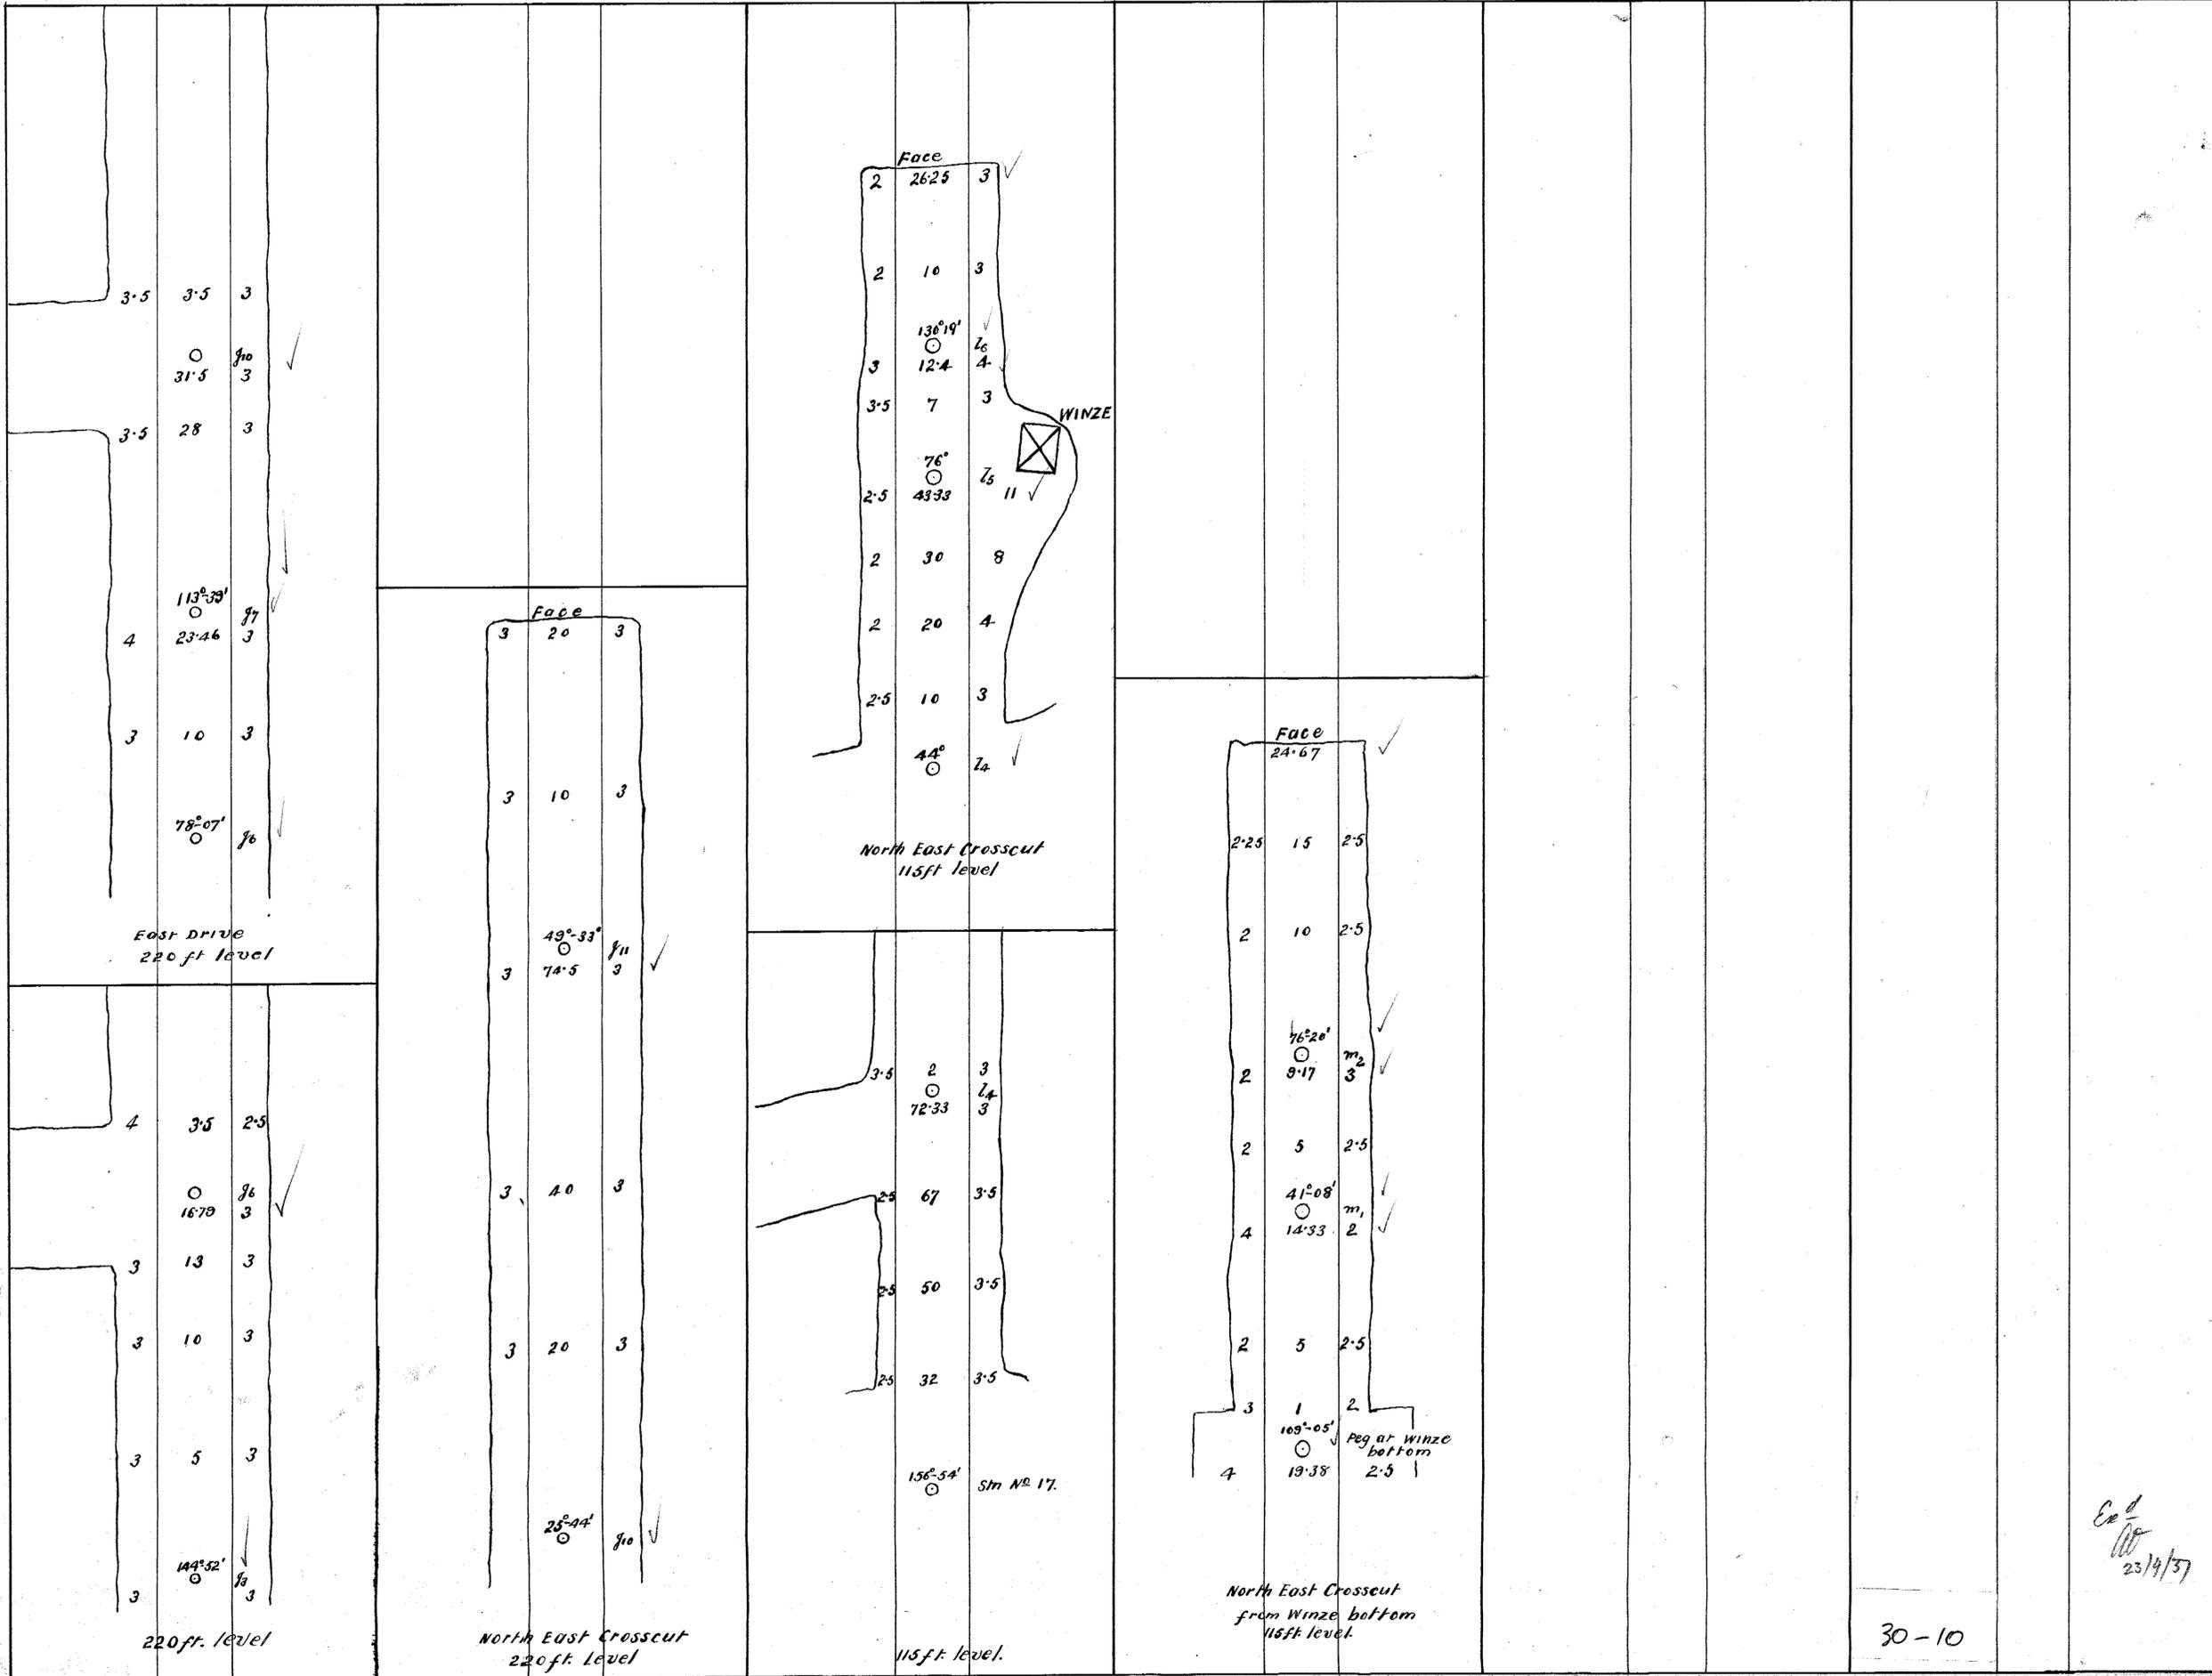

*Geo Wolfe*  
23/1/37