


5 cm


134P 5120
H. J. O'Neill
(HARD TO GET MINE)
10829 2020
N. Shepherd & C. W. Deacon
(LUCKY HIT MINE)

BRICK YARD COAL MINE. = J. Simpson & J. Shephard?
NEW BED.
DEVON.

Scale 40ft to 1 inch.

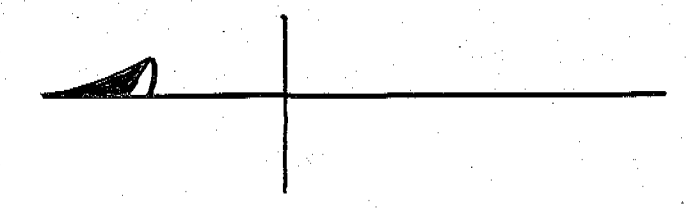

Date of Survey	Office Examination
June 1937	24.2.1937

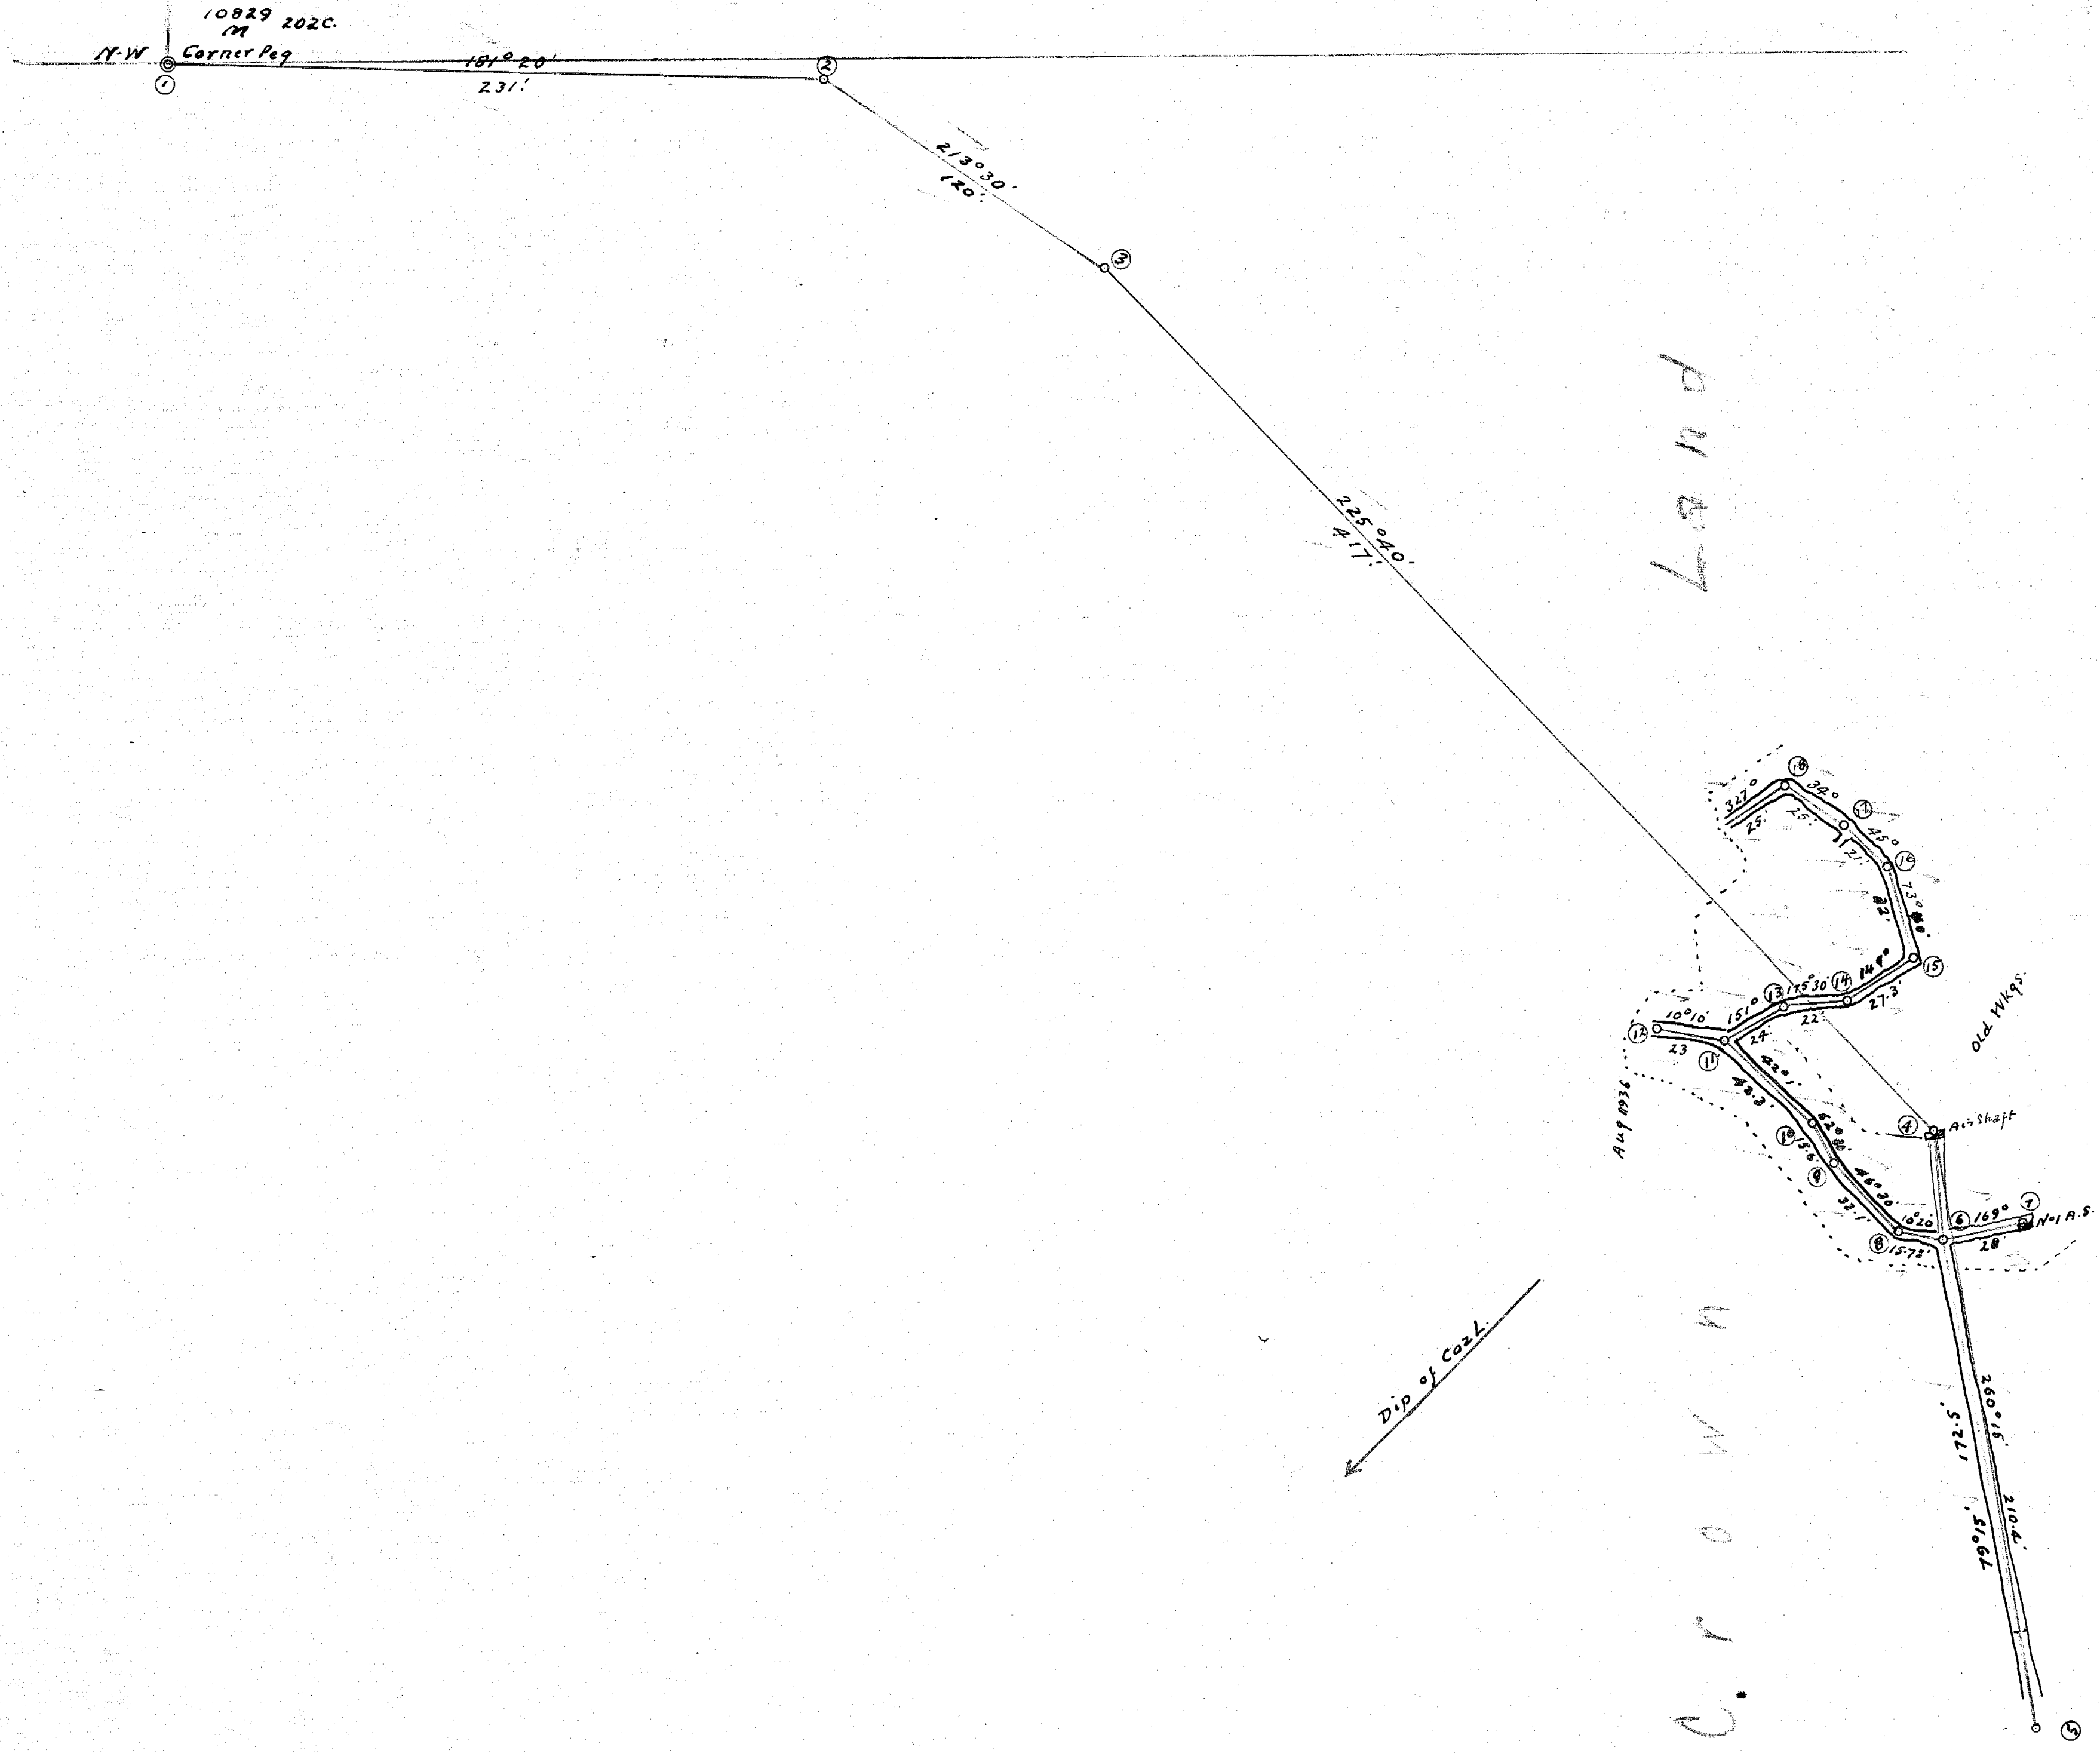

32-01