
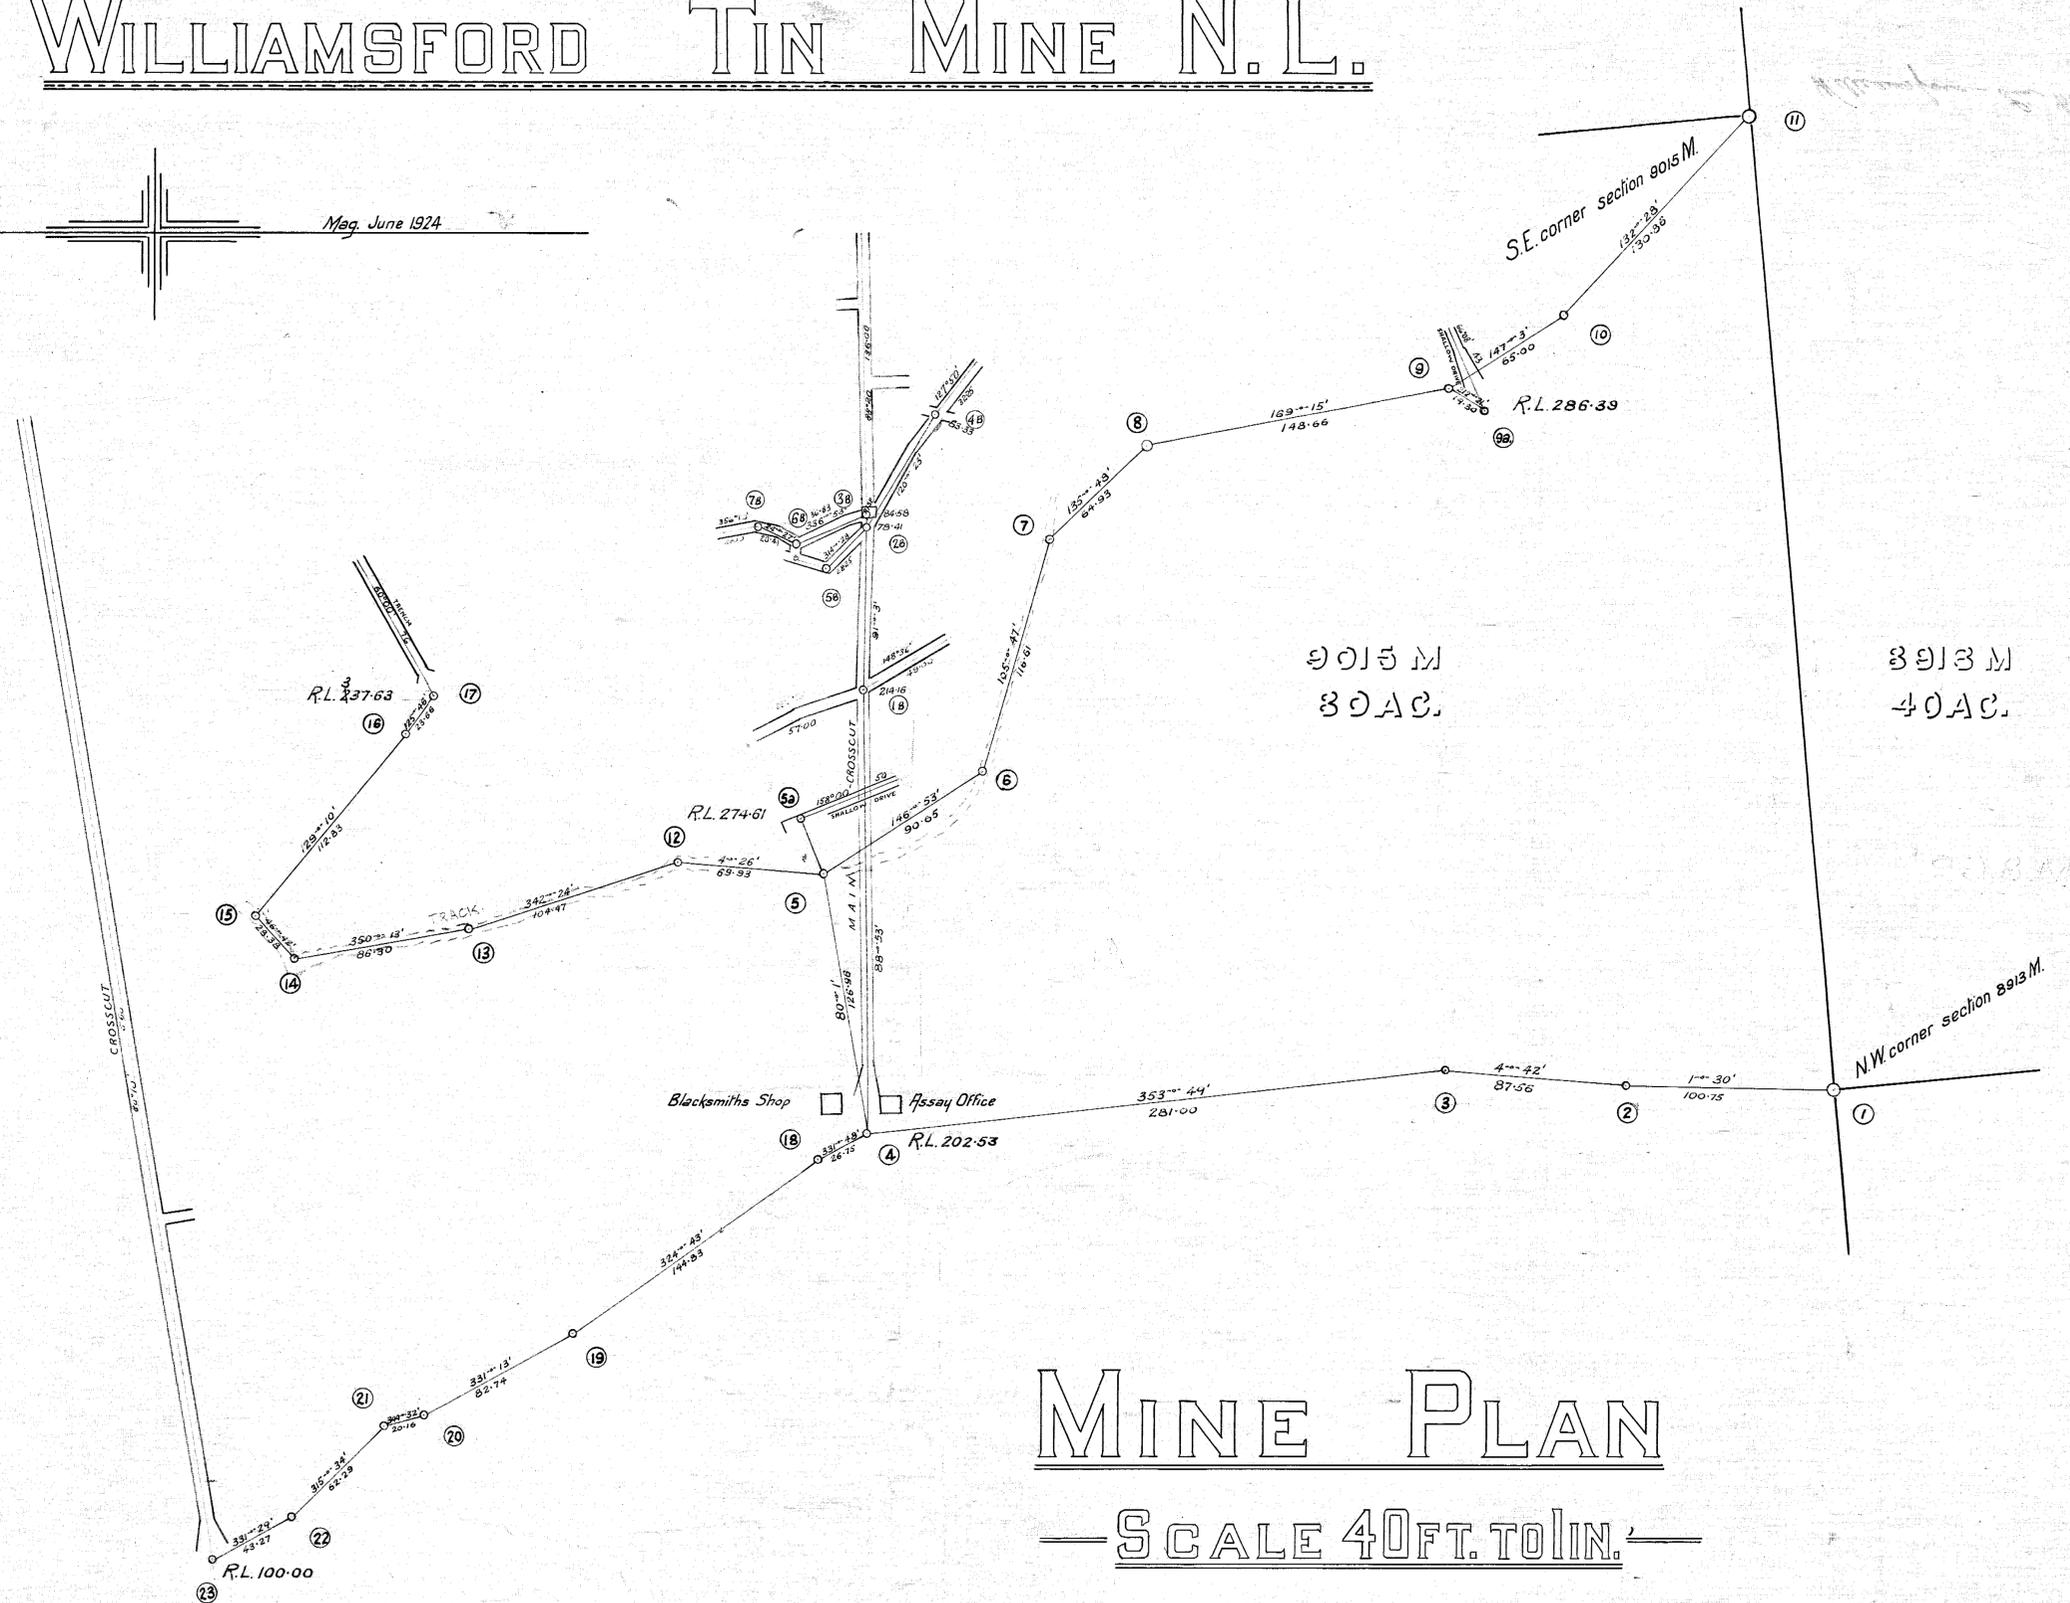


# WILLIAMSFORD TIN MINE N.L.

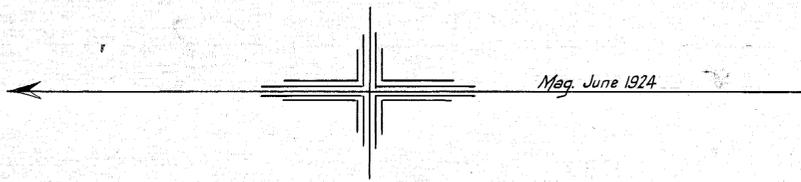

## MINE PLAN

— SCALE 40 FT. TO IN. —

Theodolite survey - June 1924  
By - F. J. Burns (Checked W. M. C. Mills)

35-01