


5 cm

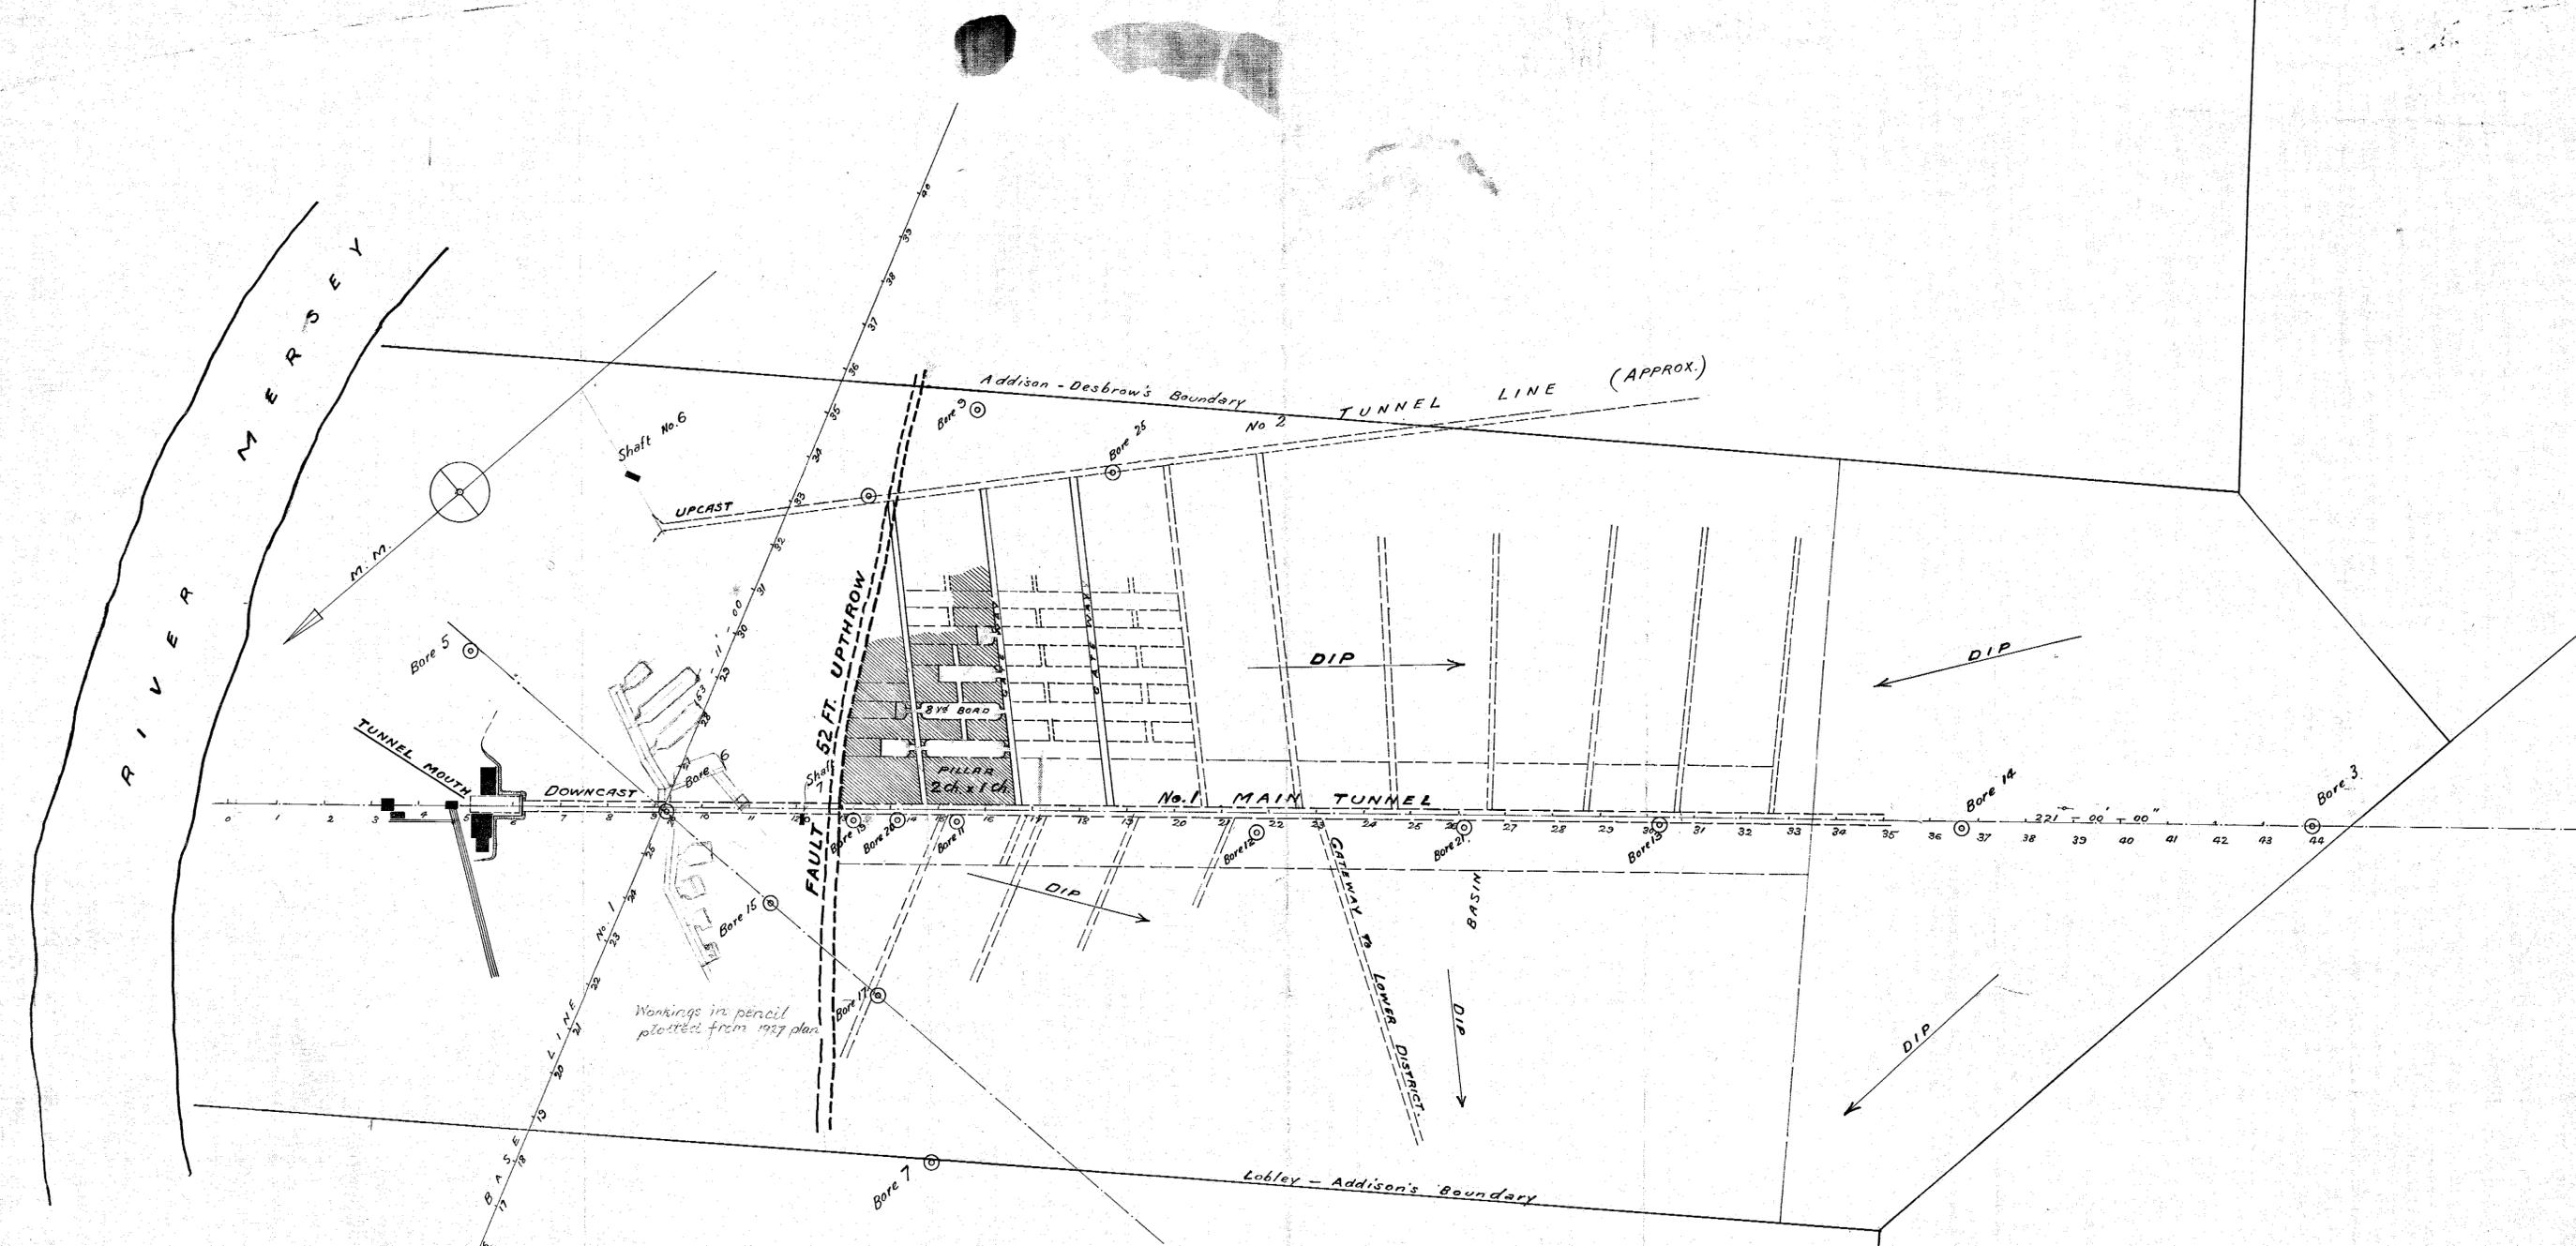

PLAN SHOWING PROPOSED METHOD OF SHALE WORKING
BORD & PILLAR ON EAST SIDE OF MAIN TUNNEL WITH
8 YARD BORDS & 8 YARD PILLARS.
PERMANENT PILLARS 2 CH^{NS} LONG & 1 CH^{NS} WIDE NEXT MAIN TUNNEL
SCALE, 2 CMS = 1 INCH
AUSTRALIAN SHALE OIL CORPORATION LTD.
LATROBE, TASMANIA.

AUGUST 18TH 1925
 W. PETRIE

36-03