

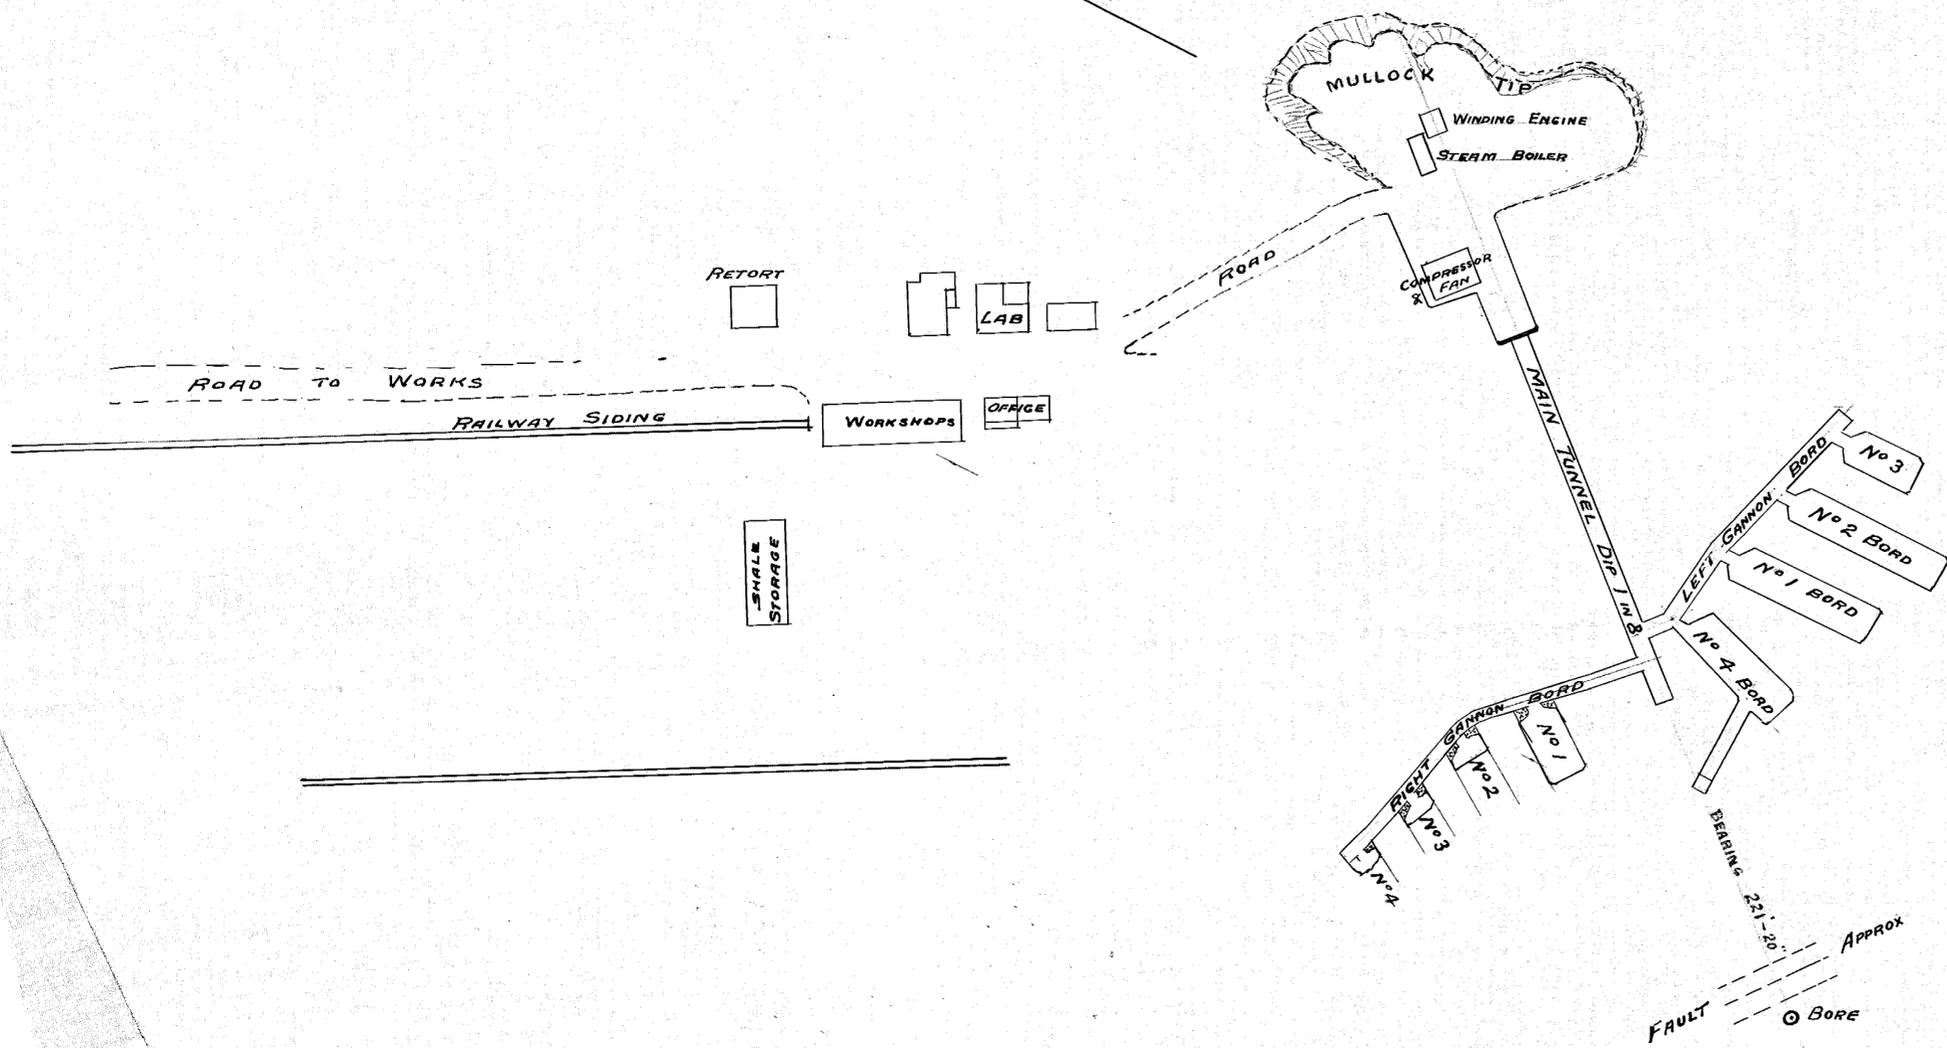


5 cm

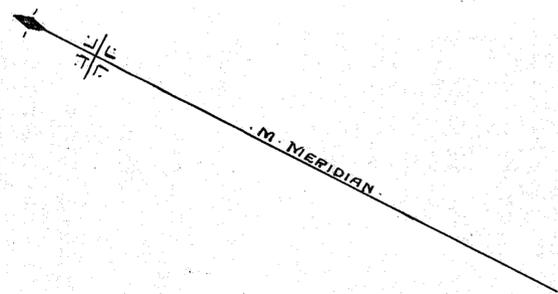

SHALE AREA WORKED -33 ACRES APPROX  
TOTAL SHALE MINED 2,190 TONS  
TO MAR 12<sup>TH</sup> 1927

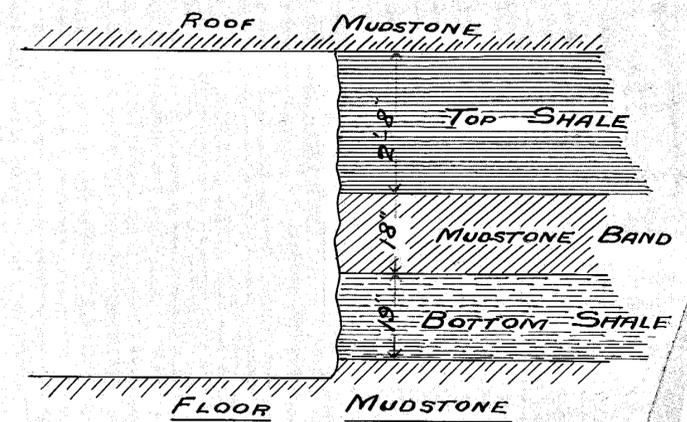


SECTION OF SEAM  
Scale 1/2" = One Foot

PLAN OF SHALE WORKINGS N° 1 TUNNEL

AUSTRALIAN SHALE OIL COR<sup>PN</sup> L<sup>TD</sup>

LATROBE MARCH 16<sup>TH</sup> 1927

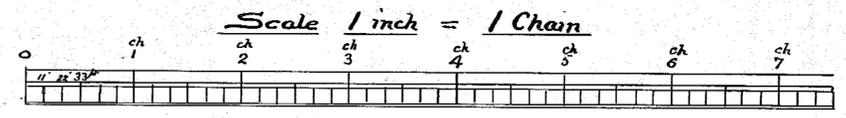

Wm Petru

36-04