


Tasmanian Cement Proprietary Limited.
Plan and Section Showing Work Done at Latrobe Shale Mine up to 31 March 1924.
Scale 40 Feet to One Inch.


Mine Manager *V. Slade*

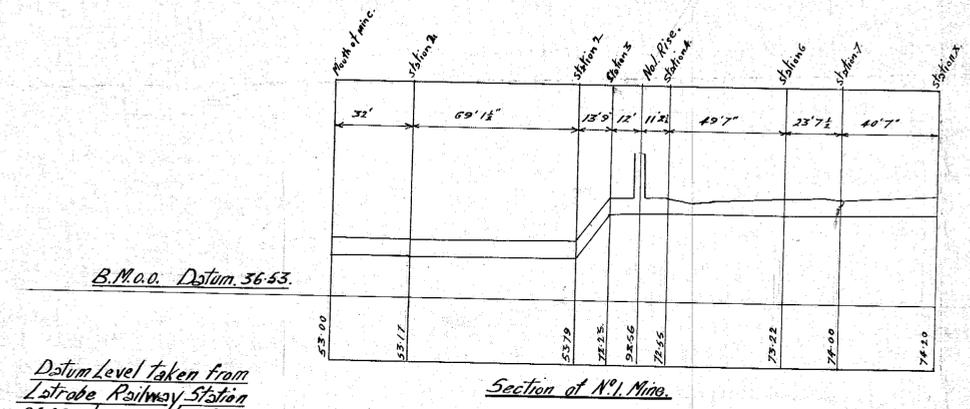


B.M.O. Datum 36.53

Datum Level Taken from Latrobe Railway Station 24.00 above sea level to B.M. N°00. 36.53 at Shale works.

Section of No. 1 Mine.

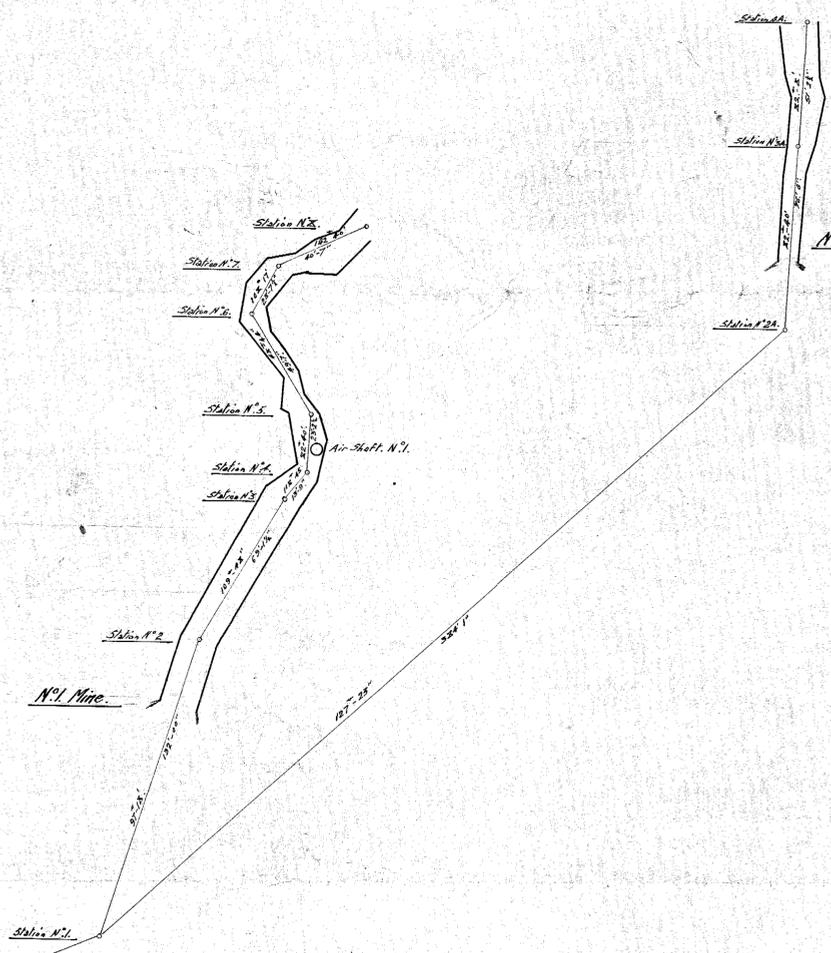

Sheet No. 1.

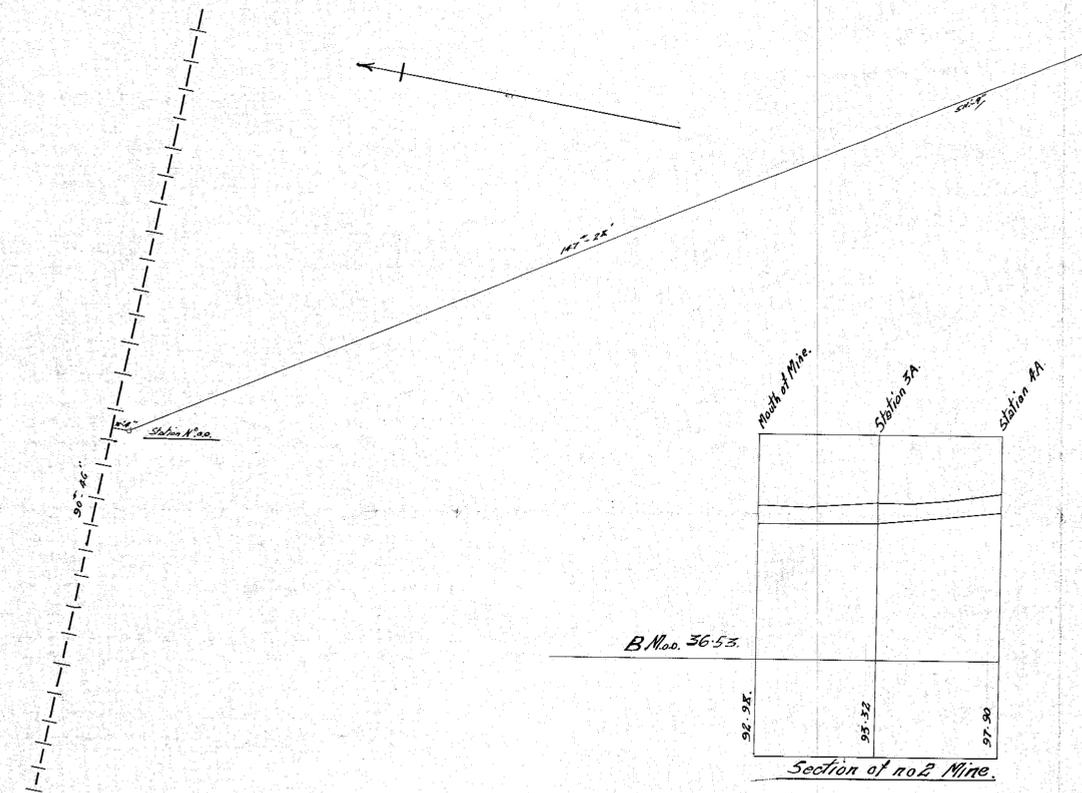

B.M.O. 36.53

Section of No. 2 Mine.

210'	Station X	6'6"	
182'-80"			
47' 7"			
30'			
40'			
10'			
5' 8"	Station 7	7' 9"	
128'-77"			
23'-7 1/2"			
50'			
6' 8"	Station 6	8'	
42'-74"			
49' 7"			
1' 9"			
1' 8"			
1' 11"			
2' 6"			
1' 2"	Station 5	5' 7"	
32'-40"			
23'-2 1/2"			
4'	10'	6'	Rise to Surface
6' 8"	Station 4	5' 3"	Top of Shaft
128'-85"			
13'-9"			
100'	Station 3A	5' 9"	
100'-85"			
5' 10 1/2"			
2'			
3'			
10'			
48'	Station 2A	7'	
82'-40"			
77' 6"			
63'			
46'			
22'			
56'			
Station 2A			
122'-23"			
328'-1'			
Station 1			
147'-22"			
41'-9"			
Station 1			
Station 0.0			

From Station N.1 to Station 2A in N.2 Mine.

From Station 0.0 on E.W. Boundary of District 65-acre block to Station N.1 in N.1 mine.

V. Slade
S.S.B.A.