



5 cm

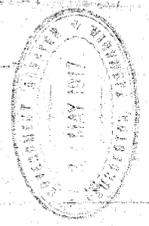

©N°3 Bore

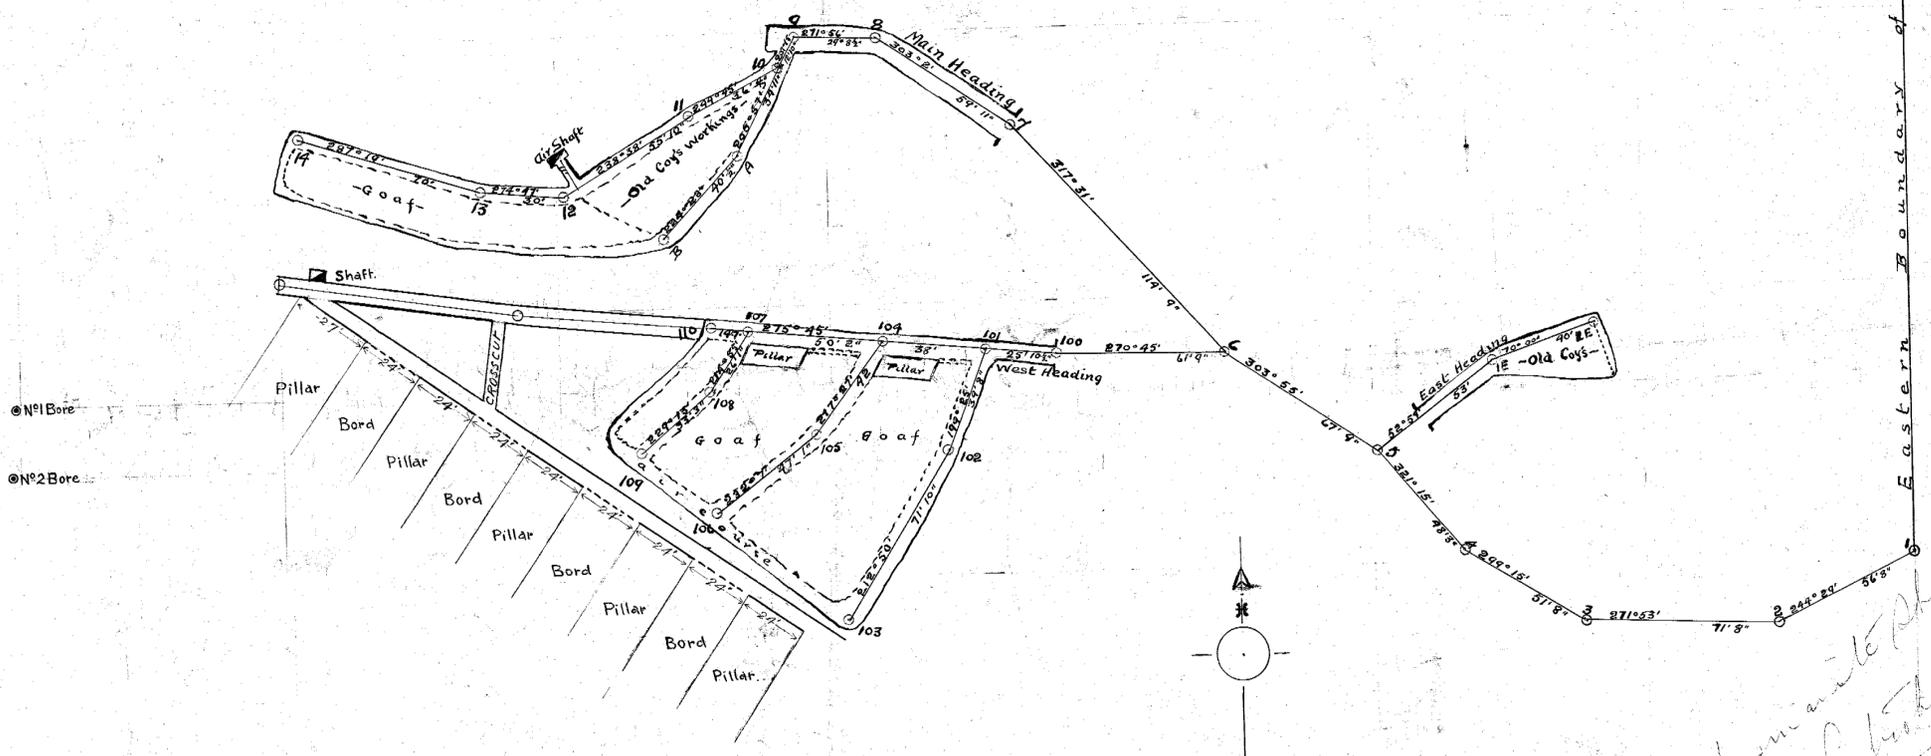

©N°1 Bore

©N°2 Bore

Outcrop

PLAN

Railton Latrobe Shale Oil Coys Mine

Scale 1 inch = 40 feet

5" Froughton + Simms No 31-12-1916 *Ranfitt*

*Laminated Shale
Latrobe*

3
227

36-07

Railton
Latrobe
Shale Mine
31-12-16

2
227