



5 cm

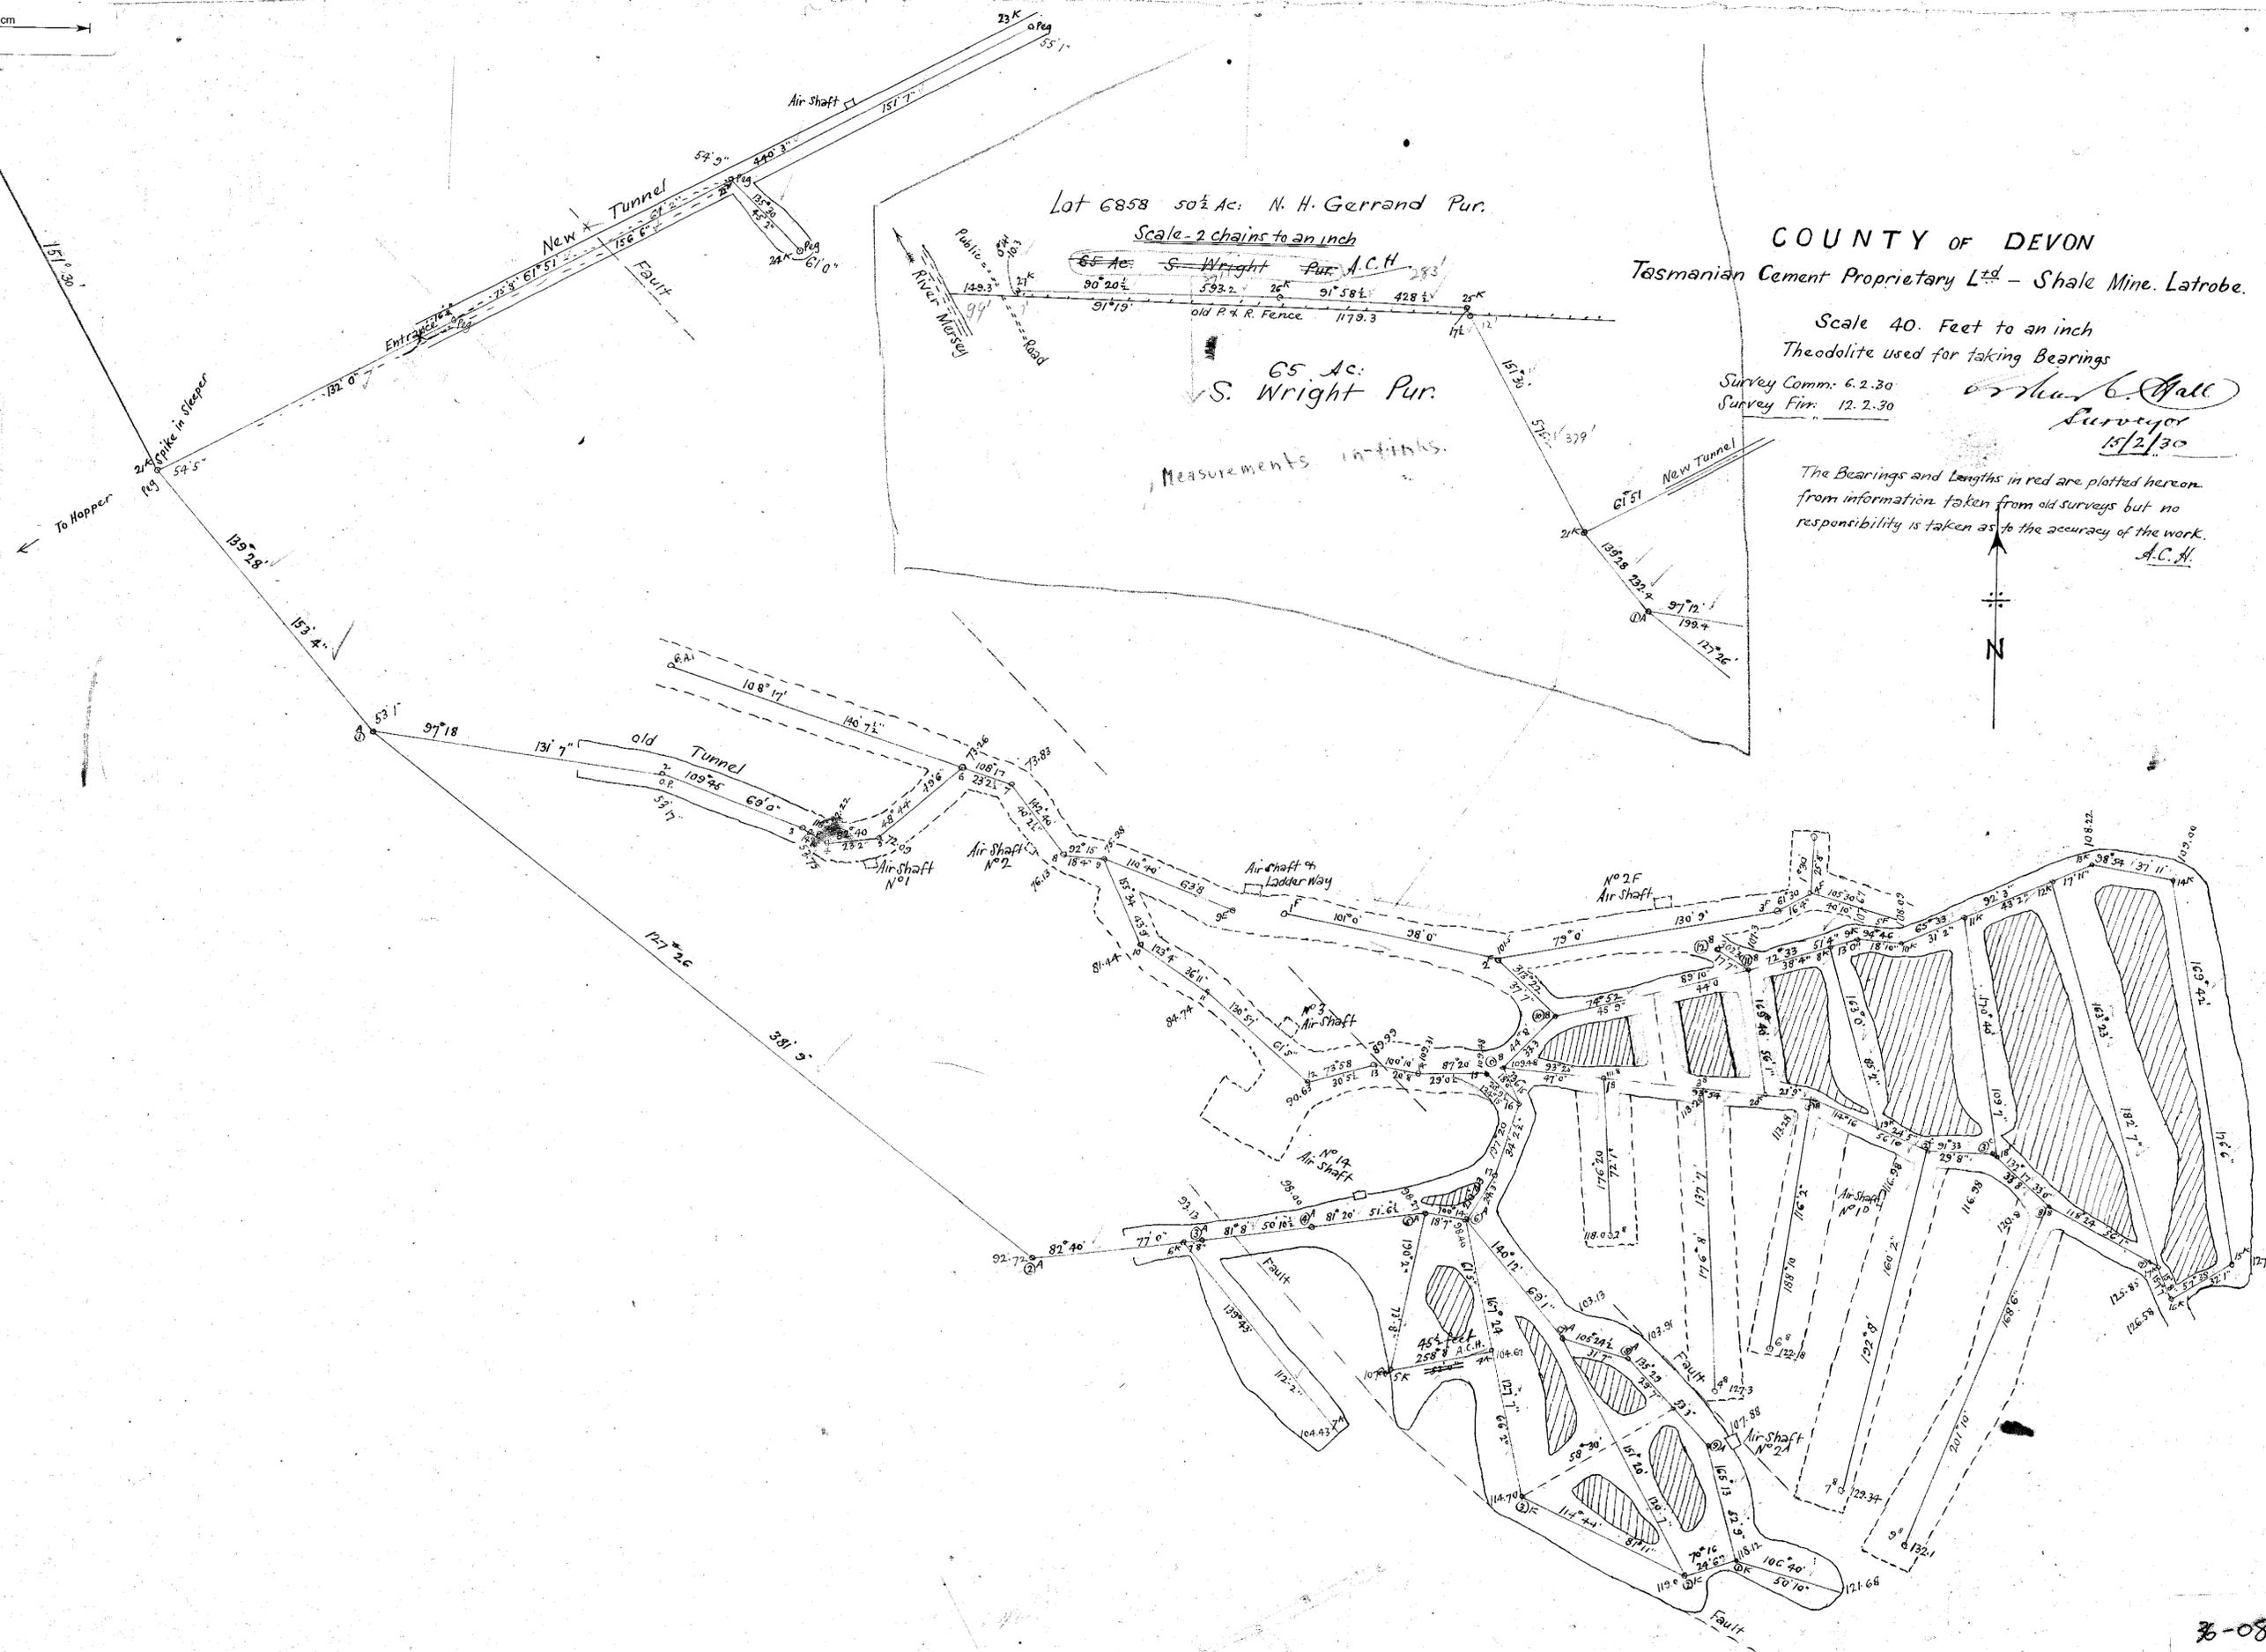

Lot 6858 50 1/2 Ac. N. H. Gerrard Pur.

Scale - 2 chains to an inch

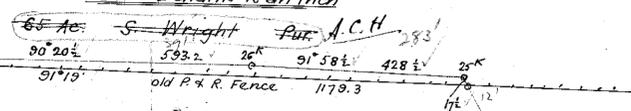

65 Ac. S. Wright Pur.

Measurements in italics.

COUNTY OF DEVON

Tasmanian Cement Proprietary Ltd - Shale Mine. Latrobe.

Scale 40. Feet to an inch  
Theodolite used for taking Bearings

Survey Comm. 6.2.30  
Survey Fin. 12.2.30

*Arthur C. Hall*  
Surveyor  
15/2/30

The Bearings and Lengths in red are plotted hereon from information taken from old surveys but no responsibility is taken as to the accuracy of the work.  
A.C.H.



Handwritten notes on the right margin.

Handwritten notes at the bottom right corner.