


County of Devon
Vicinity of Latrobe
Scale 2 chns to an inch.


Goliath Portland Cement Co Ltd Shale Mine

A.C. Hall
Surveyor
9/6/30

Lot 6858 50 1/2 Ac. N. H. Gerrard Pur

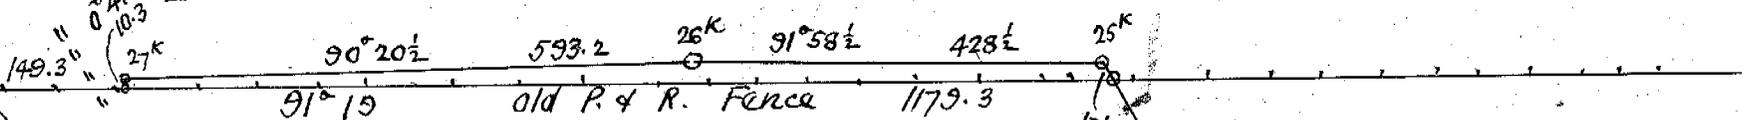



old P & R. Fence

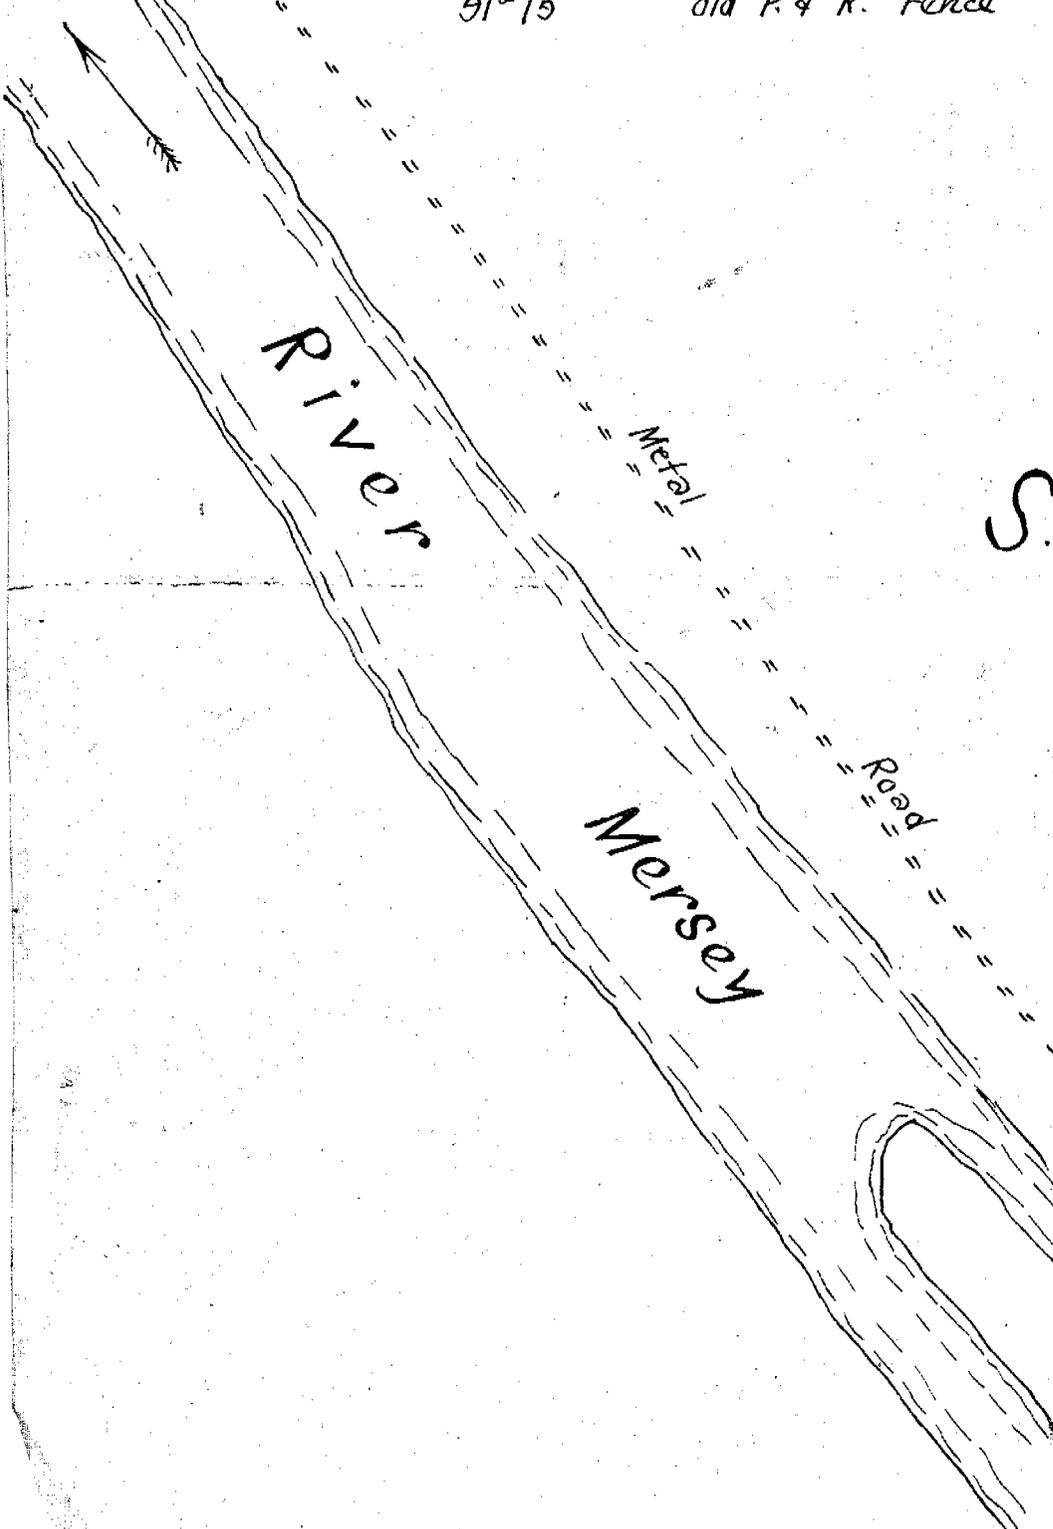

65 AC:

S. Wright Pur

Connection

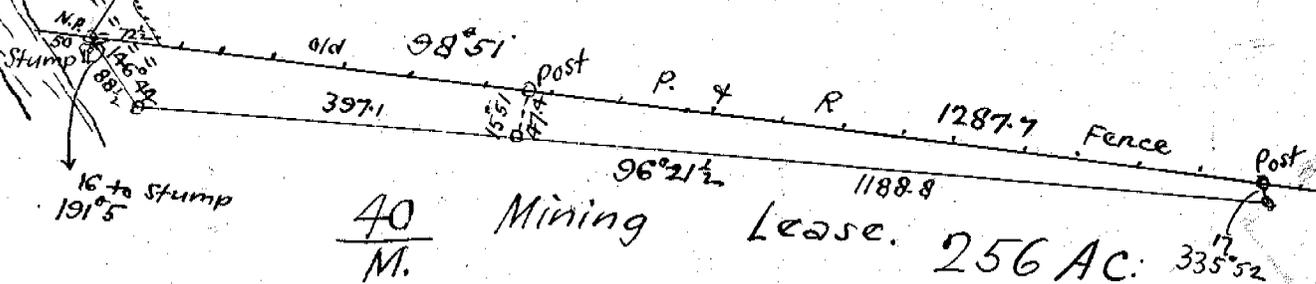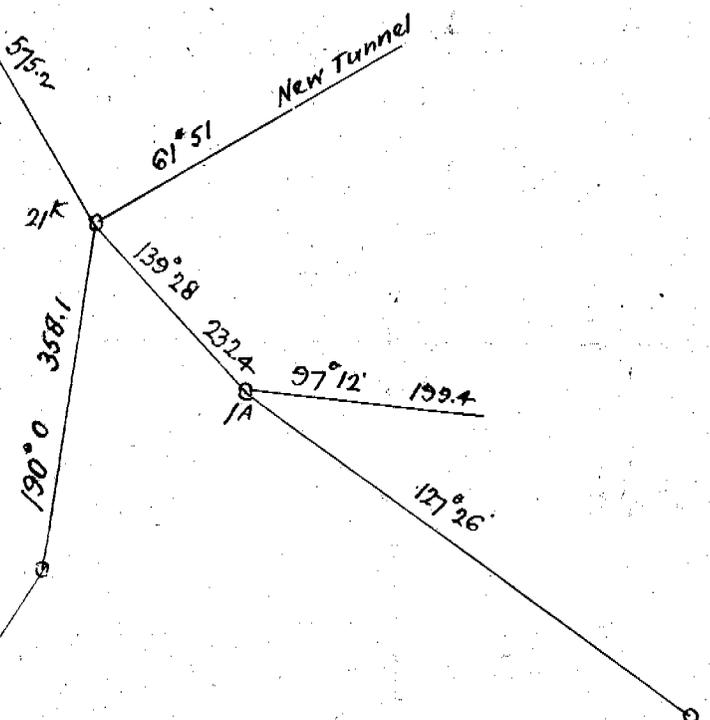

40 M. Mining Lease. 256 AC: