


5 cm

Date of Survey	Office Examination
Apr. 1896	2. 1927
Mar. 1897	3. 1928

37-01

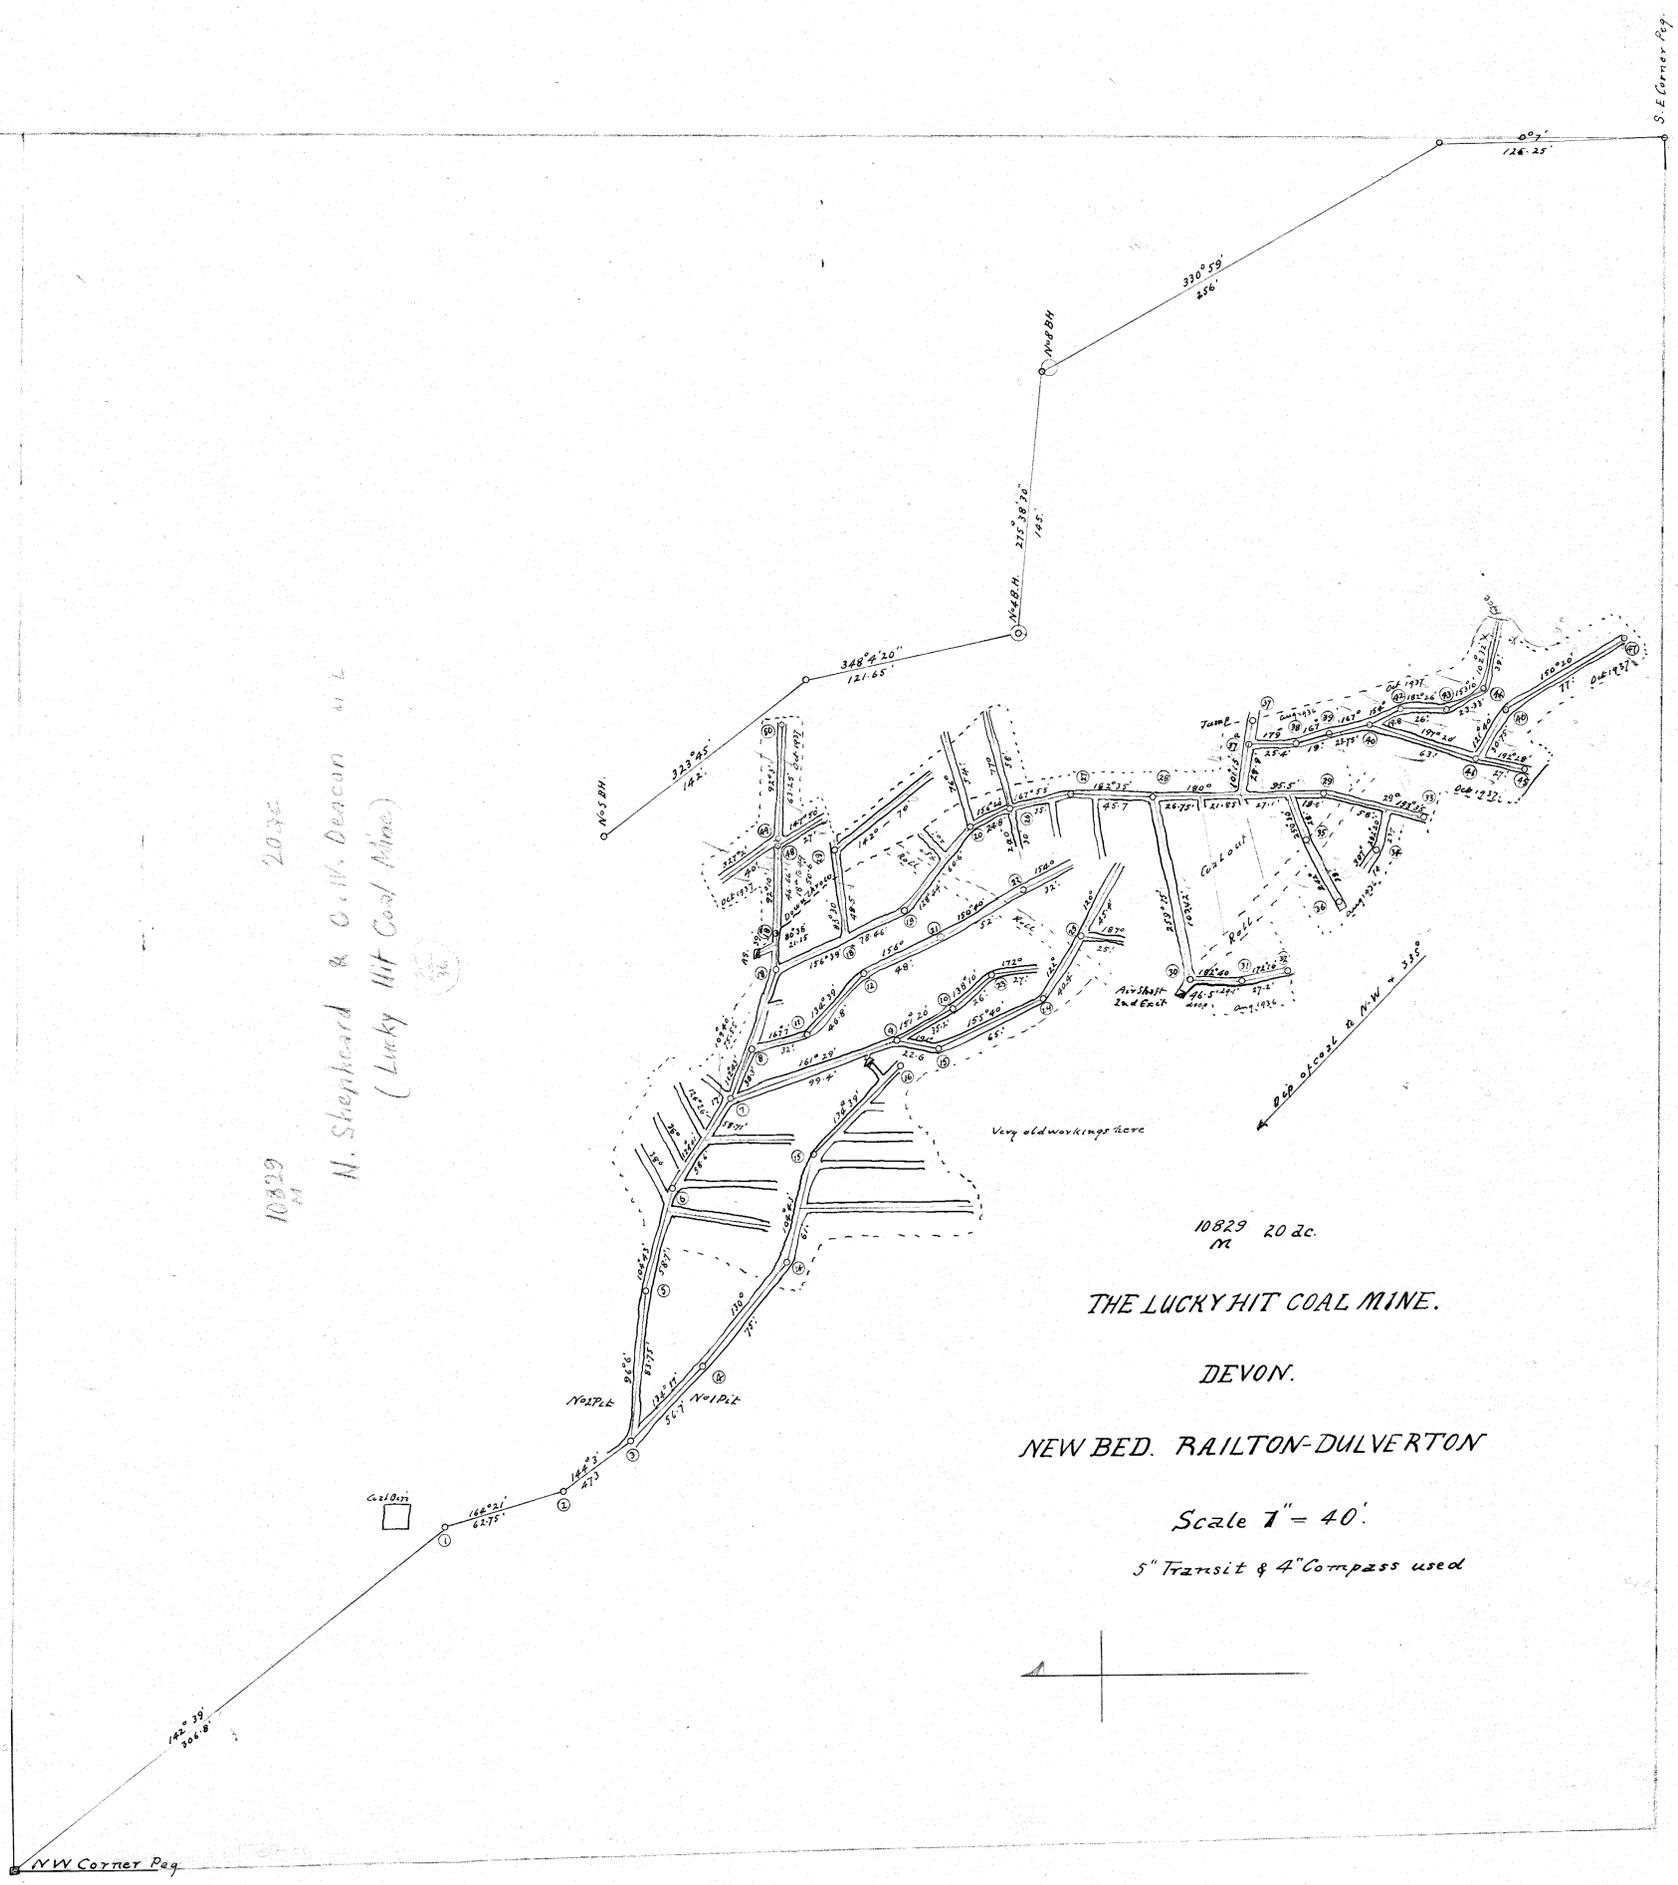

10829
21
20.25
N. Shephard & C. W. Deacon & L.
(Lucky Hit Coal Mine)

10829 20 ac.
M.
THE LUCKY HIT COAL MINE.
DEVON.
NEW BED. RAILTON-DULVERTON
Scale 1" = 40'.
5" Transit & 4" Compass used

Revised by Aug. 1926
F. J. P. ...
...
...
...
...