


5 cm

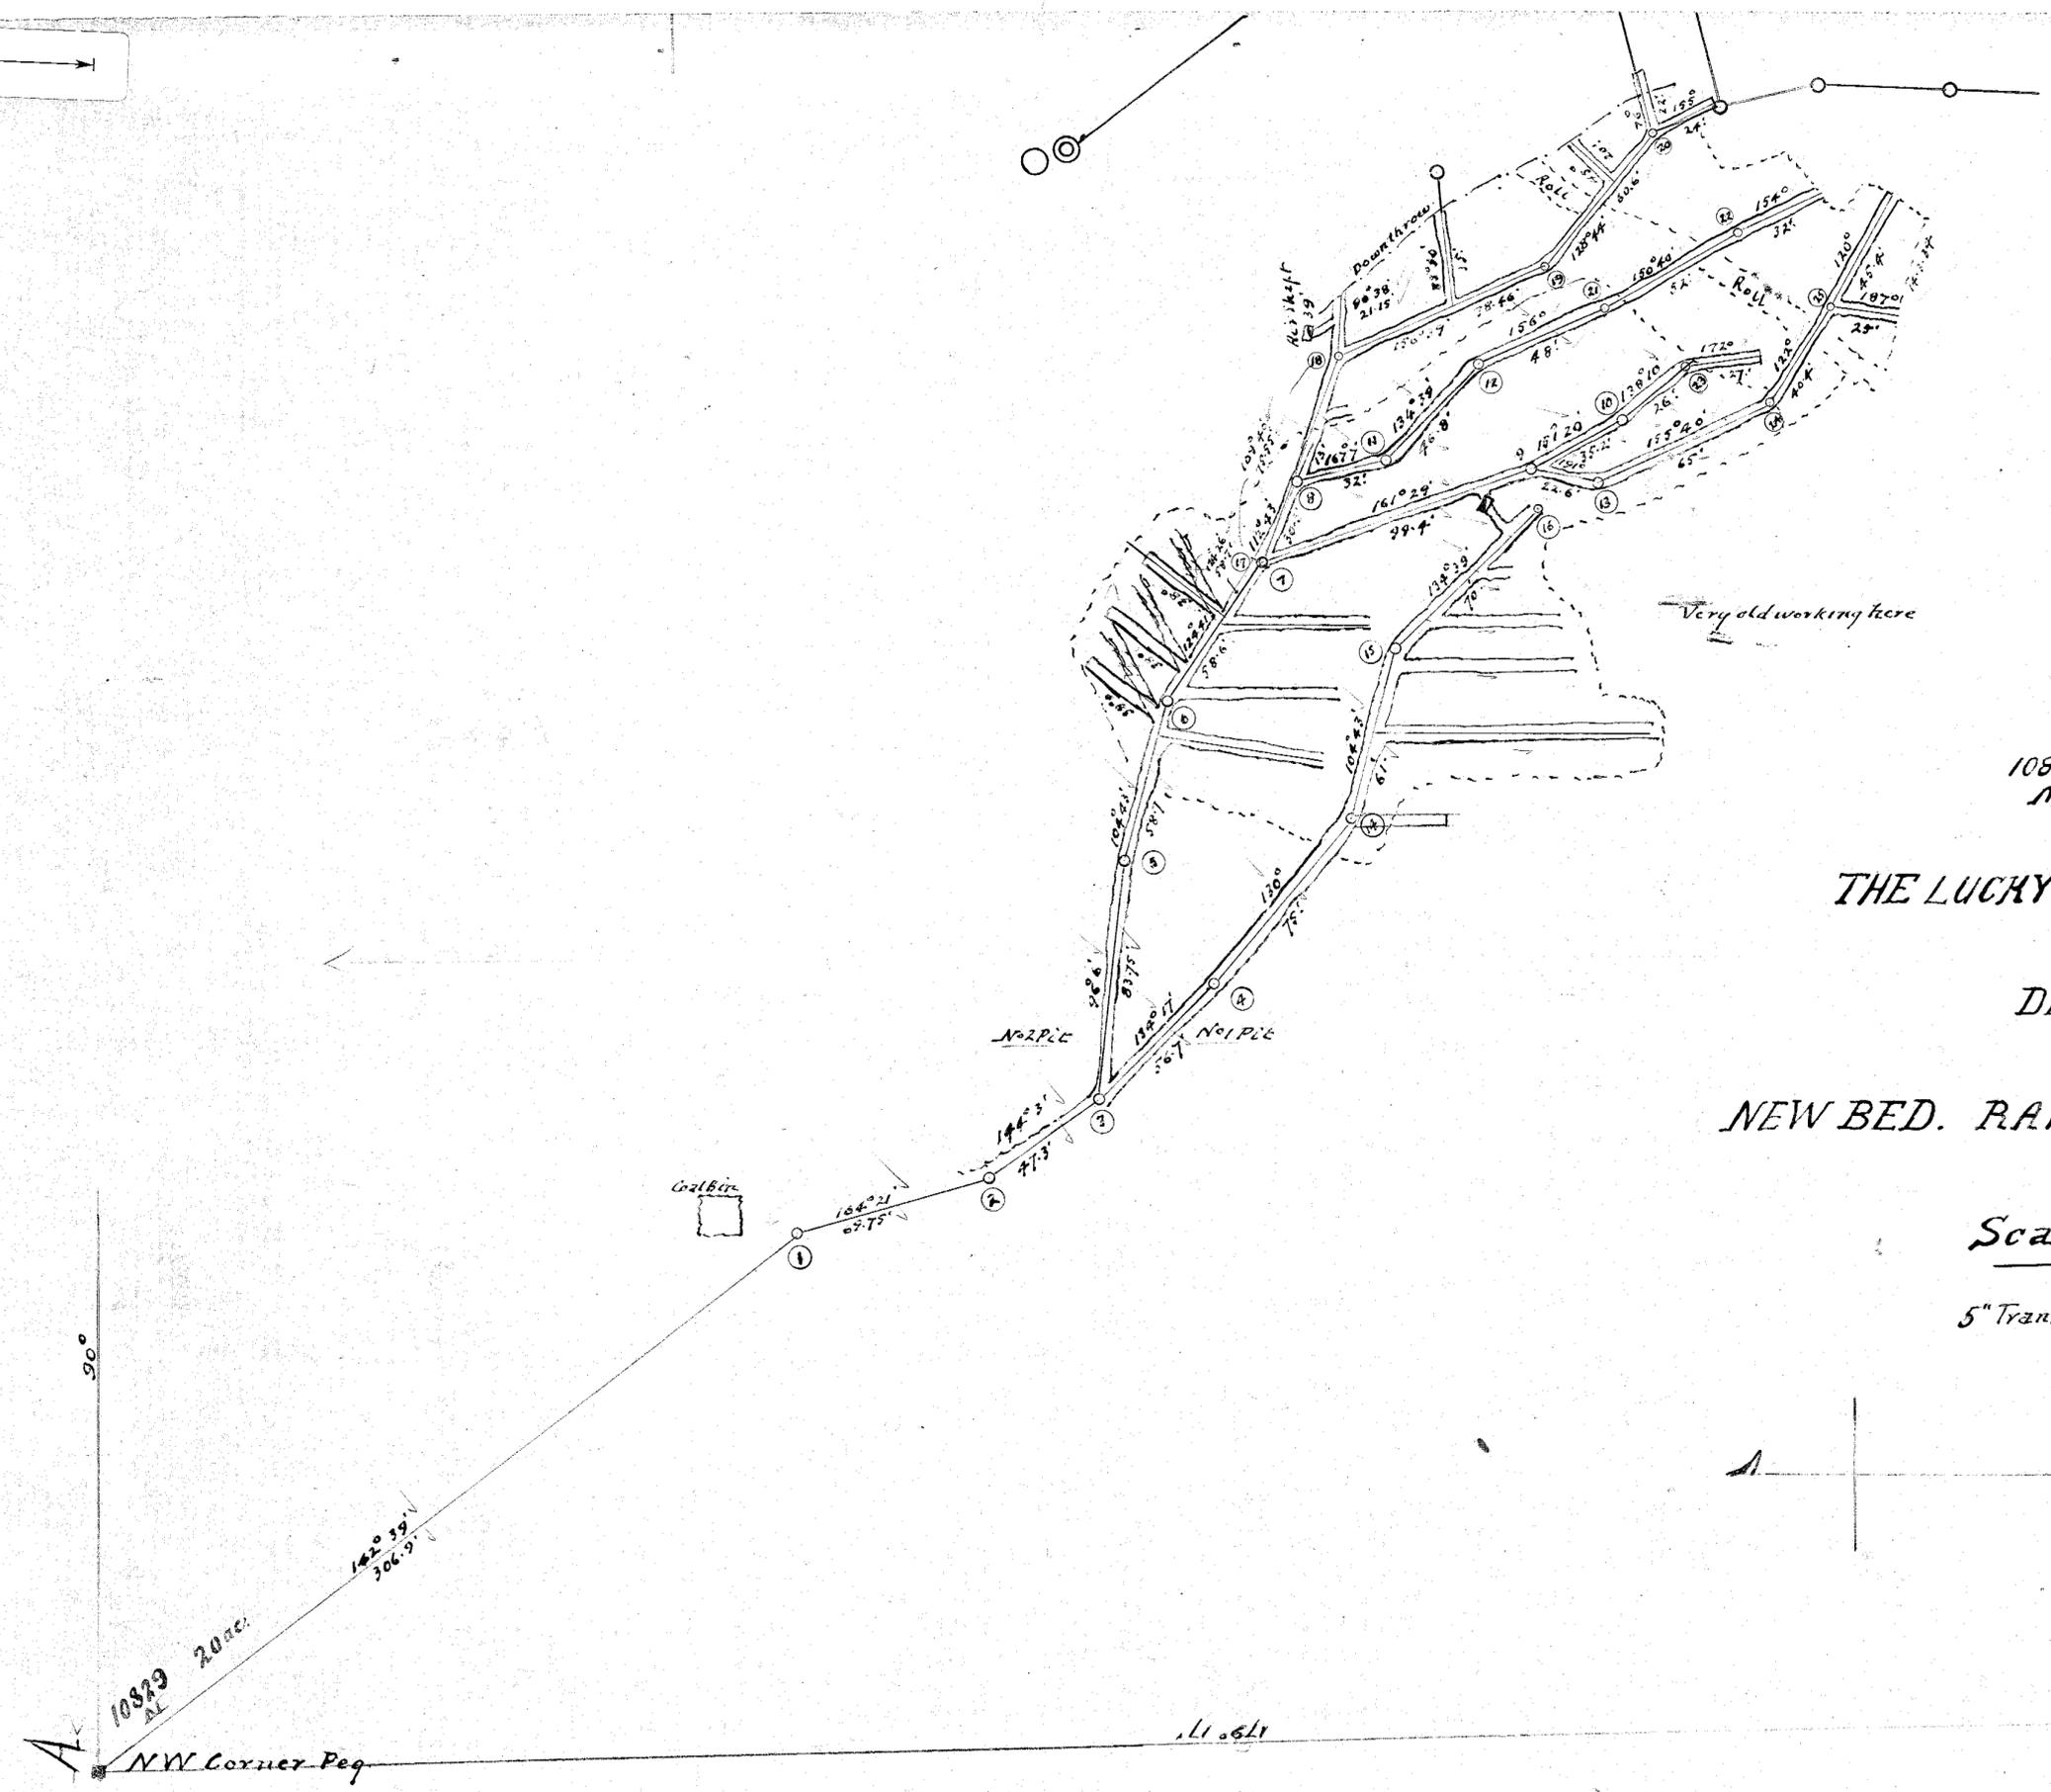

10829 20 ac N. Shephard + C.W. Deacon
M

THE LUCKY HIT COAL MINE

DEVON.

NEW BED. RAILTON-DULVERTON.

Scale 1" = 40'

5" Transit + 4" Compass used.

Plotted & E.C. d
 9/16/33
 " O.P. 16/4/34
 " O.P. 3/7/35

H. A. Vandocum.
 Inspector of Mines
 May 1935