


5 cm

The Lucky Hit Coal Mine
 DEVON
 New Bed Raitlin-Dulverton
 Scale 40 feet to 1 inch

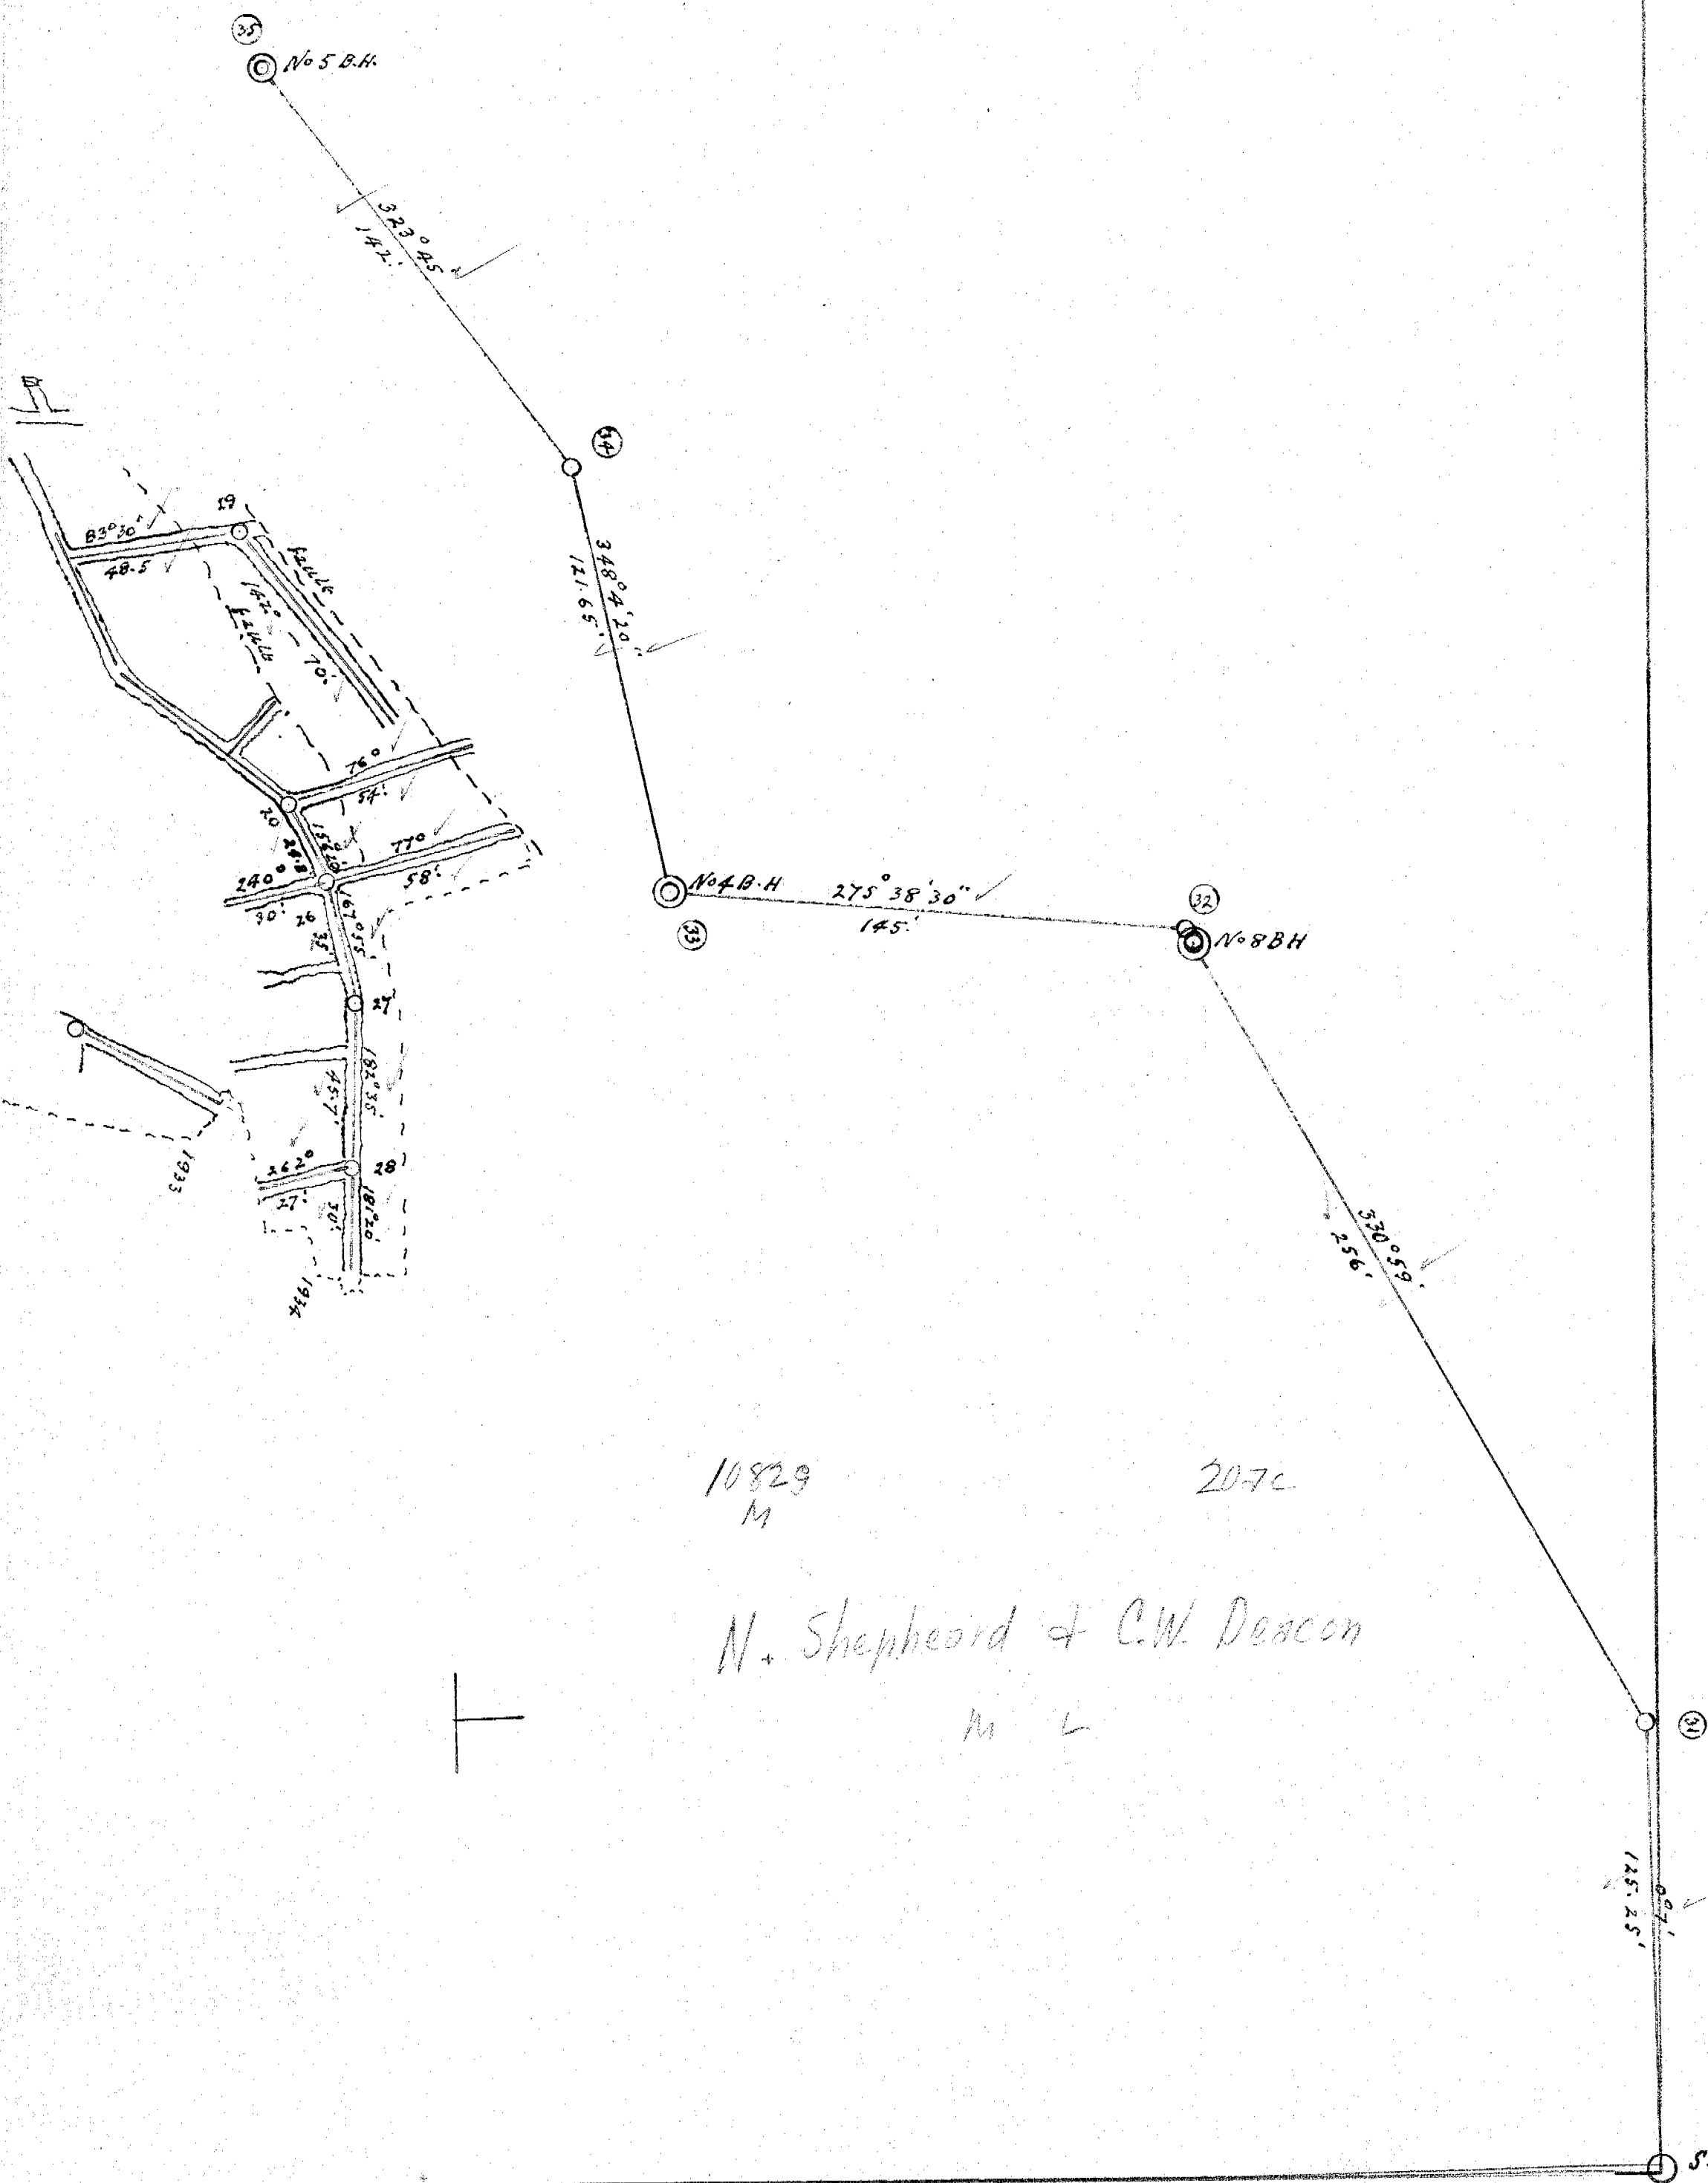

10829
M

207c

N. Shephard & C.W. Dawson

M L

37-03

Ex. 1 de
 31/7/25