


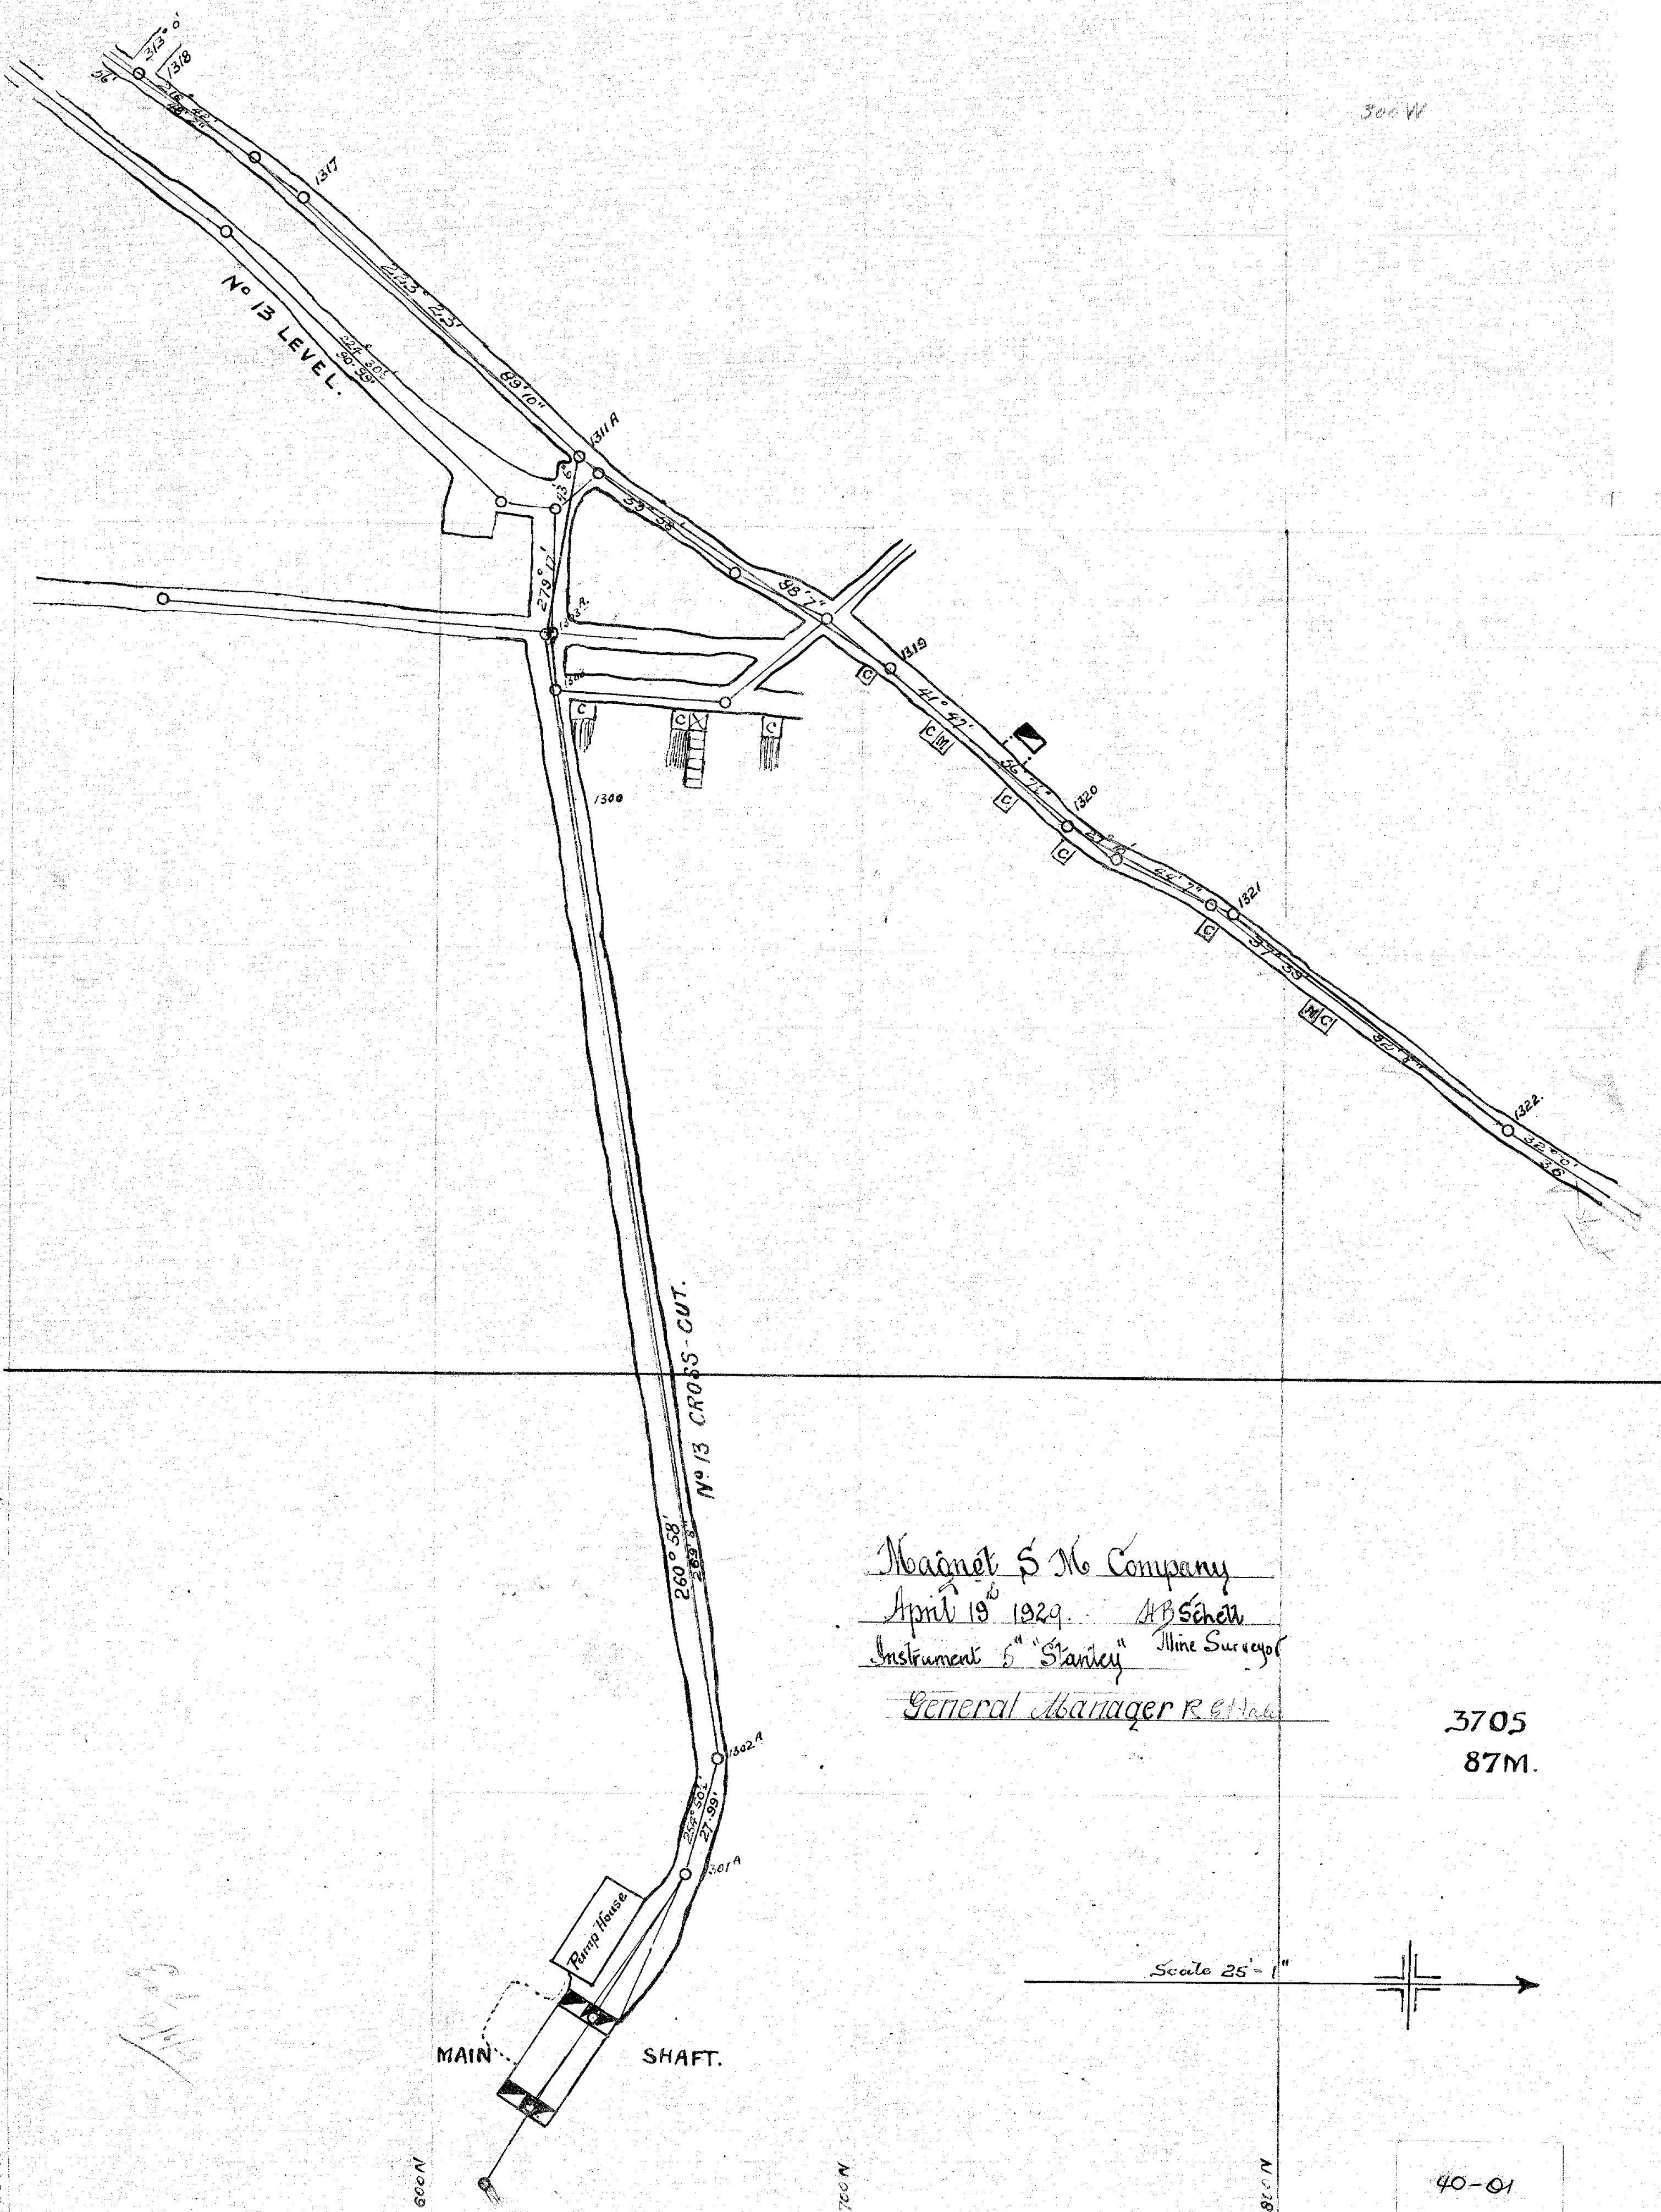

Mainet S No Company
April 19th 1929. AB Schen
Instrument 6" Stanley Mine Surveyor
General Manager R. E. Hall

3705
87M.

3838
M.

1827
93M.

5 cm

40-01