


40-04 40-05

100 W.

WESTERN BOUNDARY LEASE ³⁷⁰⁵~~87M.~~ NO.

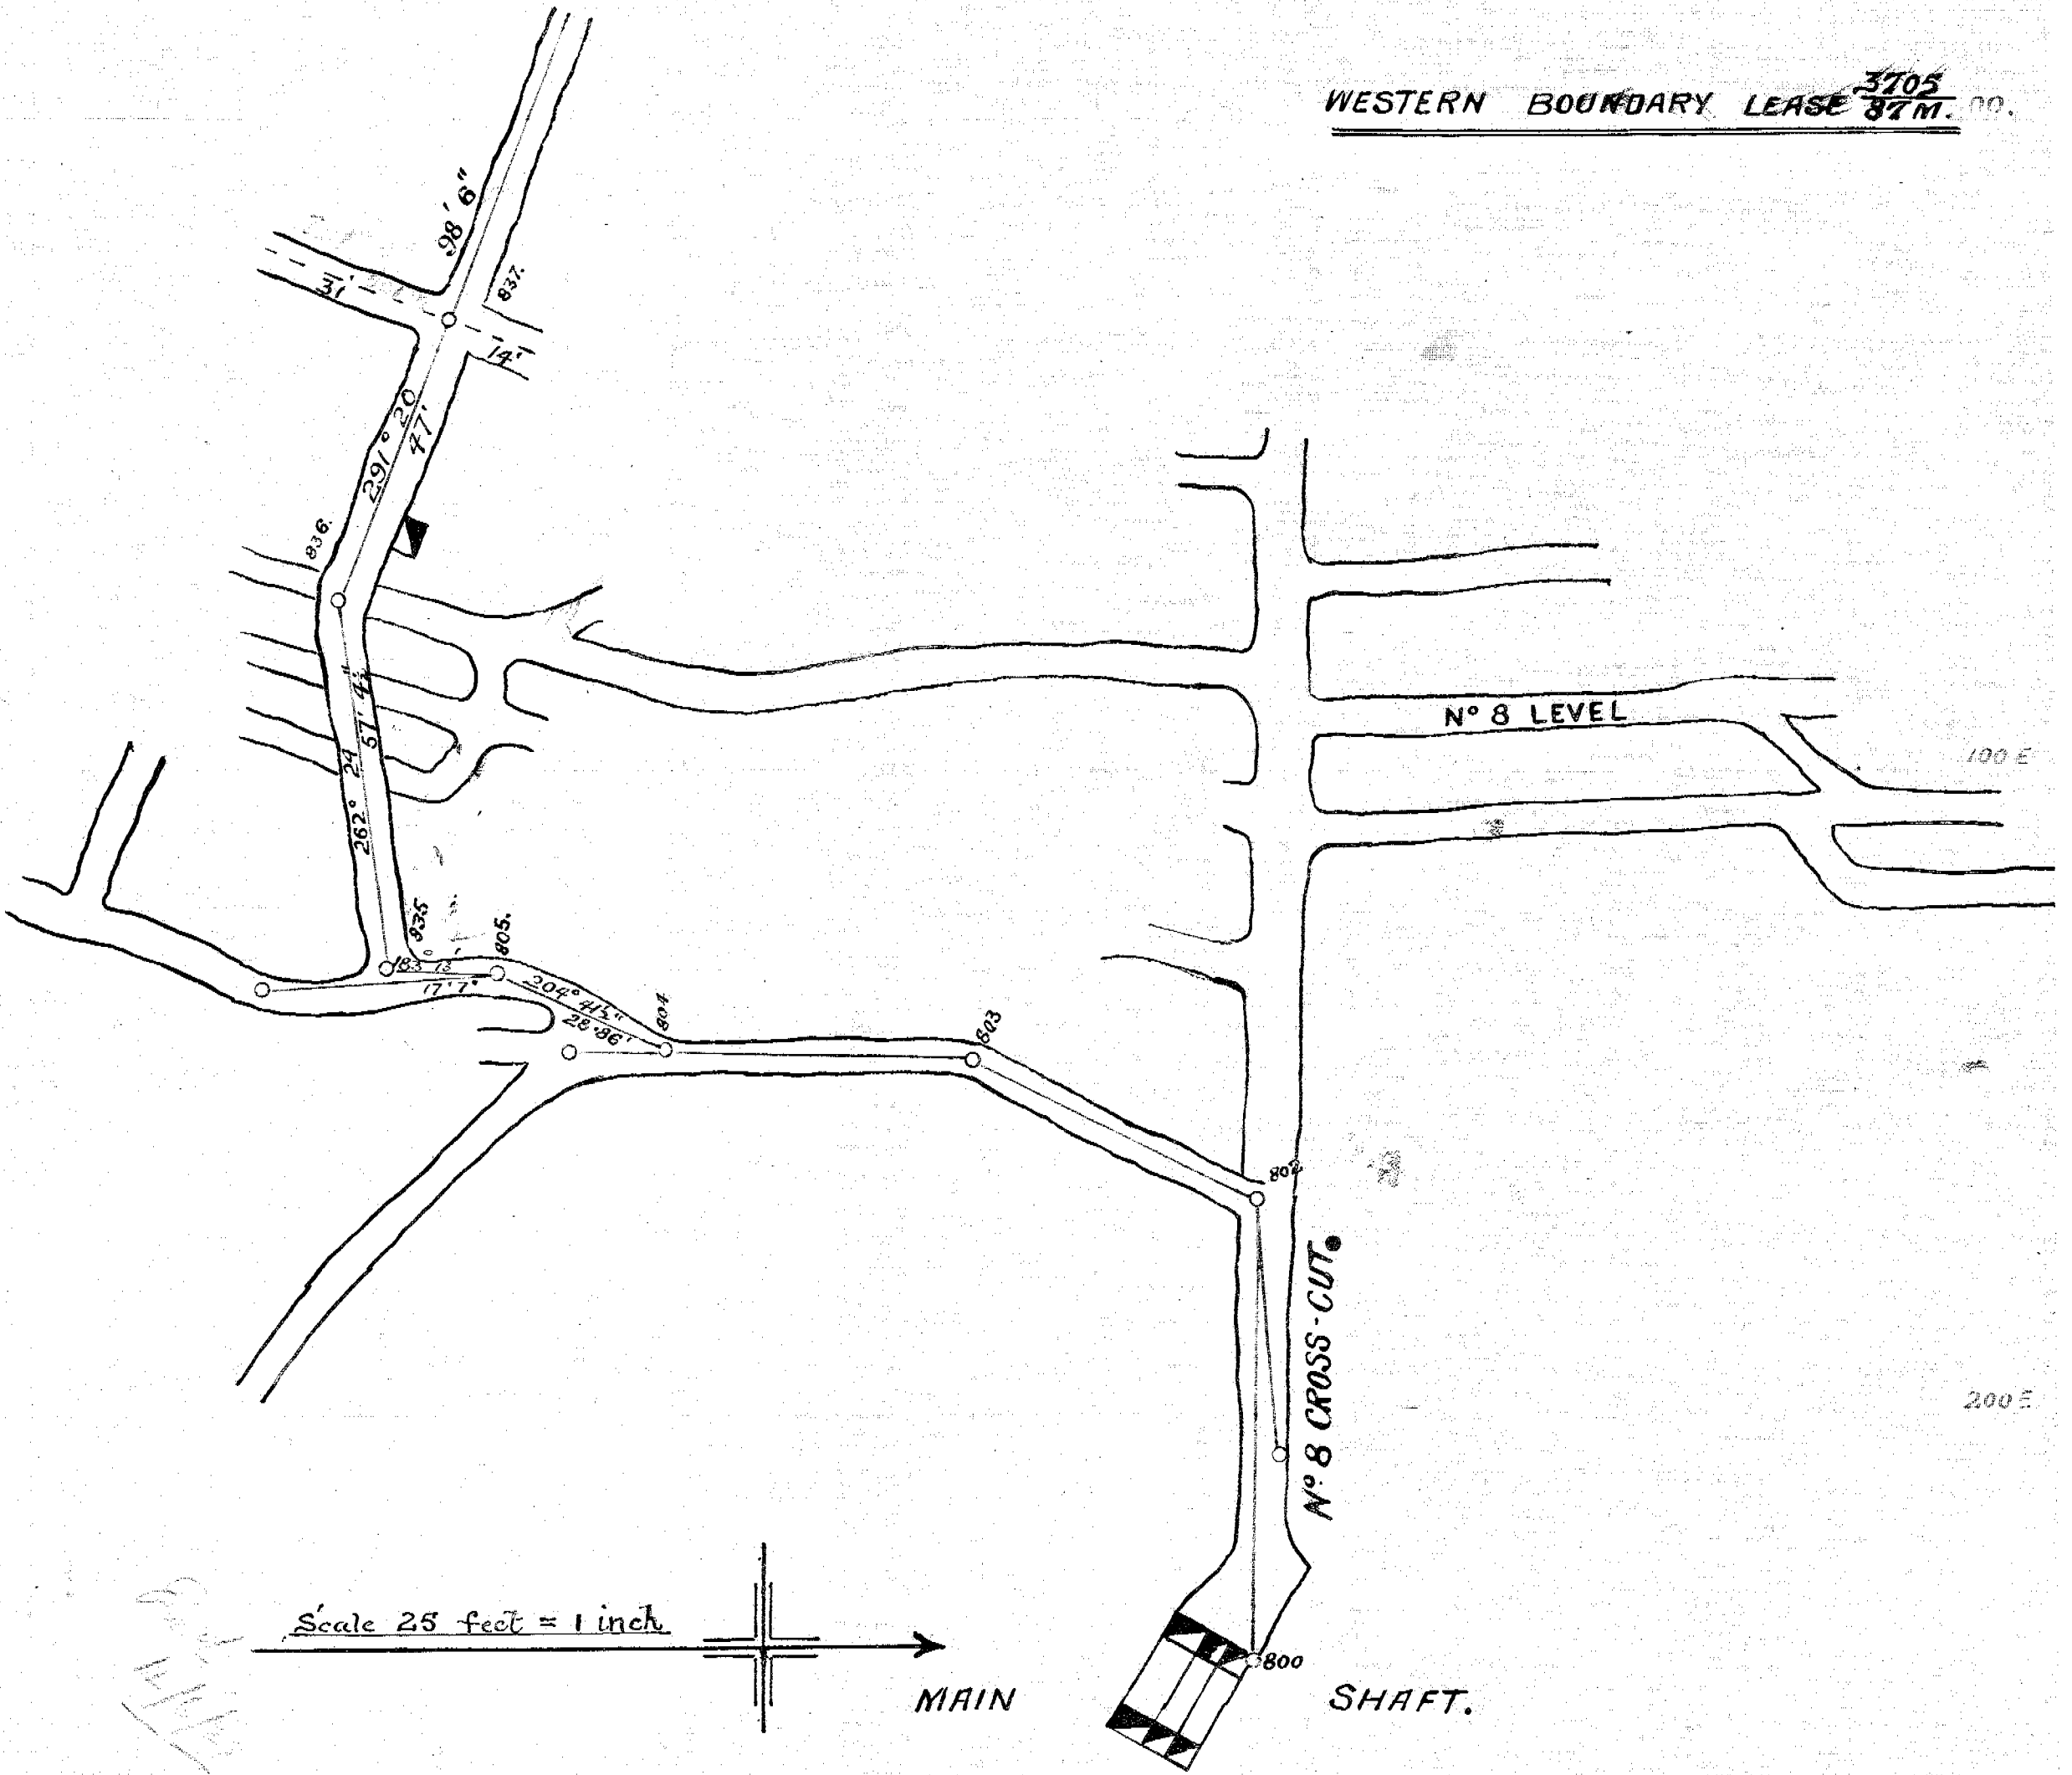

Magnet S M Company

April 19th 1929

H.B. Schenck

Mine Surveyor.

Instrument 5" Stanley

General Manager

29 Hales

40-05