



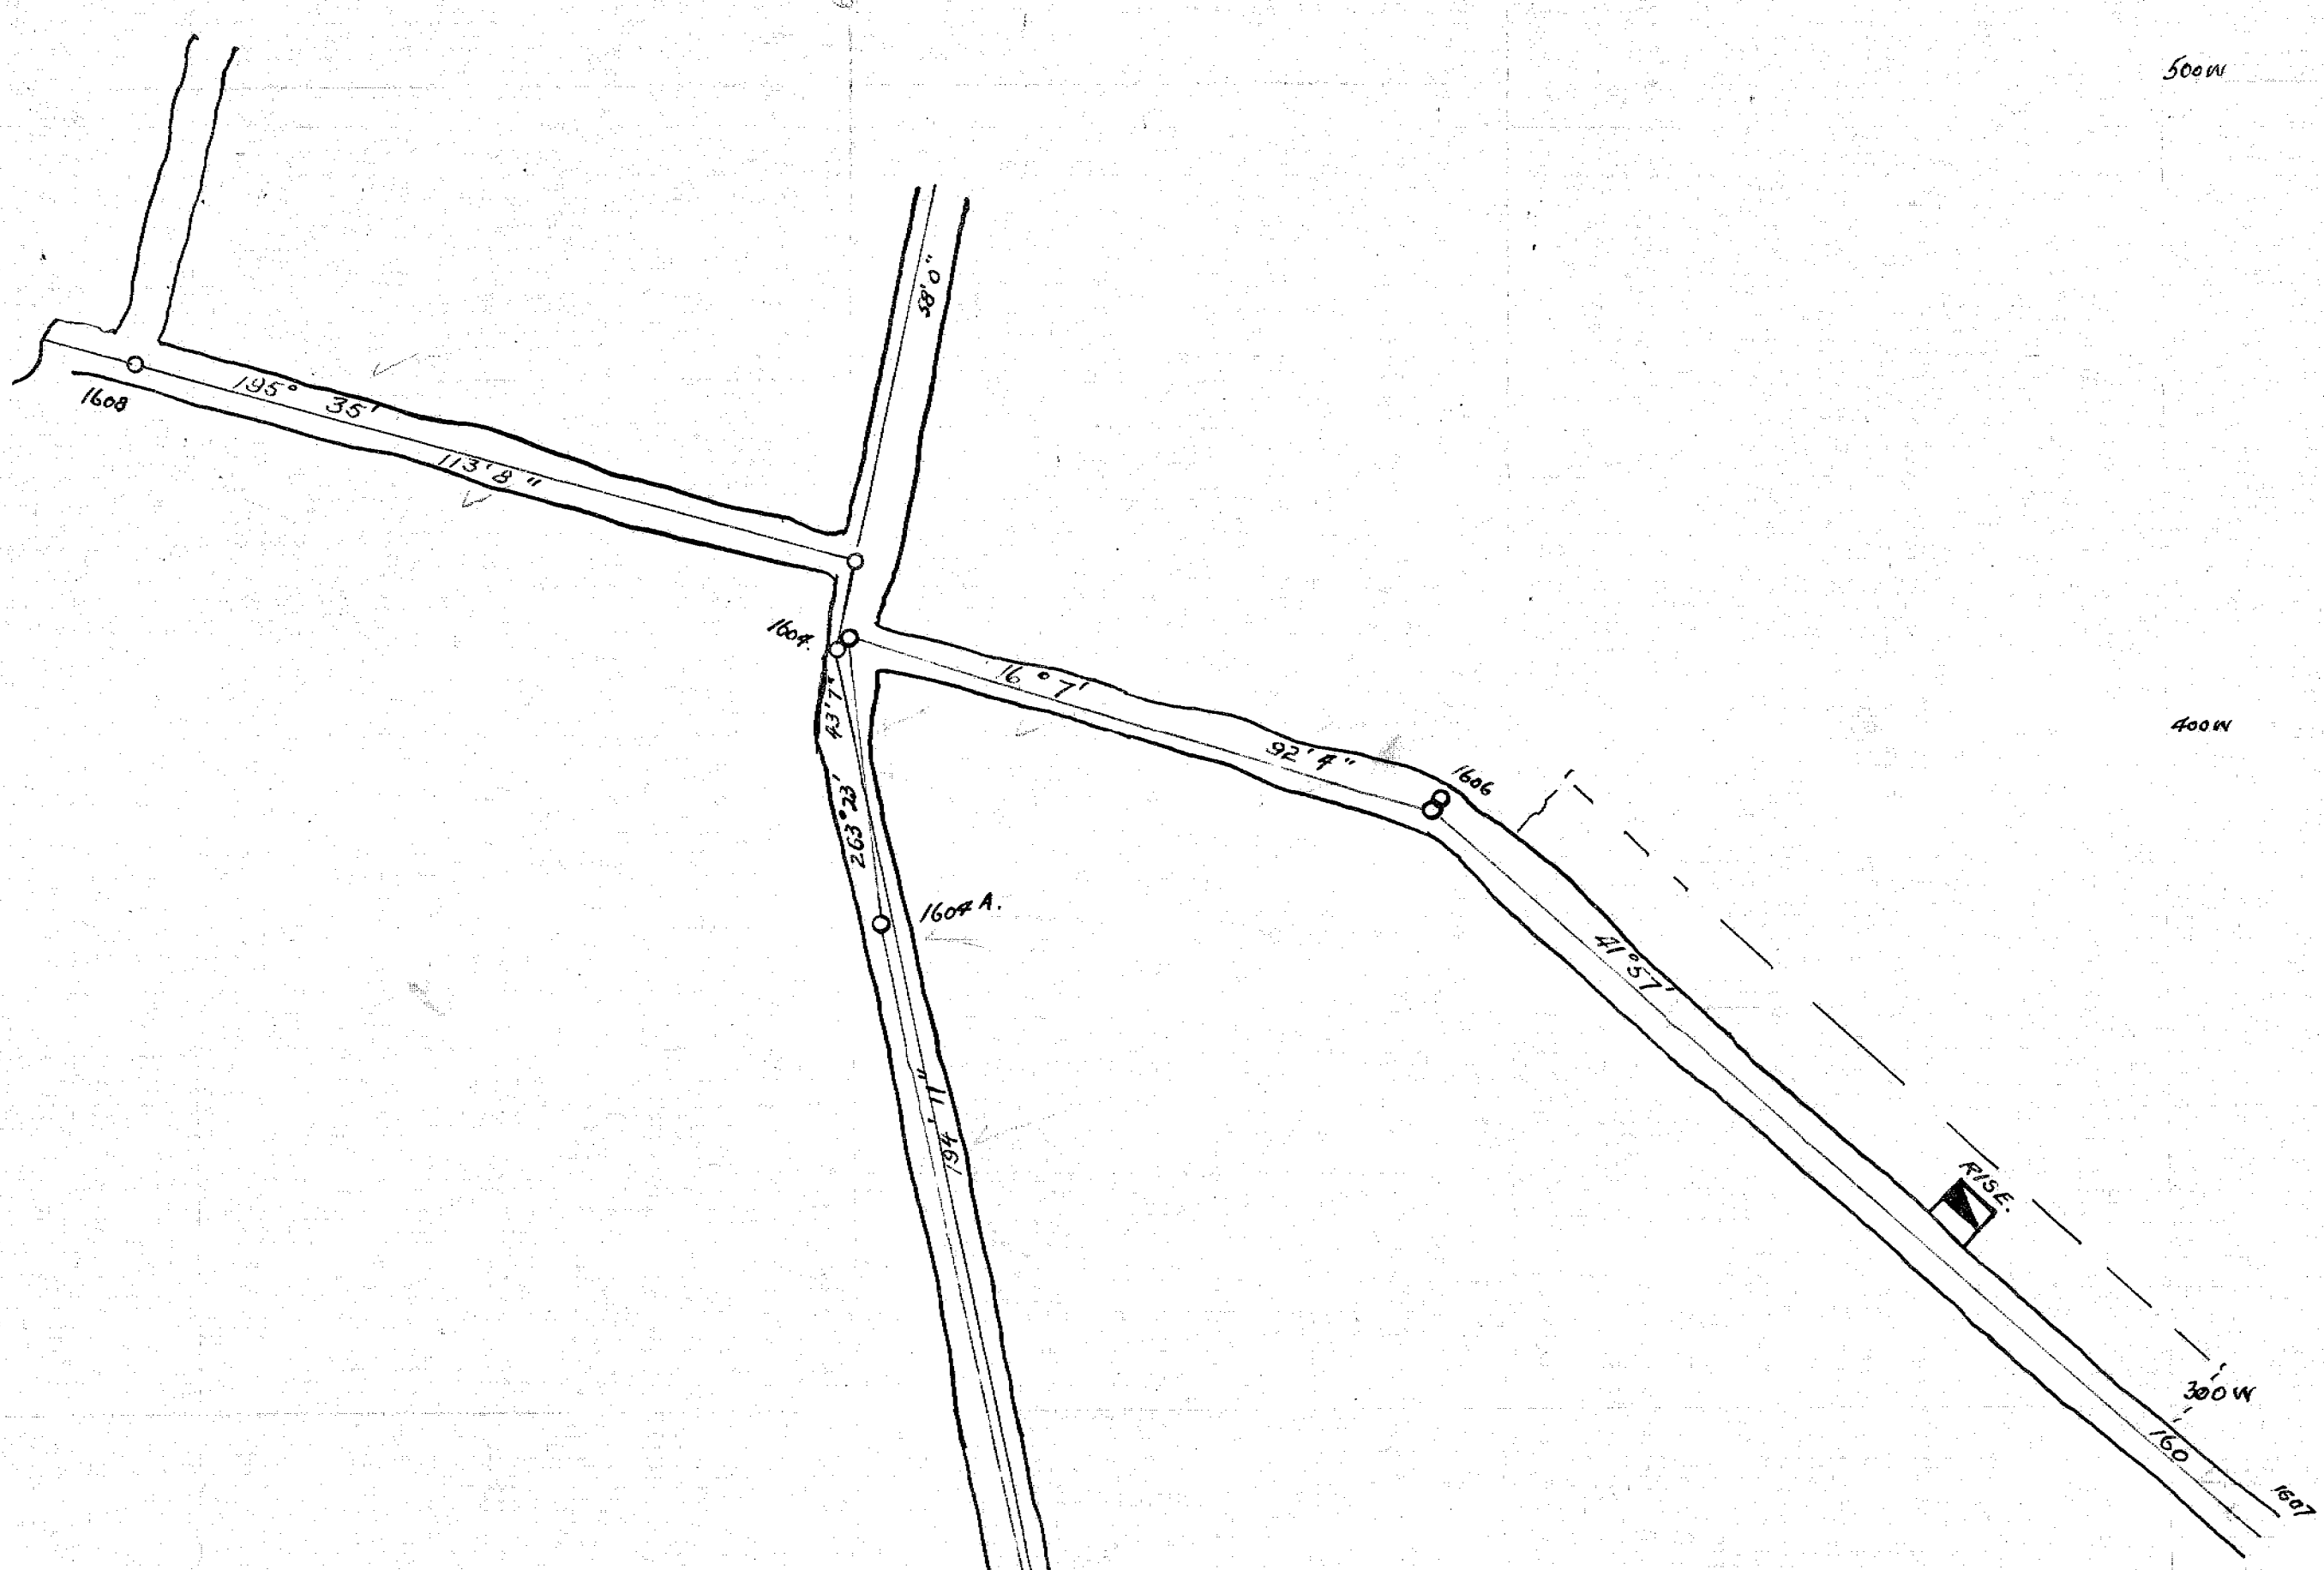

Scale 25' = 1"

No 16 CROSS-CUT

Magnet S M Company
April 20th 1929 H B Schell
Instrument 5 "Stanley" Mine Surveyor
General Manager R & T. Hales

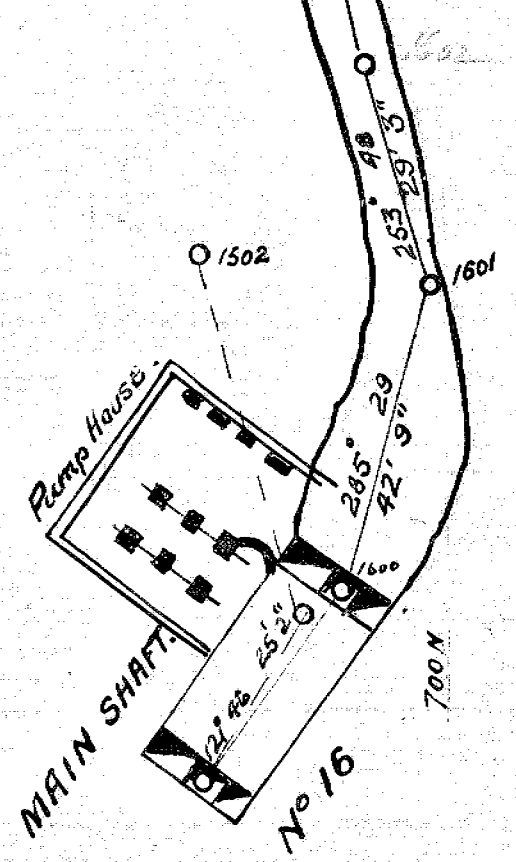

3705
87 M

40-07