


5 cm

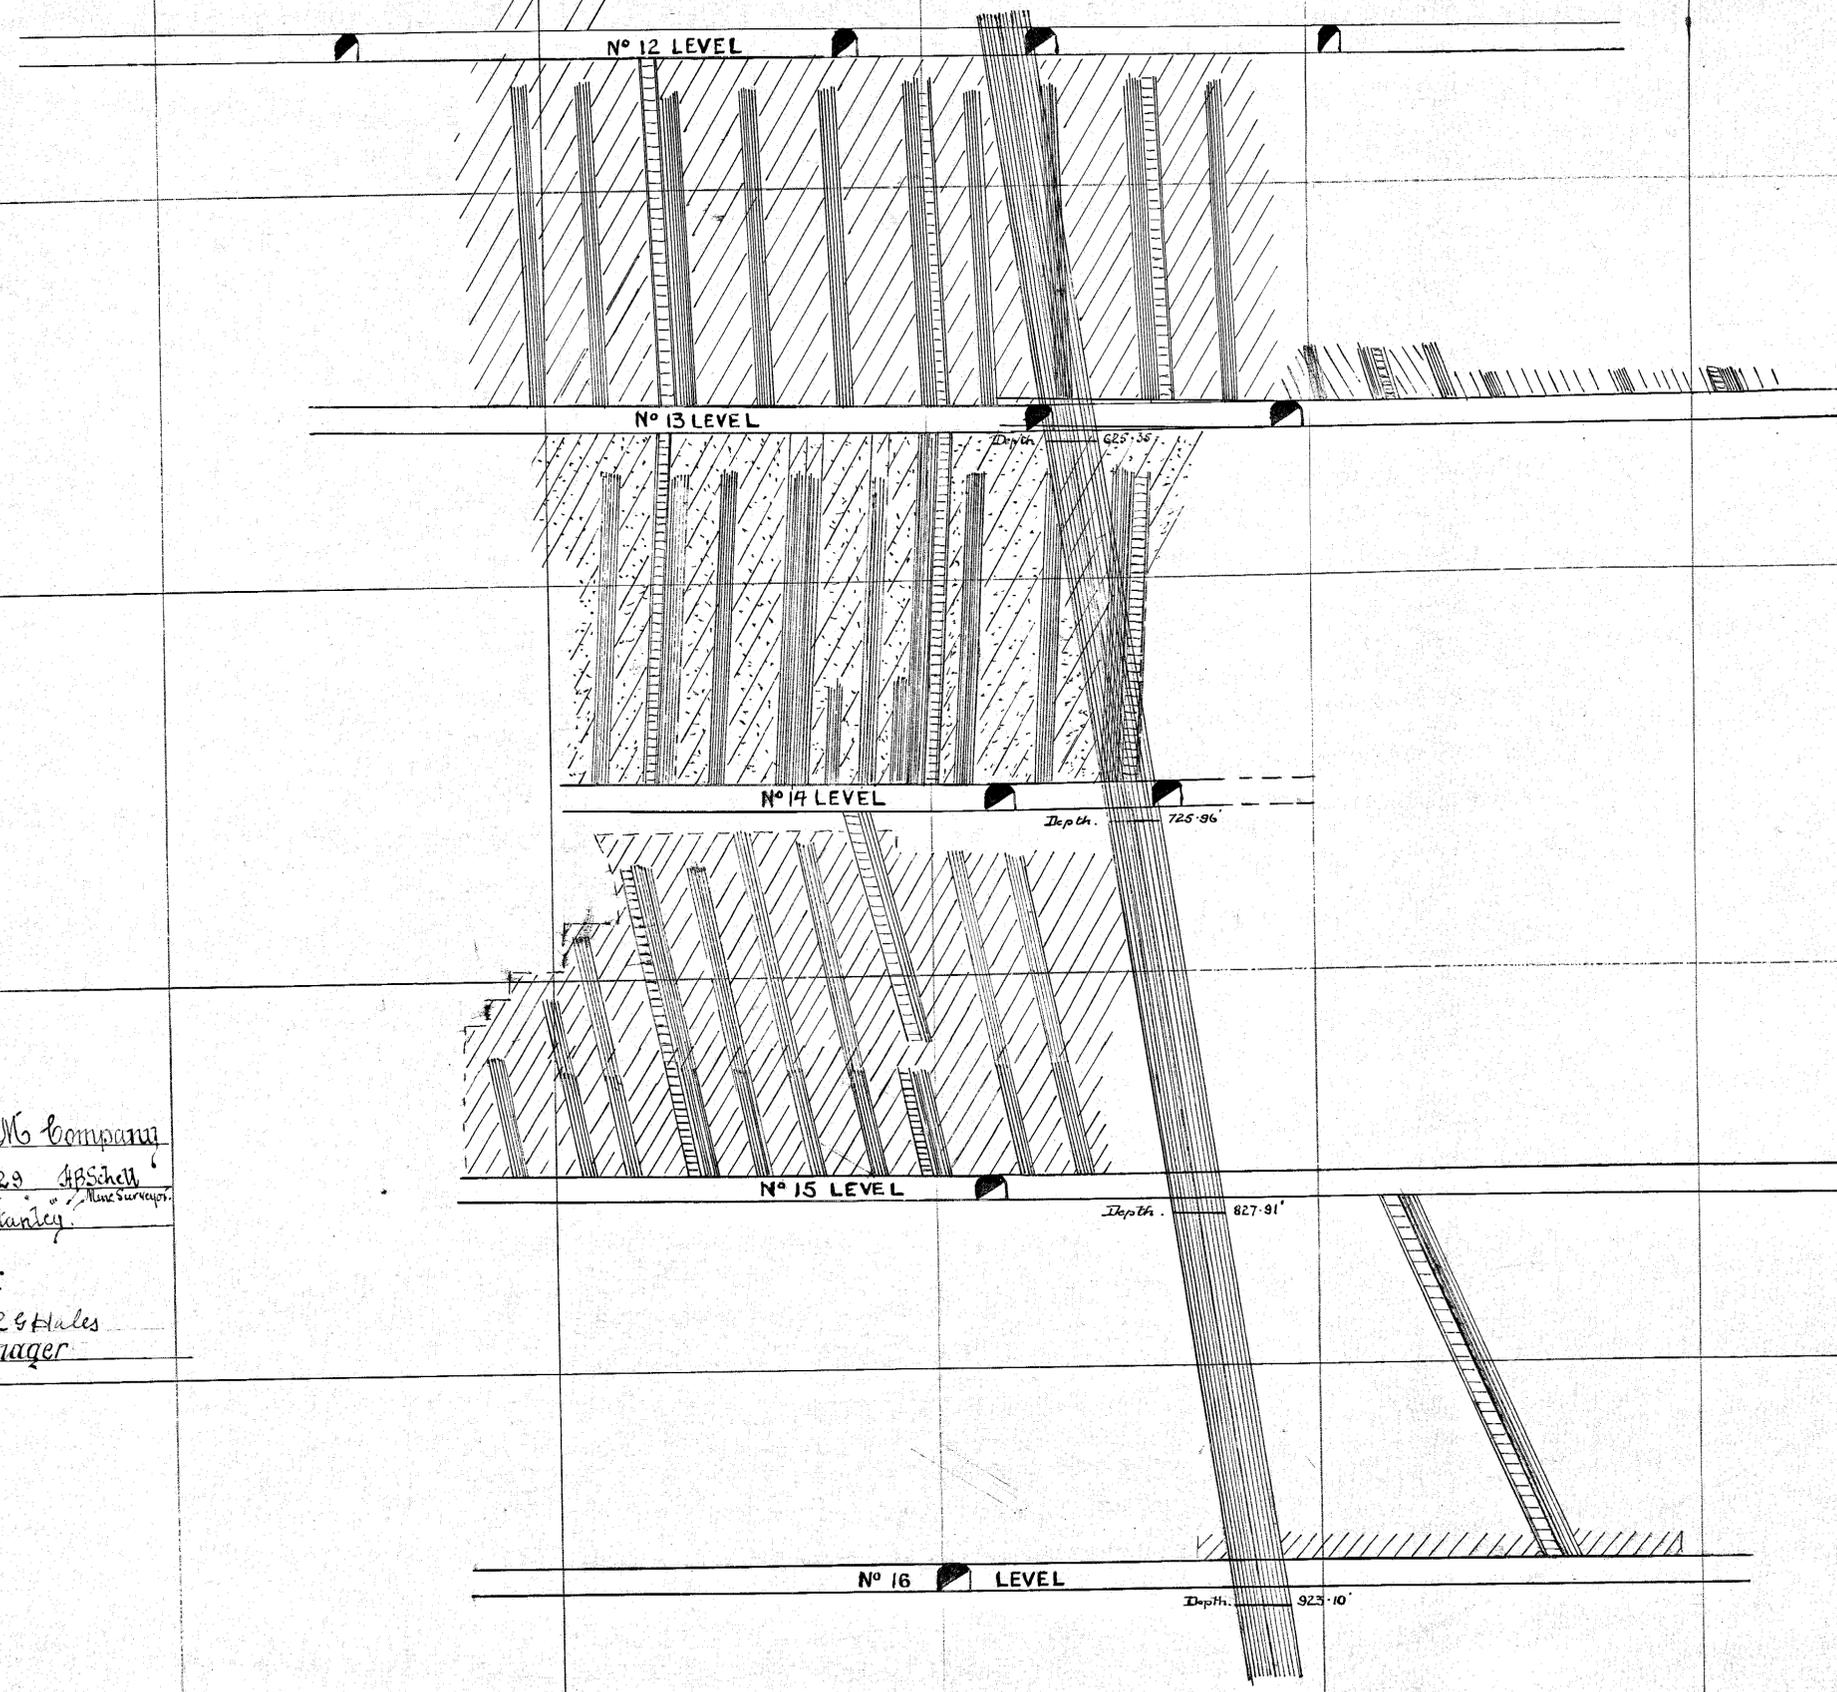

Magnet S M Company
 April 15th to 20th 1920 A.P. Schell
 Instrument 5" Stanley
Section.
 Scale 25' = 1" R & Hales
 General Manager