


MAGNET MINE

REVISED PLAN OF N^o 14 NORTH DRIVE

Scale 25' = 1 inch *BLM Del.*
12/1/31

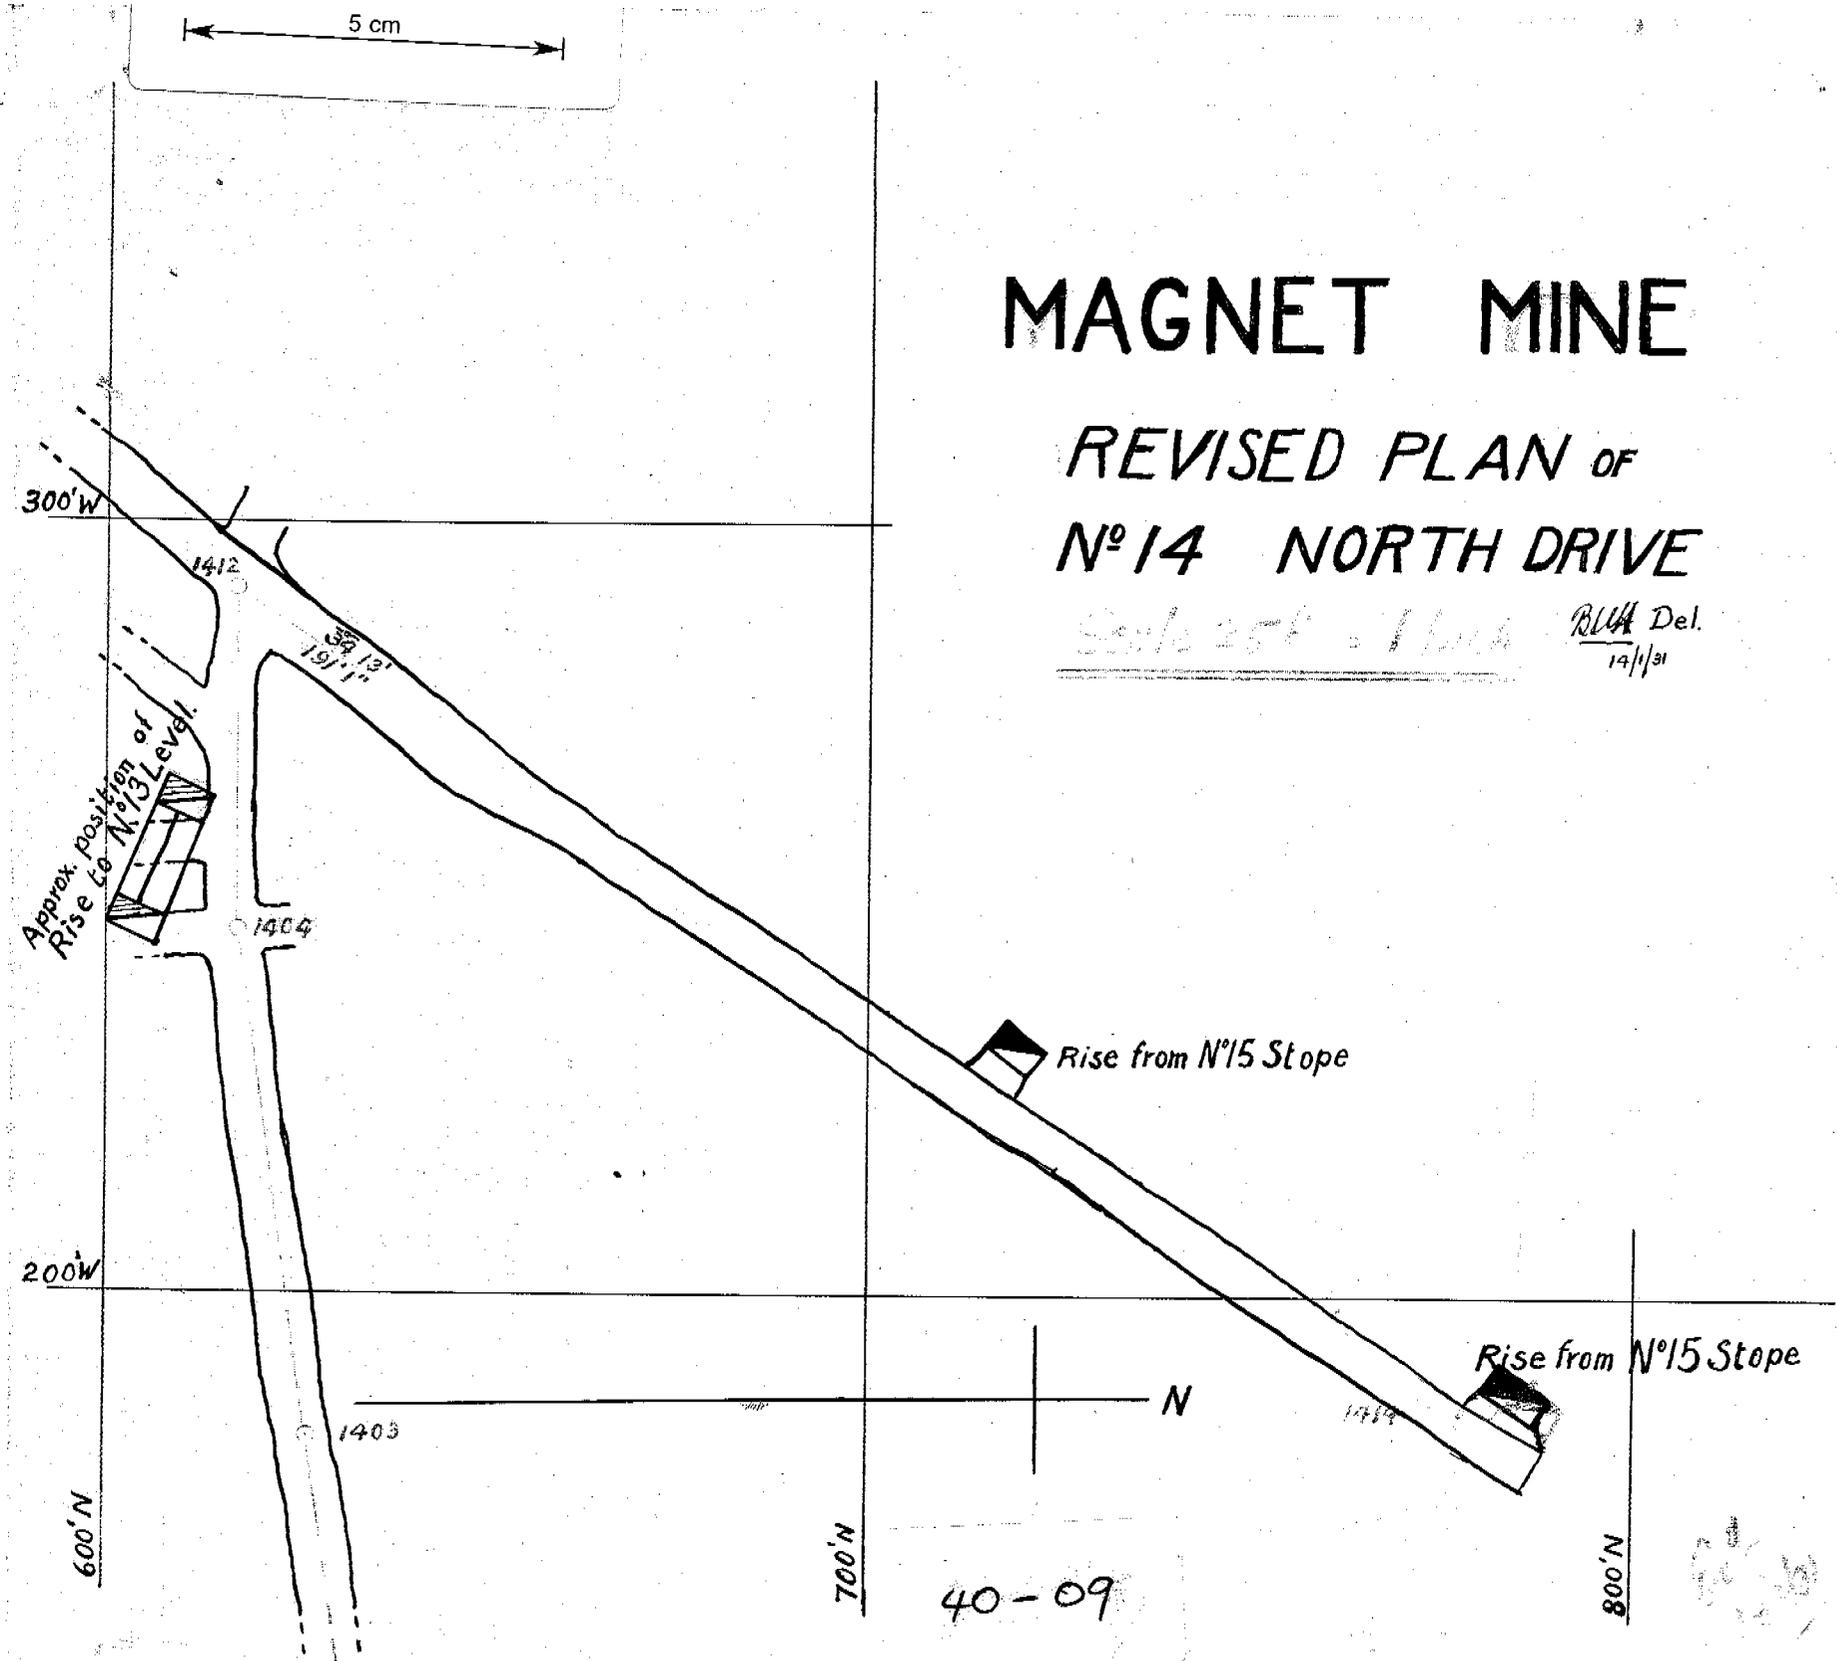

3705
87M
400'N from Southern Boundary of Lease