

5 cm

MAGNET MINE

ELEVATION OF LOWER LEVELS
Ground Stopped during 1930 shown Hatched


R. G. Hales General Manager

B. L. H. Del. 12/1/31

NOTE. The position of the Stopes is shown on the PLAN for 1929. Stopping has been done on the Back-Lode only, from Nos. 13, 14 and 15 Levels.

Scale 25 feet = 1 inch

Note.
The position of this Rise is approximate only

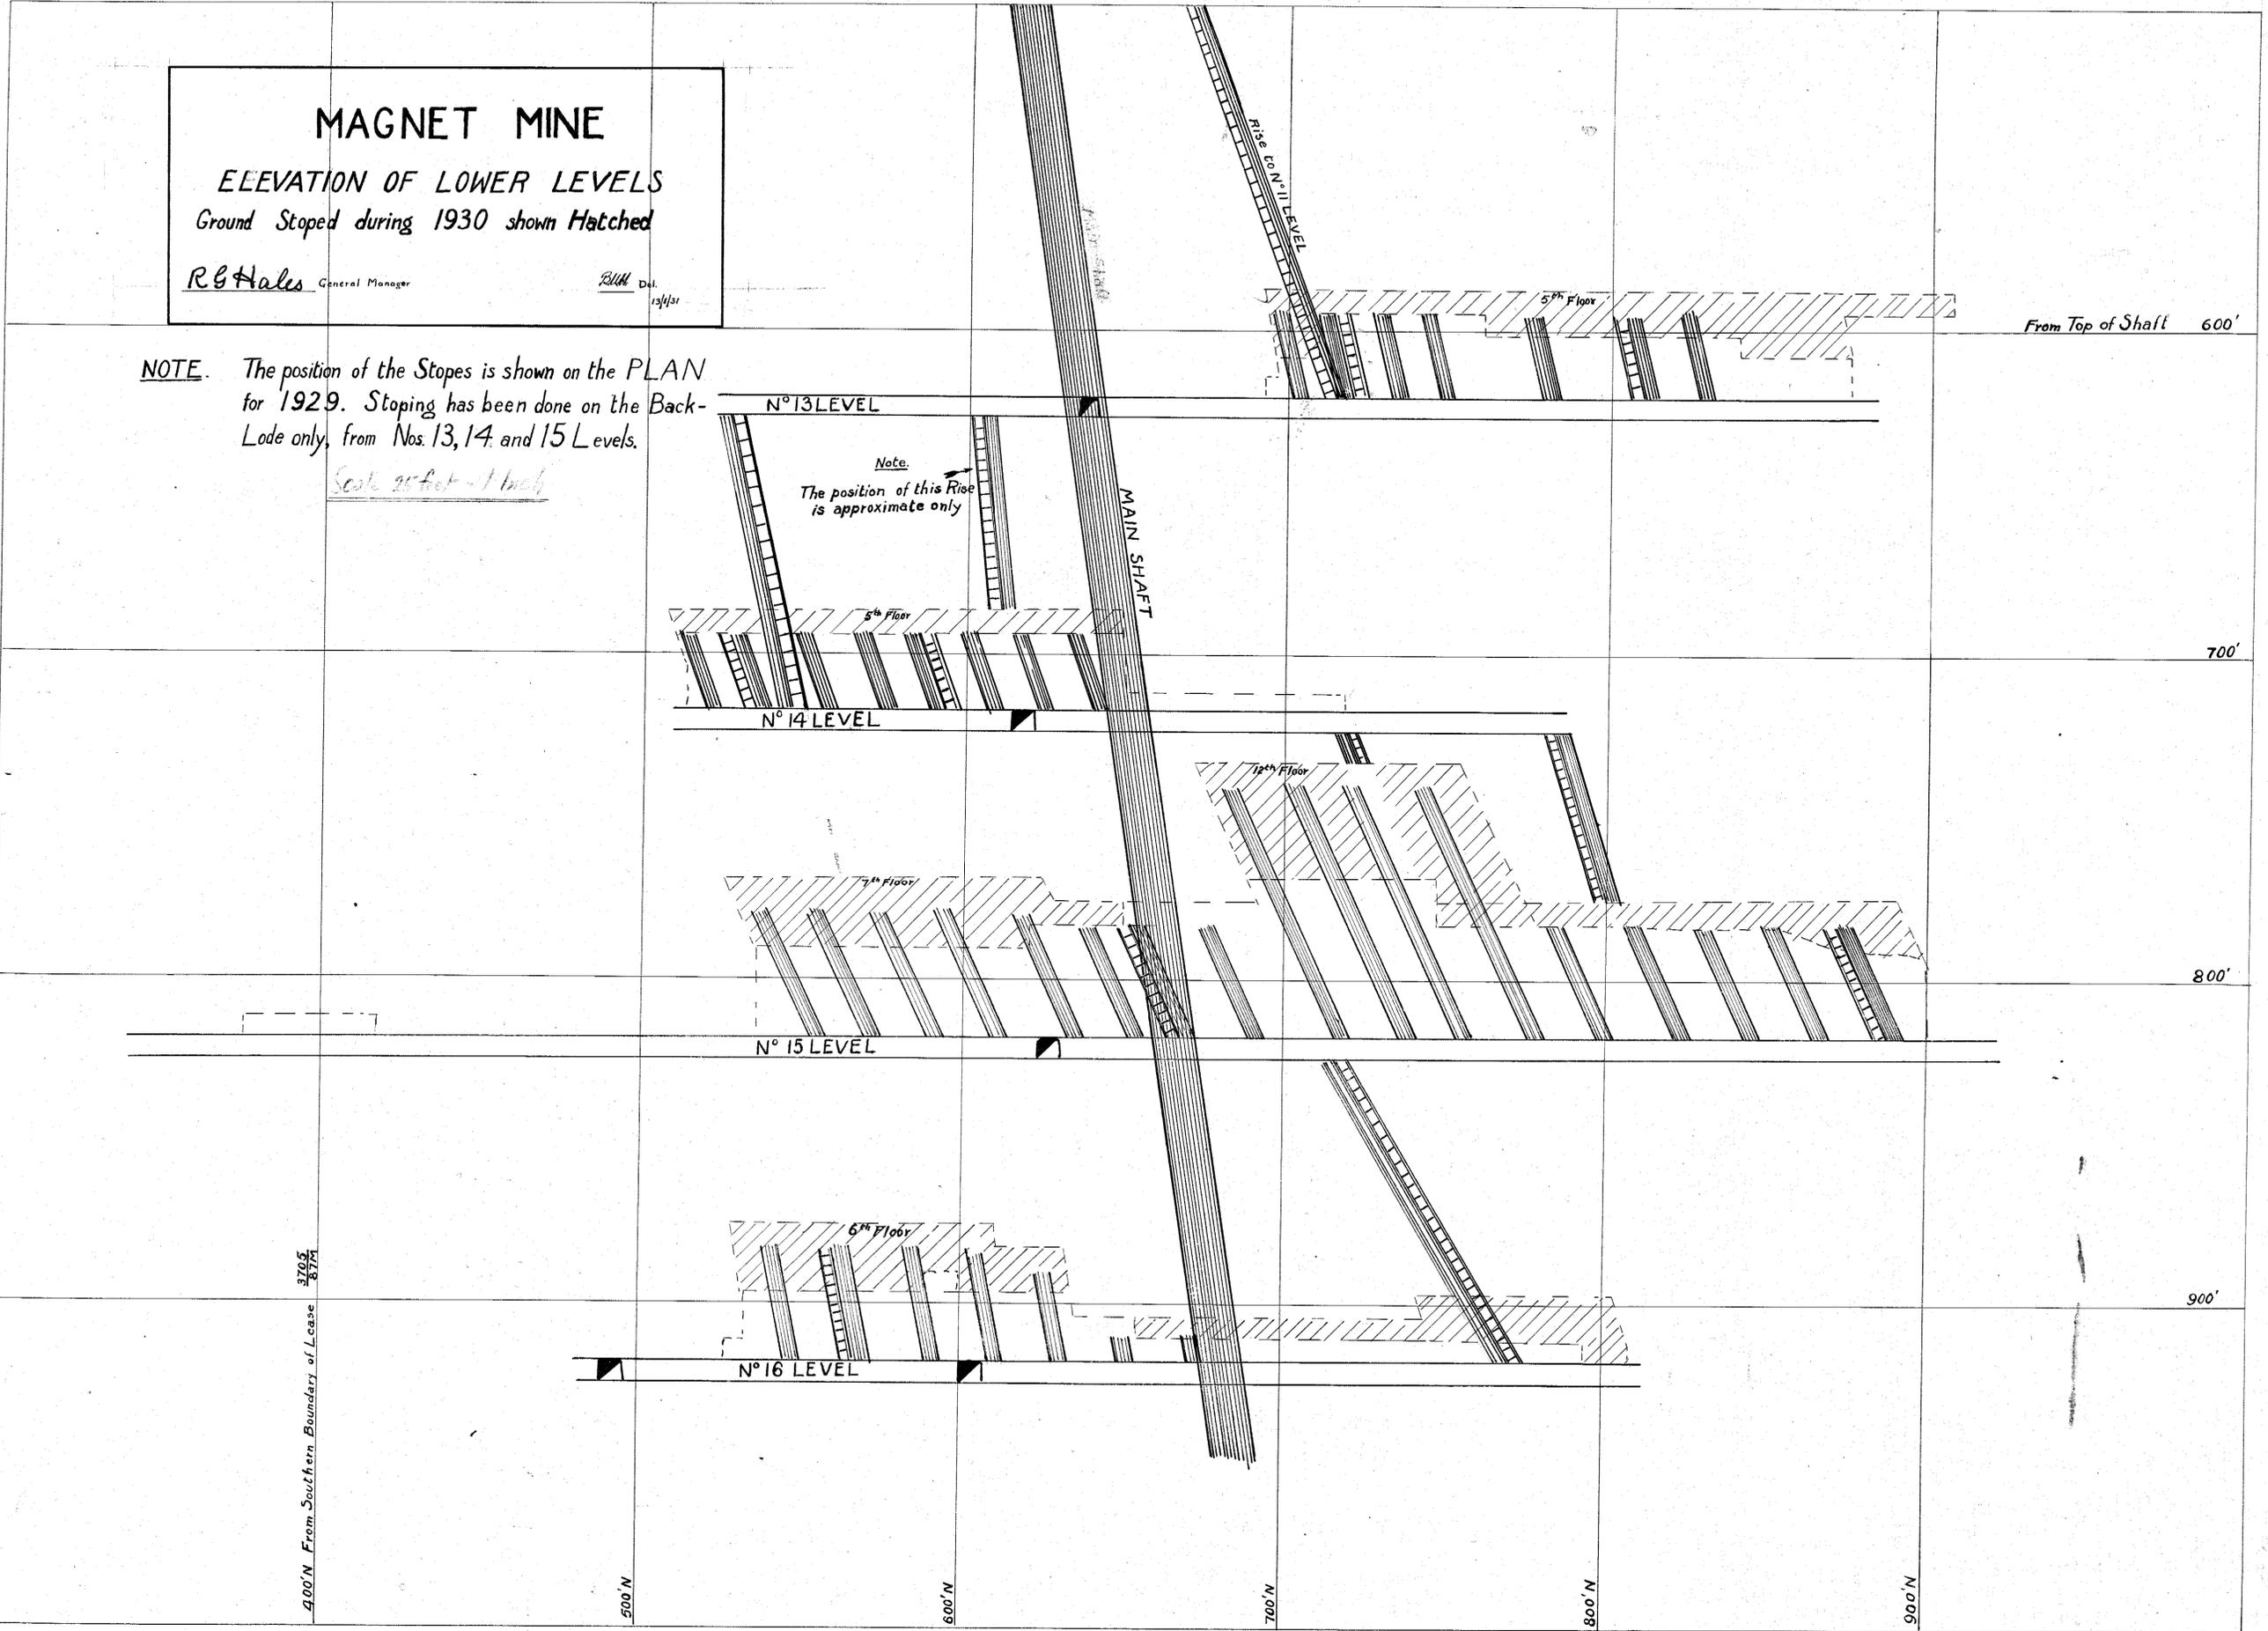

400' N. From Southern Boundary of Lease

500' N

600' N

700' N

800' N

900' N

From Top of Shaft 600'

700'

800'

900'