

5 cm

# MAGNET SILVER MINING C<sup>o</sup>Y N.L.


## LONGITUDINAL SECTION OF WORKINGS

Scale 40 Feet to 1 Inch

NOTE:- Section taken along North and South Section Lines  
Main Lode Stopes shown thus   
Western Branch Stopes shown thus   
East Lode Stopes shown thus   
FOR YEAR ENDED DECEMBER 1926

GENERAL MANAGER  
*H. J. ...*

MINE SURVEYOR  
*Edgar ...*

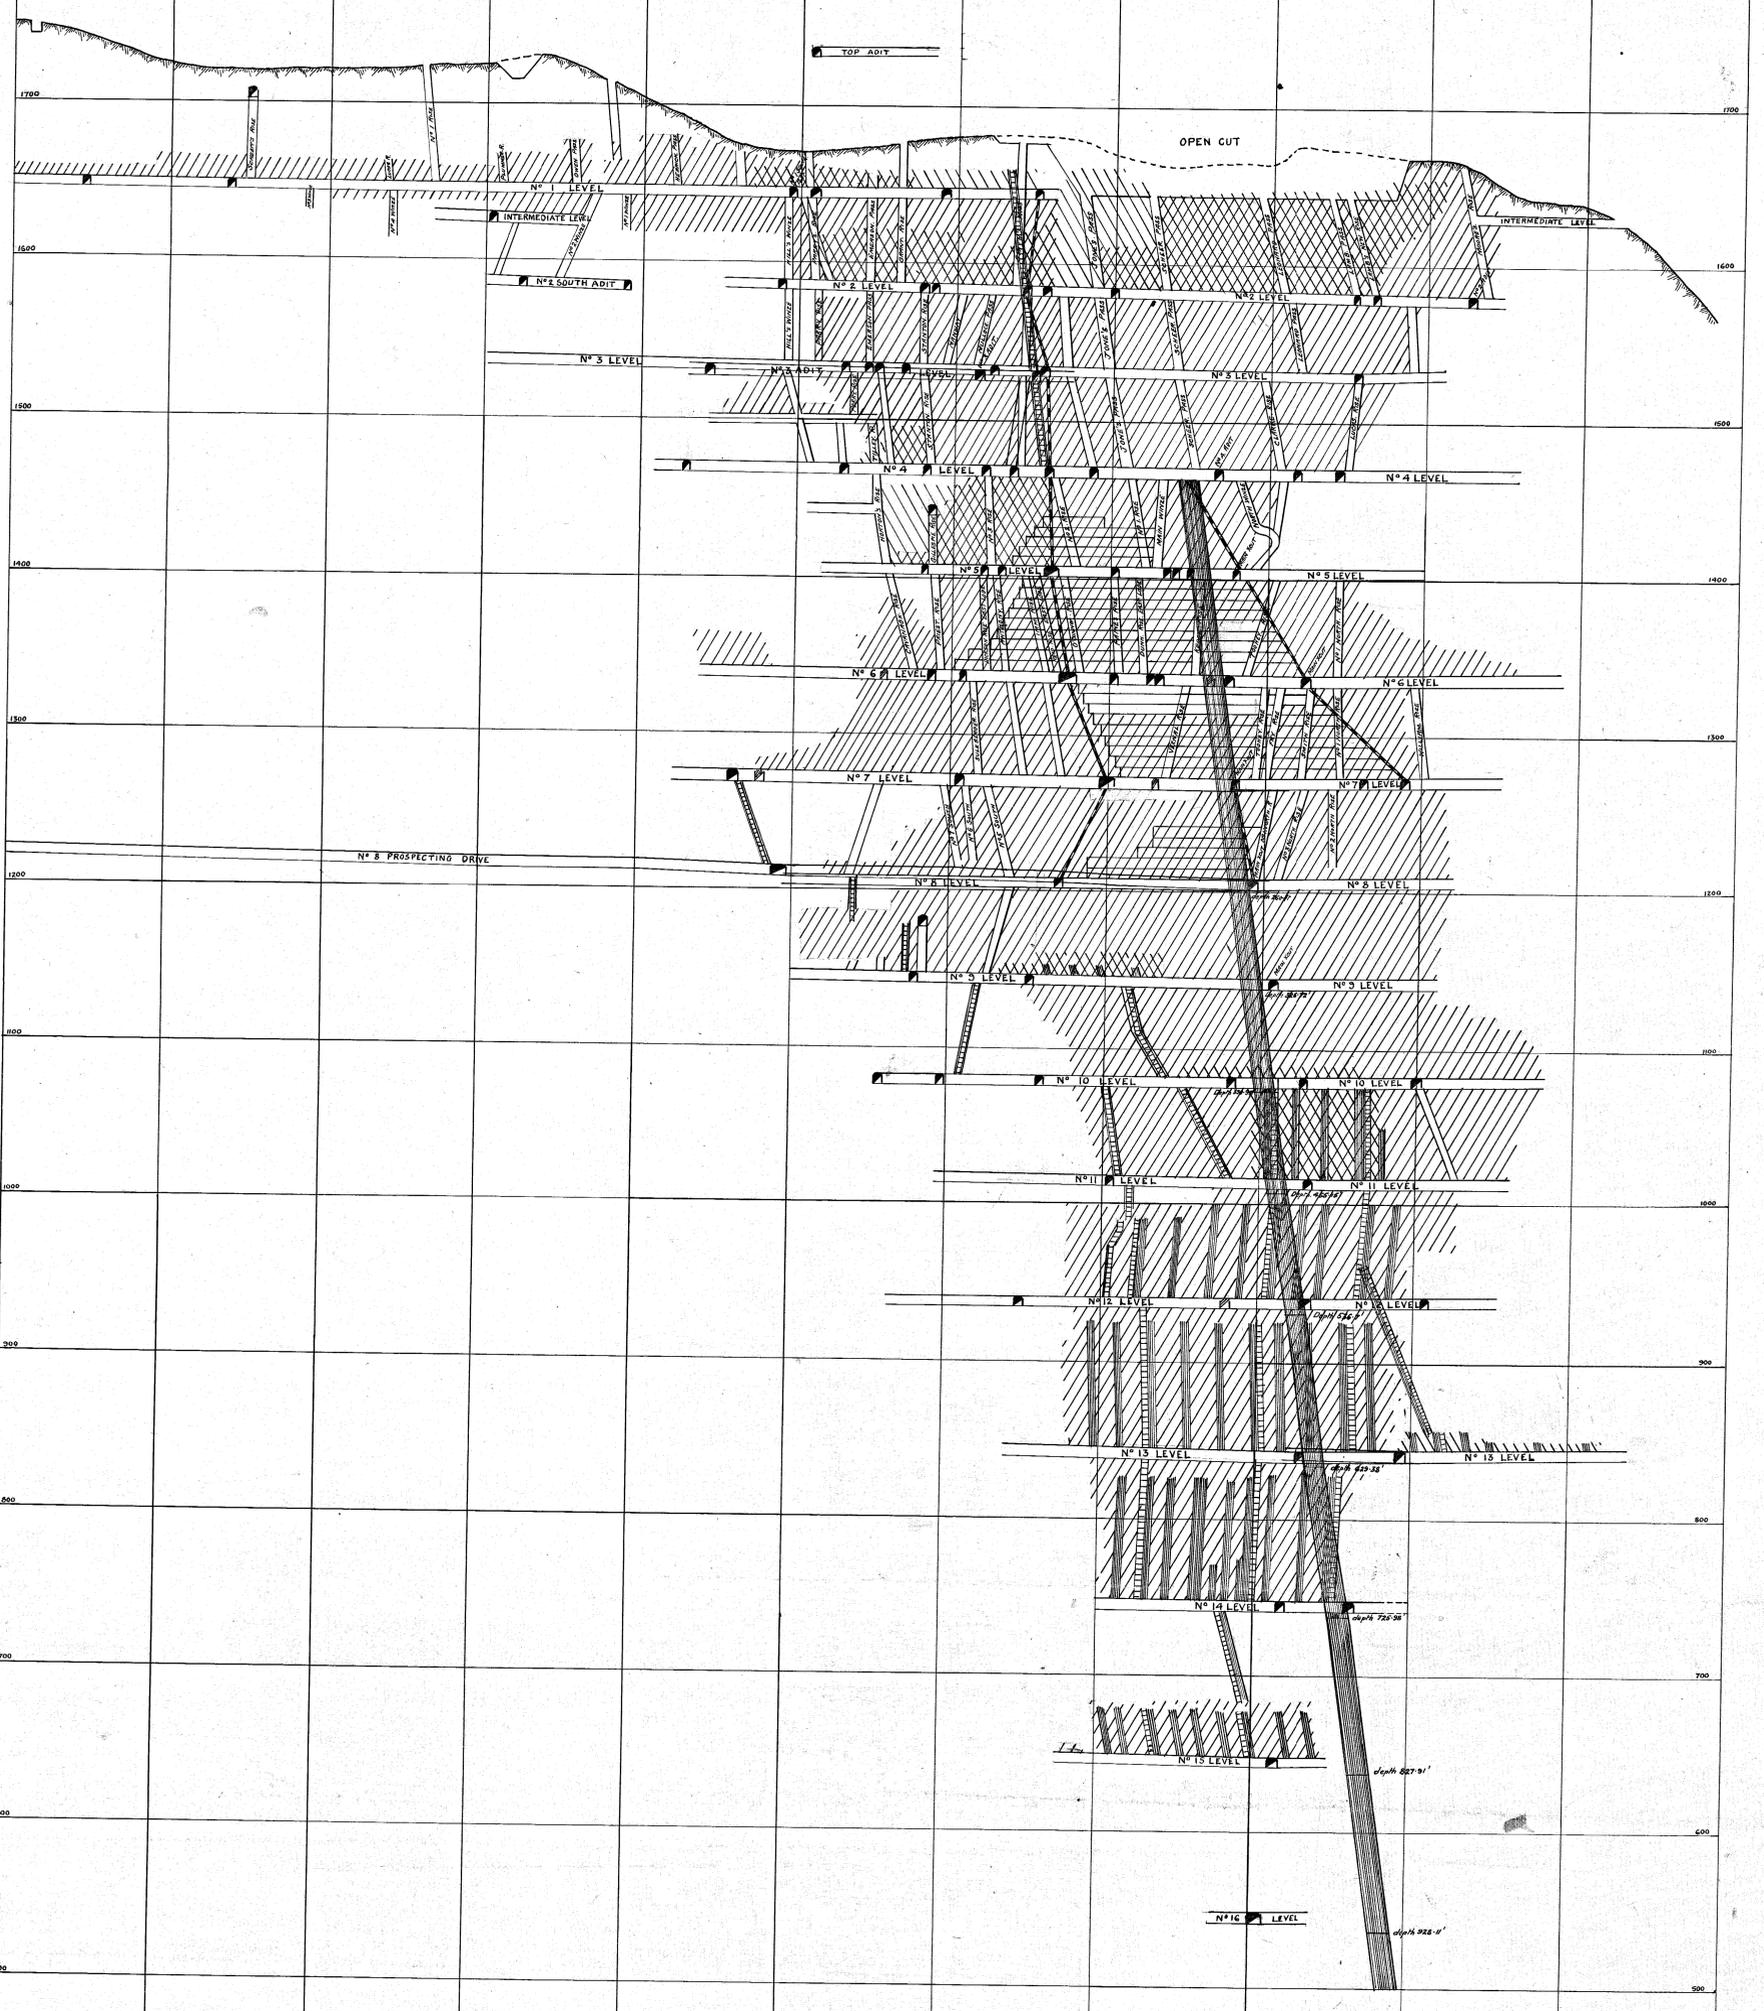

RC